


THREE CABLE GUARD RAIL W/STEEL POSTS
 Left 753+00 to 758+00 Right 758+00 to 758+00

PROPERTY LINE FENCE W/STEEL POSTS
 Left 744+00 to 758+00 Right 744+00 to 758+00

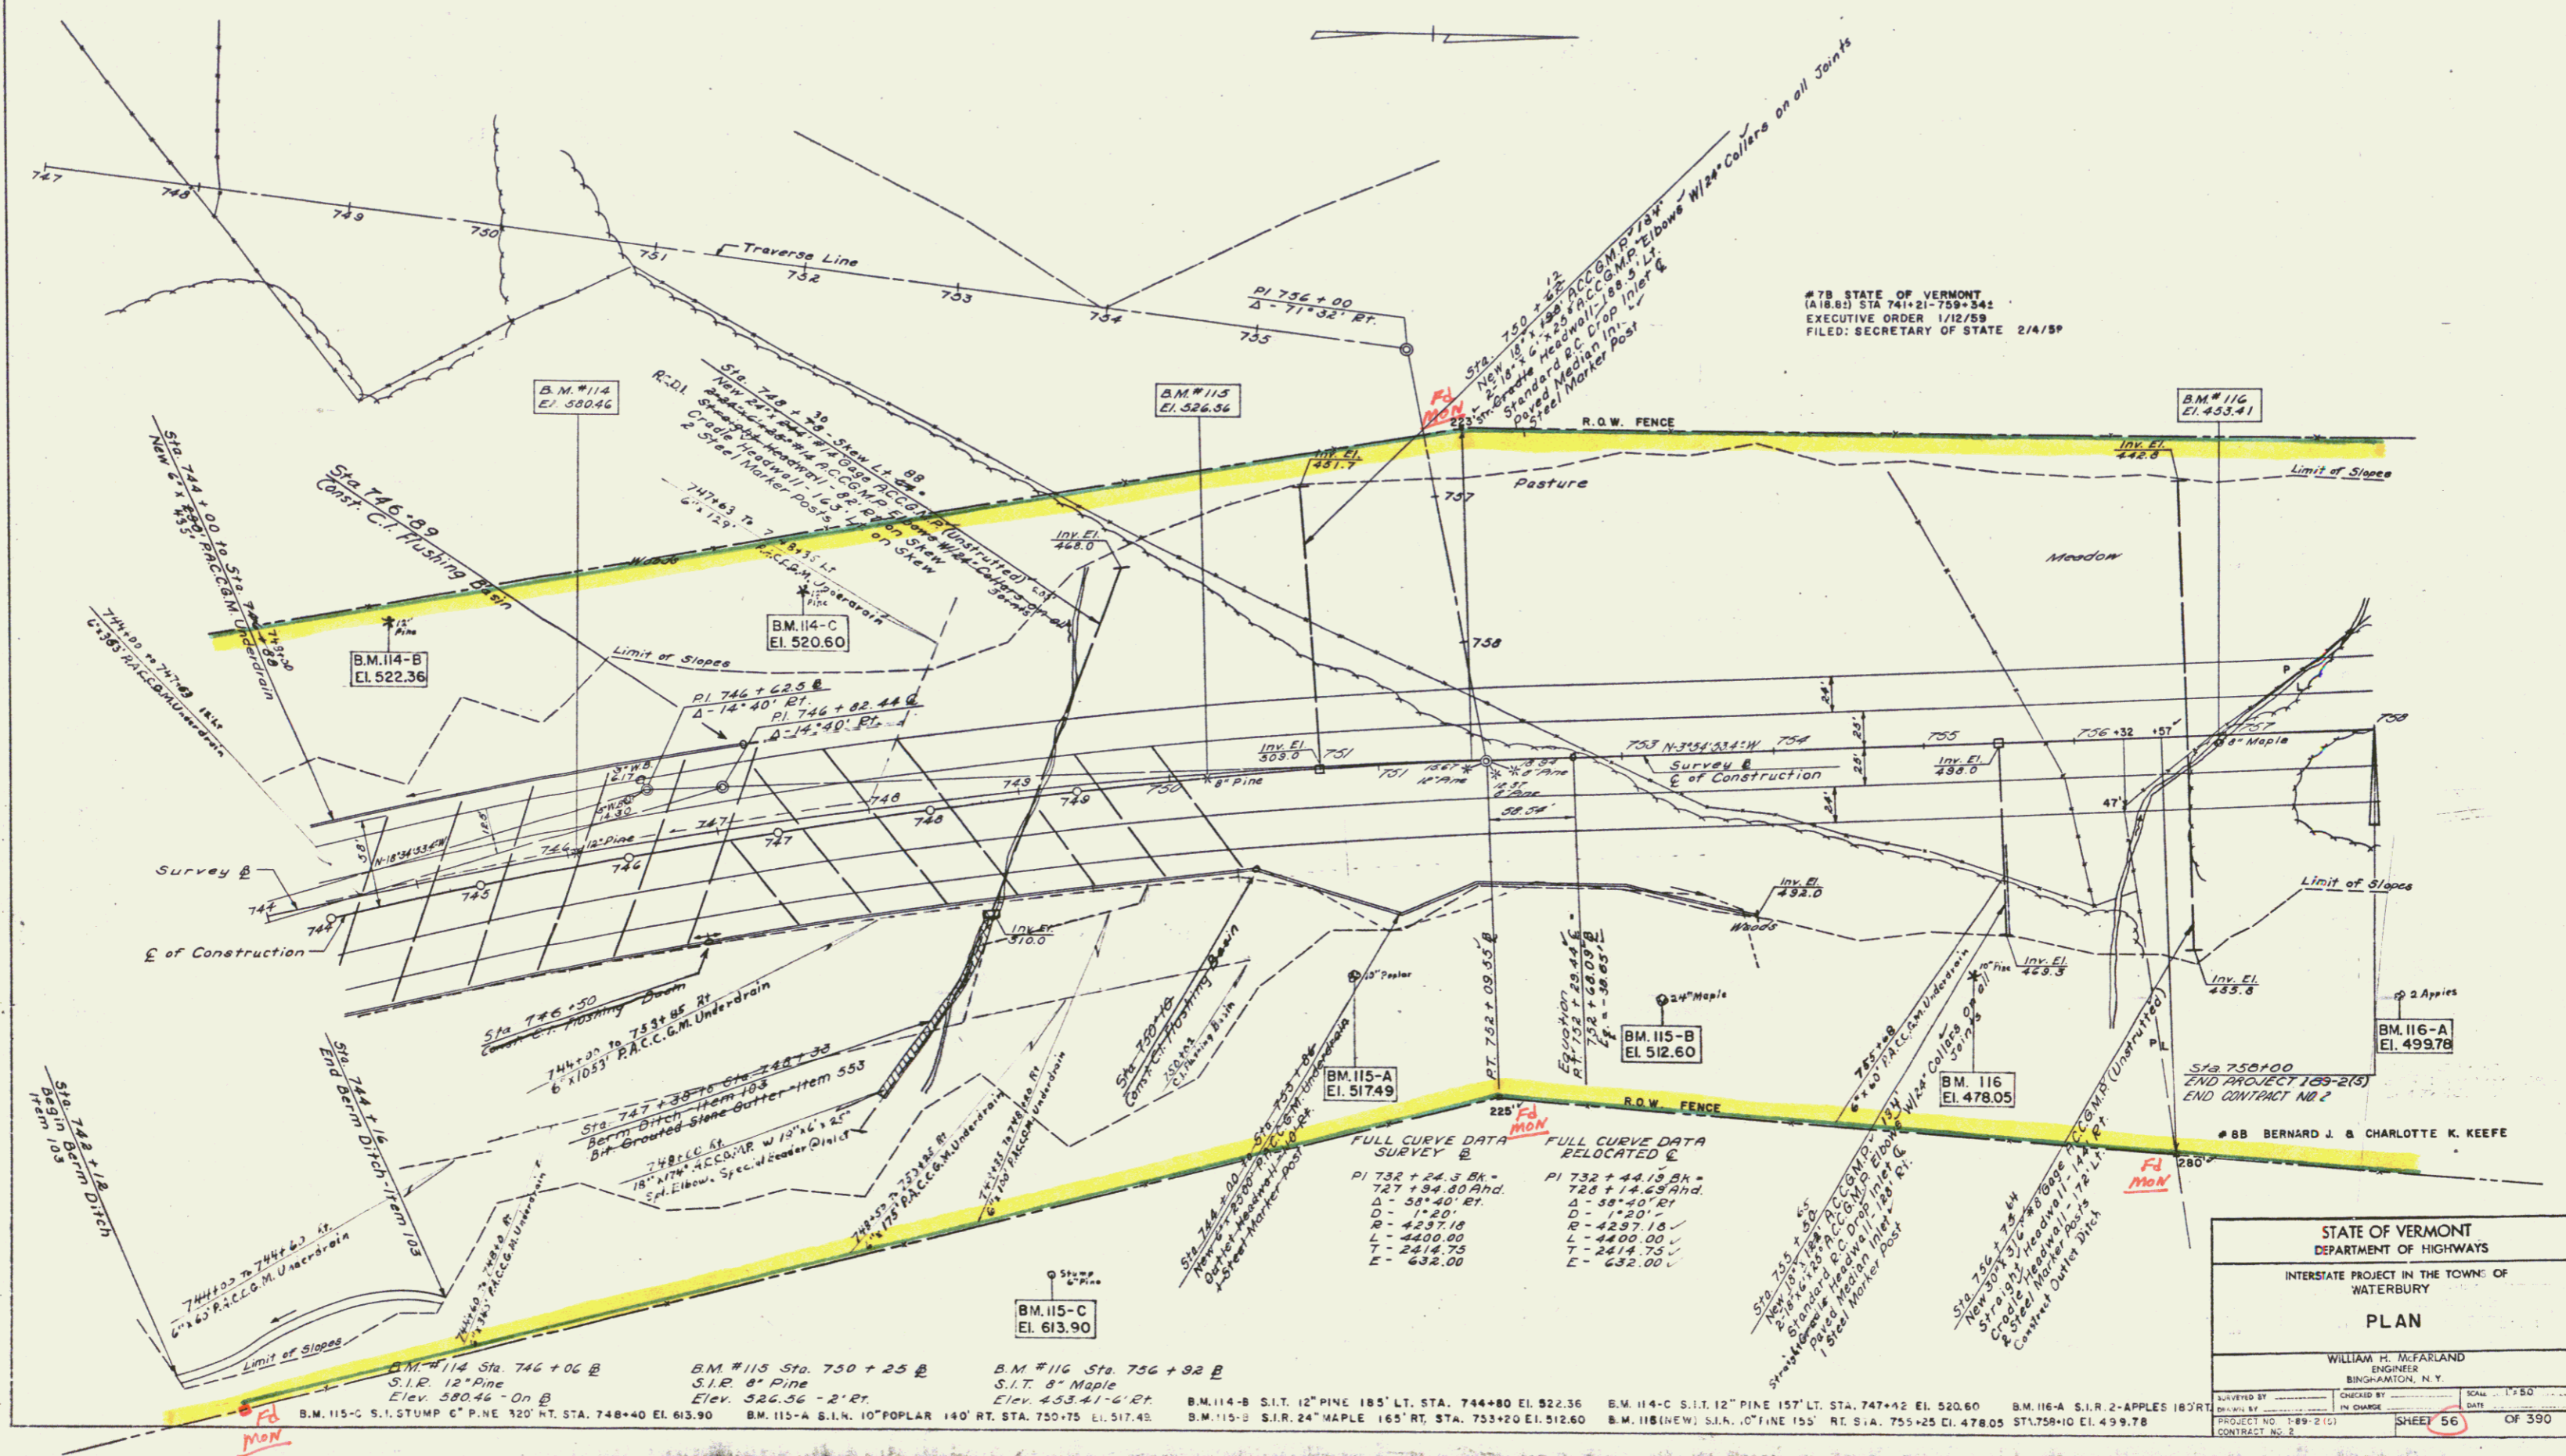

#78 STATE OF VERMONT
 (A18.B) STA 741+21-759+342
 EXECUTIVE ORDER 1/12/59
 FILED: SECRETARY OF STATE 2/4/59

FULL CURVE DATA SURVEY B		FULL CURVE DATA RELOCATED C	
PI 732 + 24.3 Bk -	727 + 34.80 Ahd.	PI 732 + 44.18 Bk -	723 + 14.63 Ahd.
Δ - 58° 40' RT	D - 1120'	Δ - 58° 40' RT	D - 1120'
L - 4400.00	T - 2414.75	L - 4237.16	T - 2414.75
E - 632.00		E - 632.00	

STATE OF VERMONT DEPARTMENT OF HIGHWAYS	
INTERSTATE PROJECT IN THE TOWN OF WATERBURY	
PLAN	
WILLIAM H. McFARLAND ENGINEER BINGHAMTON, N. Y.	
DESIGNED BY	CHECKED BY
PROJECT NO. 189-2(1)	DATE
CONTRACT NO. 2	SHEET 56 OF 390

B.M. #114 Sta. 746 + 06 @ S.I.R. 12" PINE Elev. 522.36 On B
 B.M. #115 Sta. 750 + 25 @ S.I.R. 8" PINE Elev. 526.56 - 2' RT
 B.M. #116 Sta. 756 + 92 @ S.I.T. 8" MAPLE Elev. 453.41 - 6' RT
 B.M. #114-B EL. 522.36
 B.M. #114-C EL. 520.60
 B.M. #115-A EL. 517.49
 B.M. #115-B EL. 512.60
 B.M. #115-C EL. 613.90
 B.M. #116-A EL. 499.78
 B.M. #116-B EL. 478.05
 B.M. #116-C EL. 520.60
 B.M. #116-A S.I.R. 2" APPLES 18" RT STA. 744+80 EL. 522.36
 B.M. #114-C S.I.T. 12" PINE 185' LT. STA. 747+42 EL. 520.60
 B.M. #115-B S.I.R. 24" MAPLE 165' RT. STA. 753+20 EL. 512.60
 B.M. #116(A) S.I.R. 10" PINE 155' RT. S.A. 755+25 EL. 478.05 STA. 758+10 EL. 499.78