


CURVE DATA
 RELOC. BTE #100
 PI 21+30.00 BA -
 Δ 23°10' 00"
 D 37.50'
 R 1041.74'
 T 232.34'
 L 457.58'
 E 23.64'

DEMOLITION AND REMOVAL
 OF BLDG ITEM 585
 STA. 787+00 LT. NO. 11

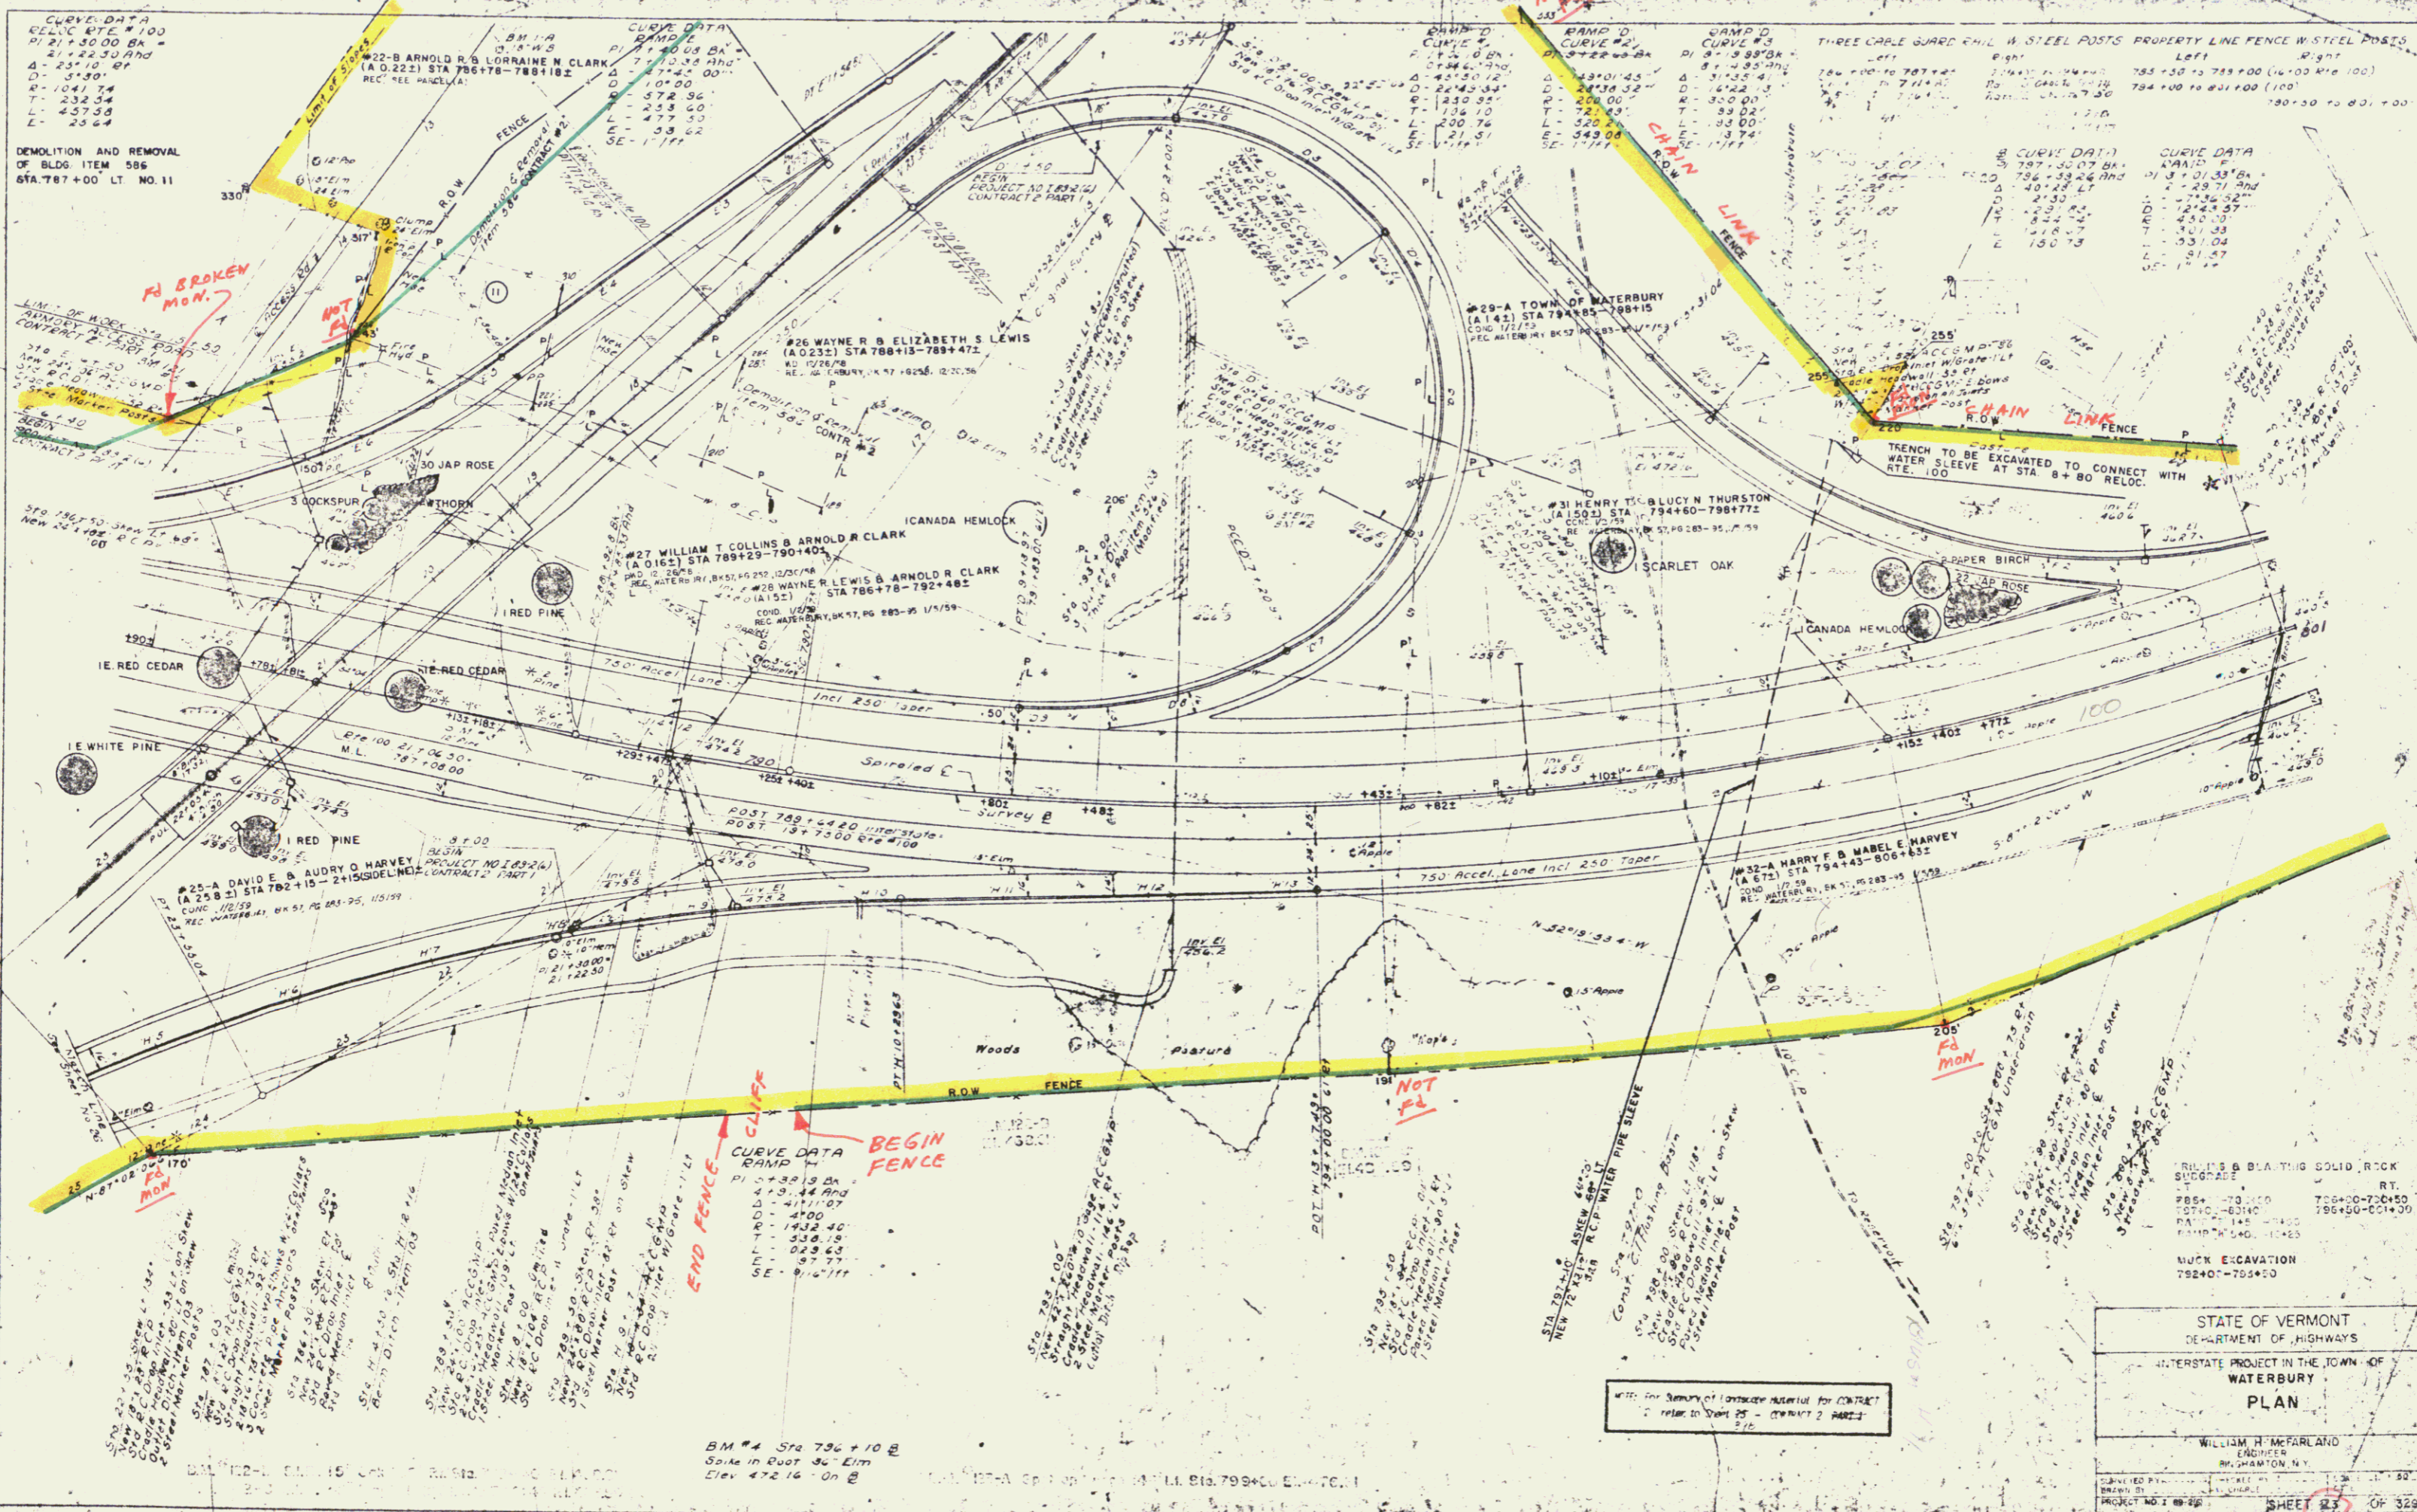

CURVE DATA
 RAMP
 PI 13+39.19 BA
 Δ 43°31' 00"
 D 411.07'
 R 470'
 T 148.40'
 L 338.18'
 E 0.948'
 SE 91°11'

SEE THE SUMMARY OF CONTRACT MATERIALS FOR CONTRACT
 1. REFER TO SHEET 25 - CONTRACT 2. PARCEL
 2.

STATE OF VERMONT DEPARTMENT OF HIGHWAYS	
INTERSTATE PROJECT IN THE TOWN OF WATERBURY PLAN	
WILLIAM H. McFARLAND ENGINEER BURLINGTON, V.T.	
PROJECT NO. 18-59	SHEET 25 OF 329