

SPIRAL CURVE DATA

PI 787.130.07	DI 787.130.07
780.158.10	708.158.28
802.280.00	802.280.00
824.400.00	824.400.00
846.520.00	846.520.00
3700.000.00	3700.000.00

DEM. & REN. OF BUILDINGS
903+00 LT.

DRILLING & BLASTING SOLID ROCK
SUBGRADE
LT 801+00-804+00 RT 801+00-804+50


#32-A HARRY F. & MABEL E. HARVEY
B.M. #5 Sta. 801+42
B.M. #4 Sta. 805+67
B.M. #123-B S.I.R. 42' Elm 155' Rt. Sta. 803+40 El. 491.02
B.M. #124-A S.I.R. 36' Elm 140' Rt. Sta. 806+00 El. 455.73
B.M. #124-B C.I. Ring Manhole 230' Lt. Sta. 804+90 El. 428.24

#6-B VILLAGE OF WATERBURY
(A 02852) STA 803+07-806+68
REC. SEE # 6A

#33 ROSA J. CULVER
(A 02321) STA 801+93-804+60
W.D. 1/5/59
REC. WATERBURY BK. 57 PG. 274 1/7/59

#57 OLIVE LAWRENCE
(SQ. FT. 10002) STA. 805+90-806+63
C.I. Ring W.D. 8/27/59
Manhole REC. WATERBURY BK. 57 PG. 475 8/31/59

#32-B HARRY F. HARVEY
(A 02852) STA 803+25-810+52
COND. 1/8/59
REC. WATERBURY BK. 57 PG. 285-95

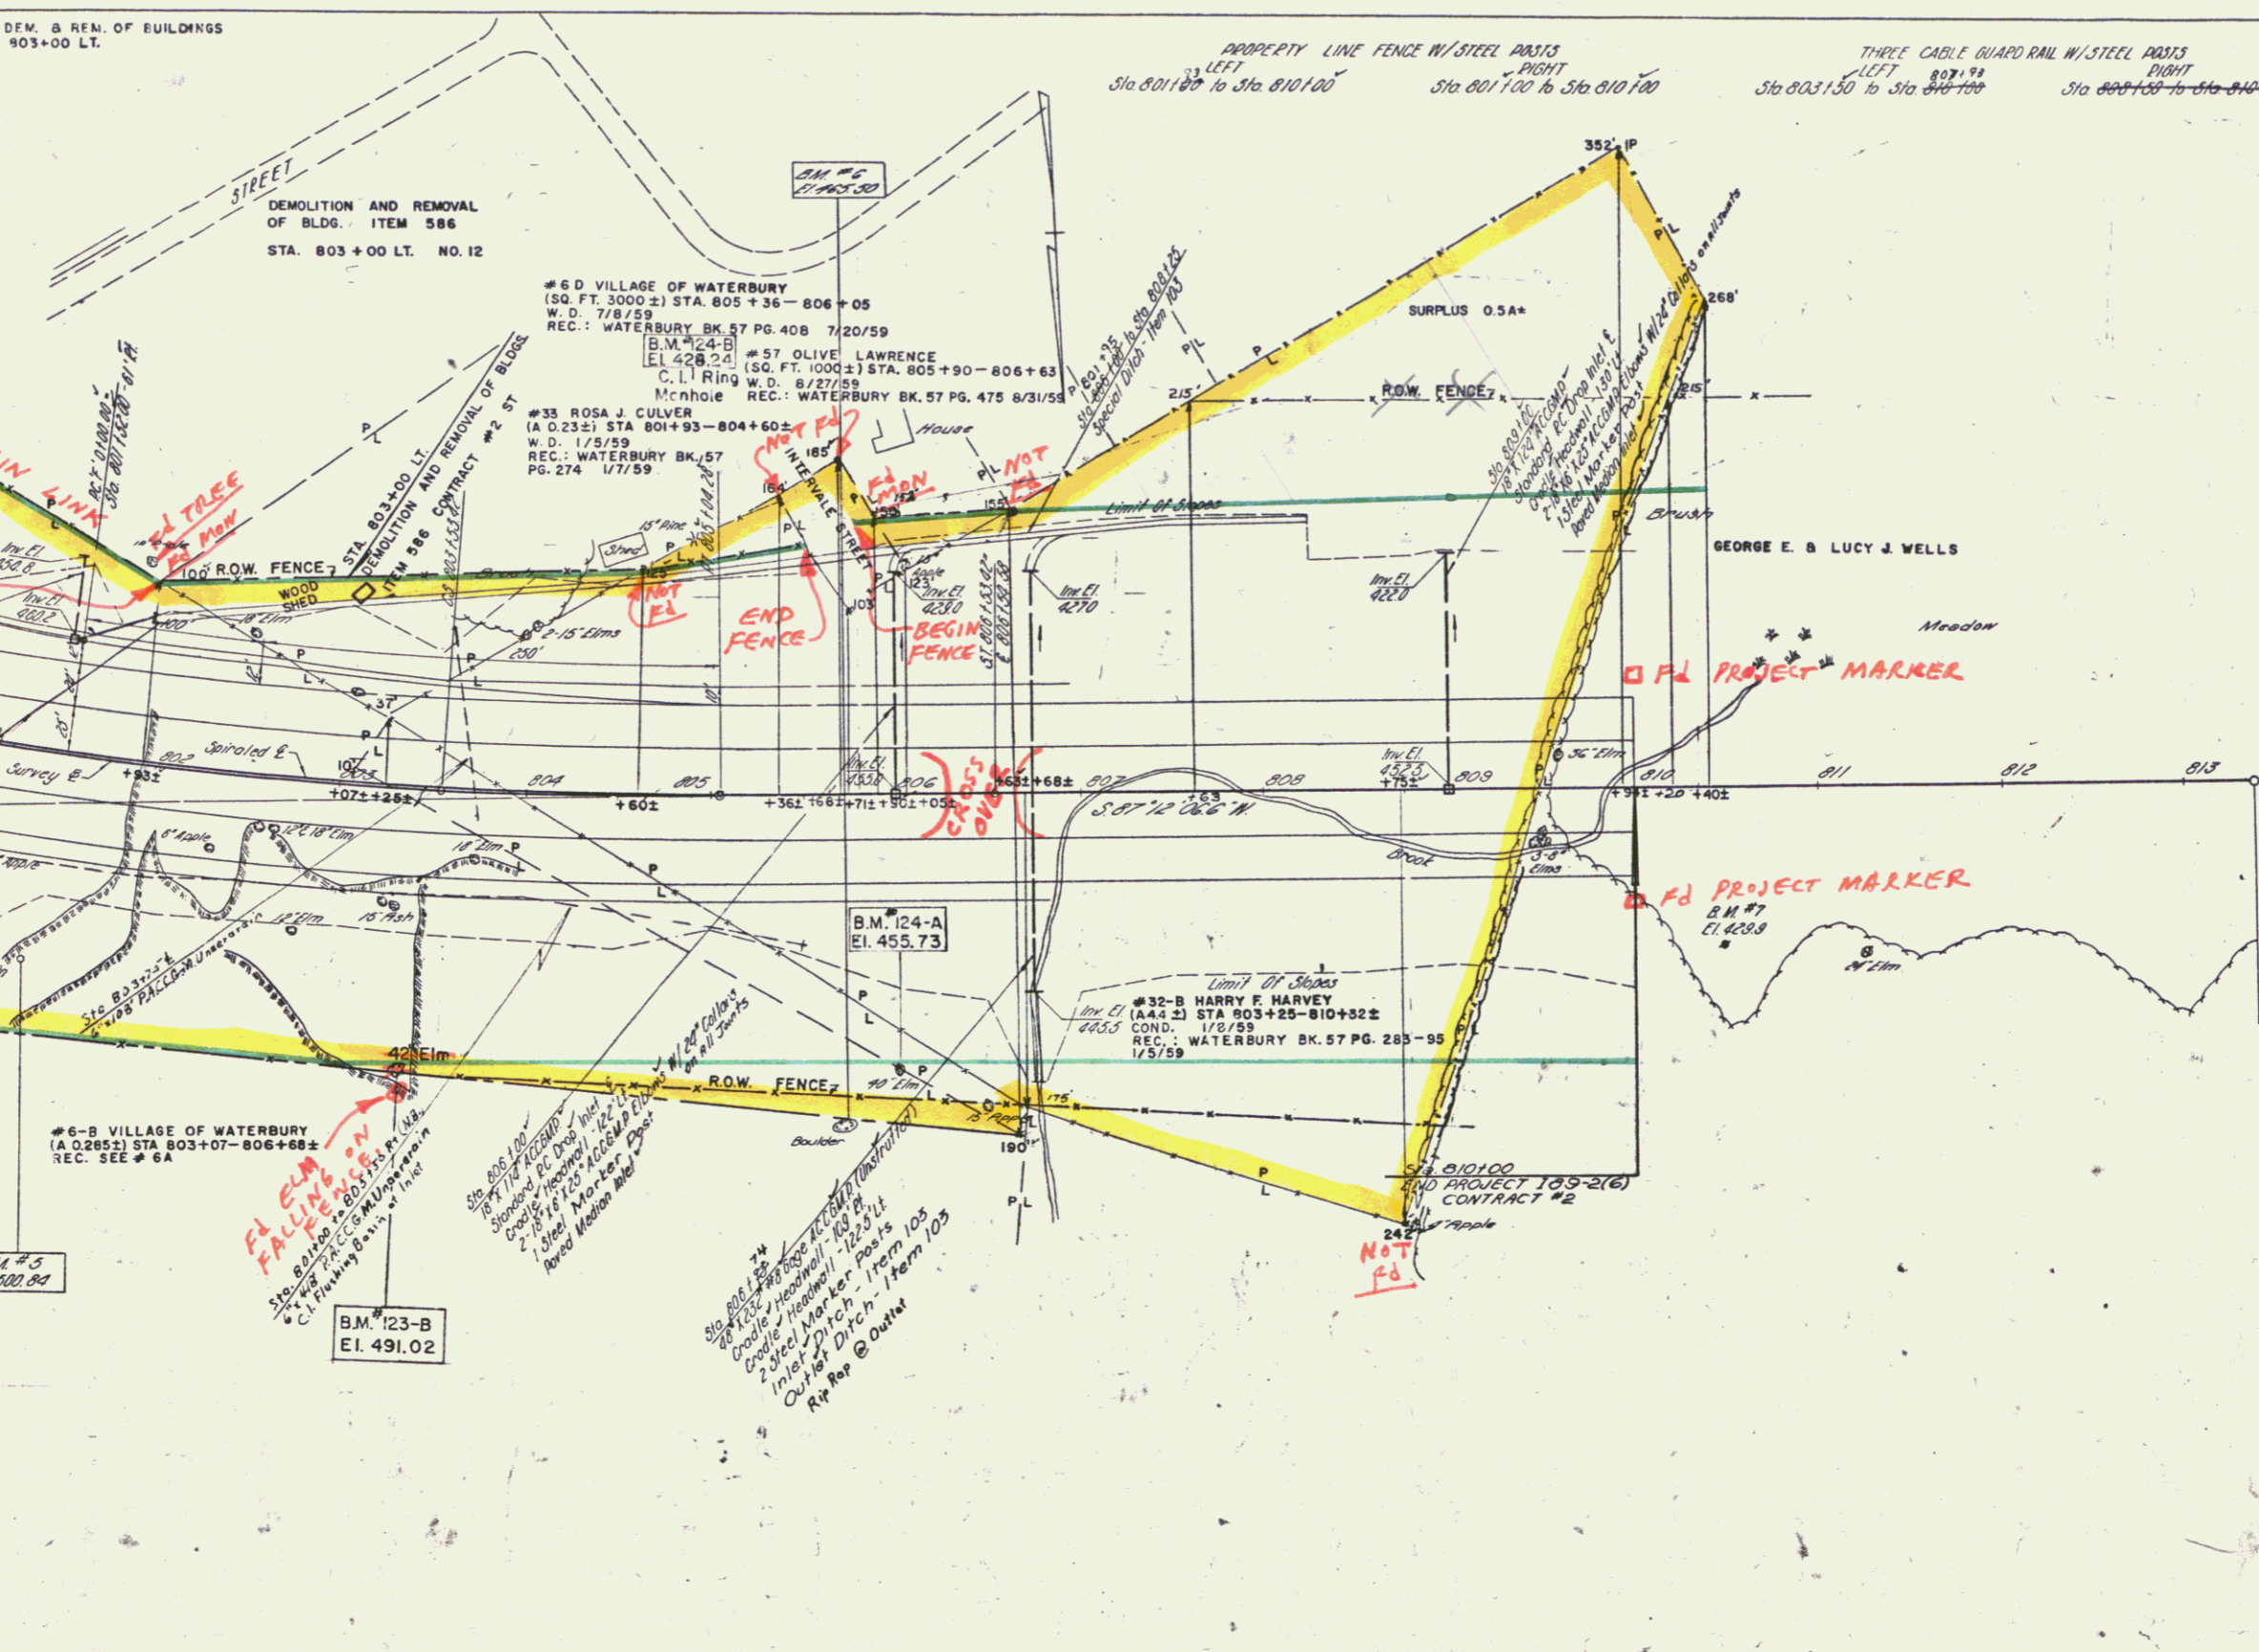

STATE OF VERMONT DEPARTMENT OF HIGHWAYS	
INTERSTATE PROJECT IN THE TOWN OF WATERBURY	
PLAN	
WILLIAM H. McFARLAND ENGINEER BINGHAMTON, N. Y.	
SUPERVISED BY	CHECKED BY
DRAWN BY	IN CHARGE
PROJECT NO. I 59-258	DATE
SHEET 25 OF 329	
P/L'S REVISED 4/21/59 <i>SLC</i>	