


THREE CABLE GUARD RAIL WITH STEEL POSTS ITEM 543				CONSTRUCT ROCK FILL SEE SPECIAL PROVISION NO. 6				FILLS ON EXISTING RIVER BANK TO BE MADE FROM ROCK SEE SPECIAL PROVISION NO.				STONE FILL FOR SLOPE PROTECTION ITEM 522				EXCAVATION & REMOVAL OF ROAD SURFACE ON ROADWAYS ITEM 118-A				CHANNEL EXCAVATION ITEM 106				PROPERTY LINE FENCE WITH STEEL POSTS																			
LOCA	STA	STA	POS	LOCA	STA	STA	POS	LOCA	STA	STA	POS	LOCA	STA	STA	POS	LOCA	STA	STA	POS	LOCA	STA	STA	POS	LOCA	STA	STA	POS																
859+66	863+88	863+88	RT	860+40	863+33	863+33	RT	US-2	857+00	862+00	LT	859+85	862+50	862+50	RT	US-2	862+20	863+55	RT	US-2	858+75	860+00	RT	US-2	862+20	863+55	RT	US-2	858+75	860+00	RT	863+00	863+50	863+50	RT	863+00	863+50	863+50	RT	863+00	863+50	863+50	RT

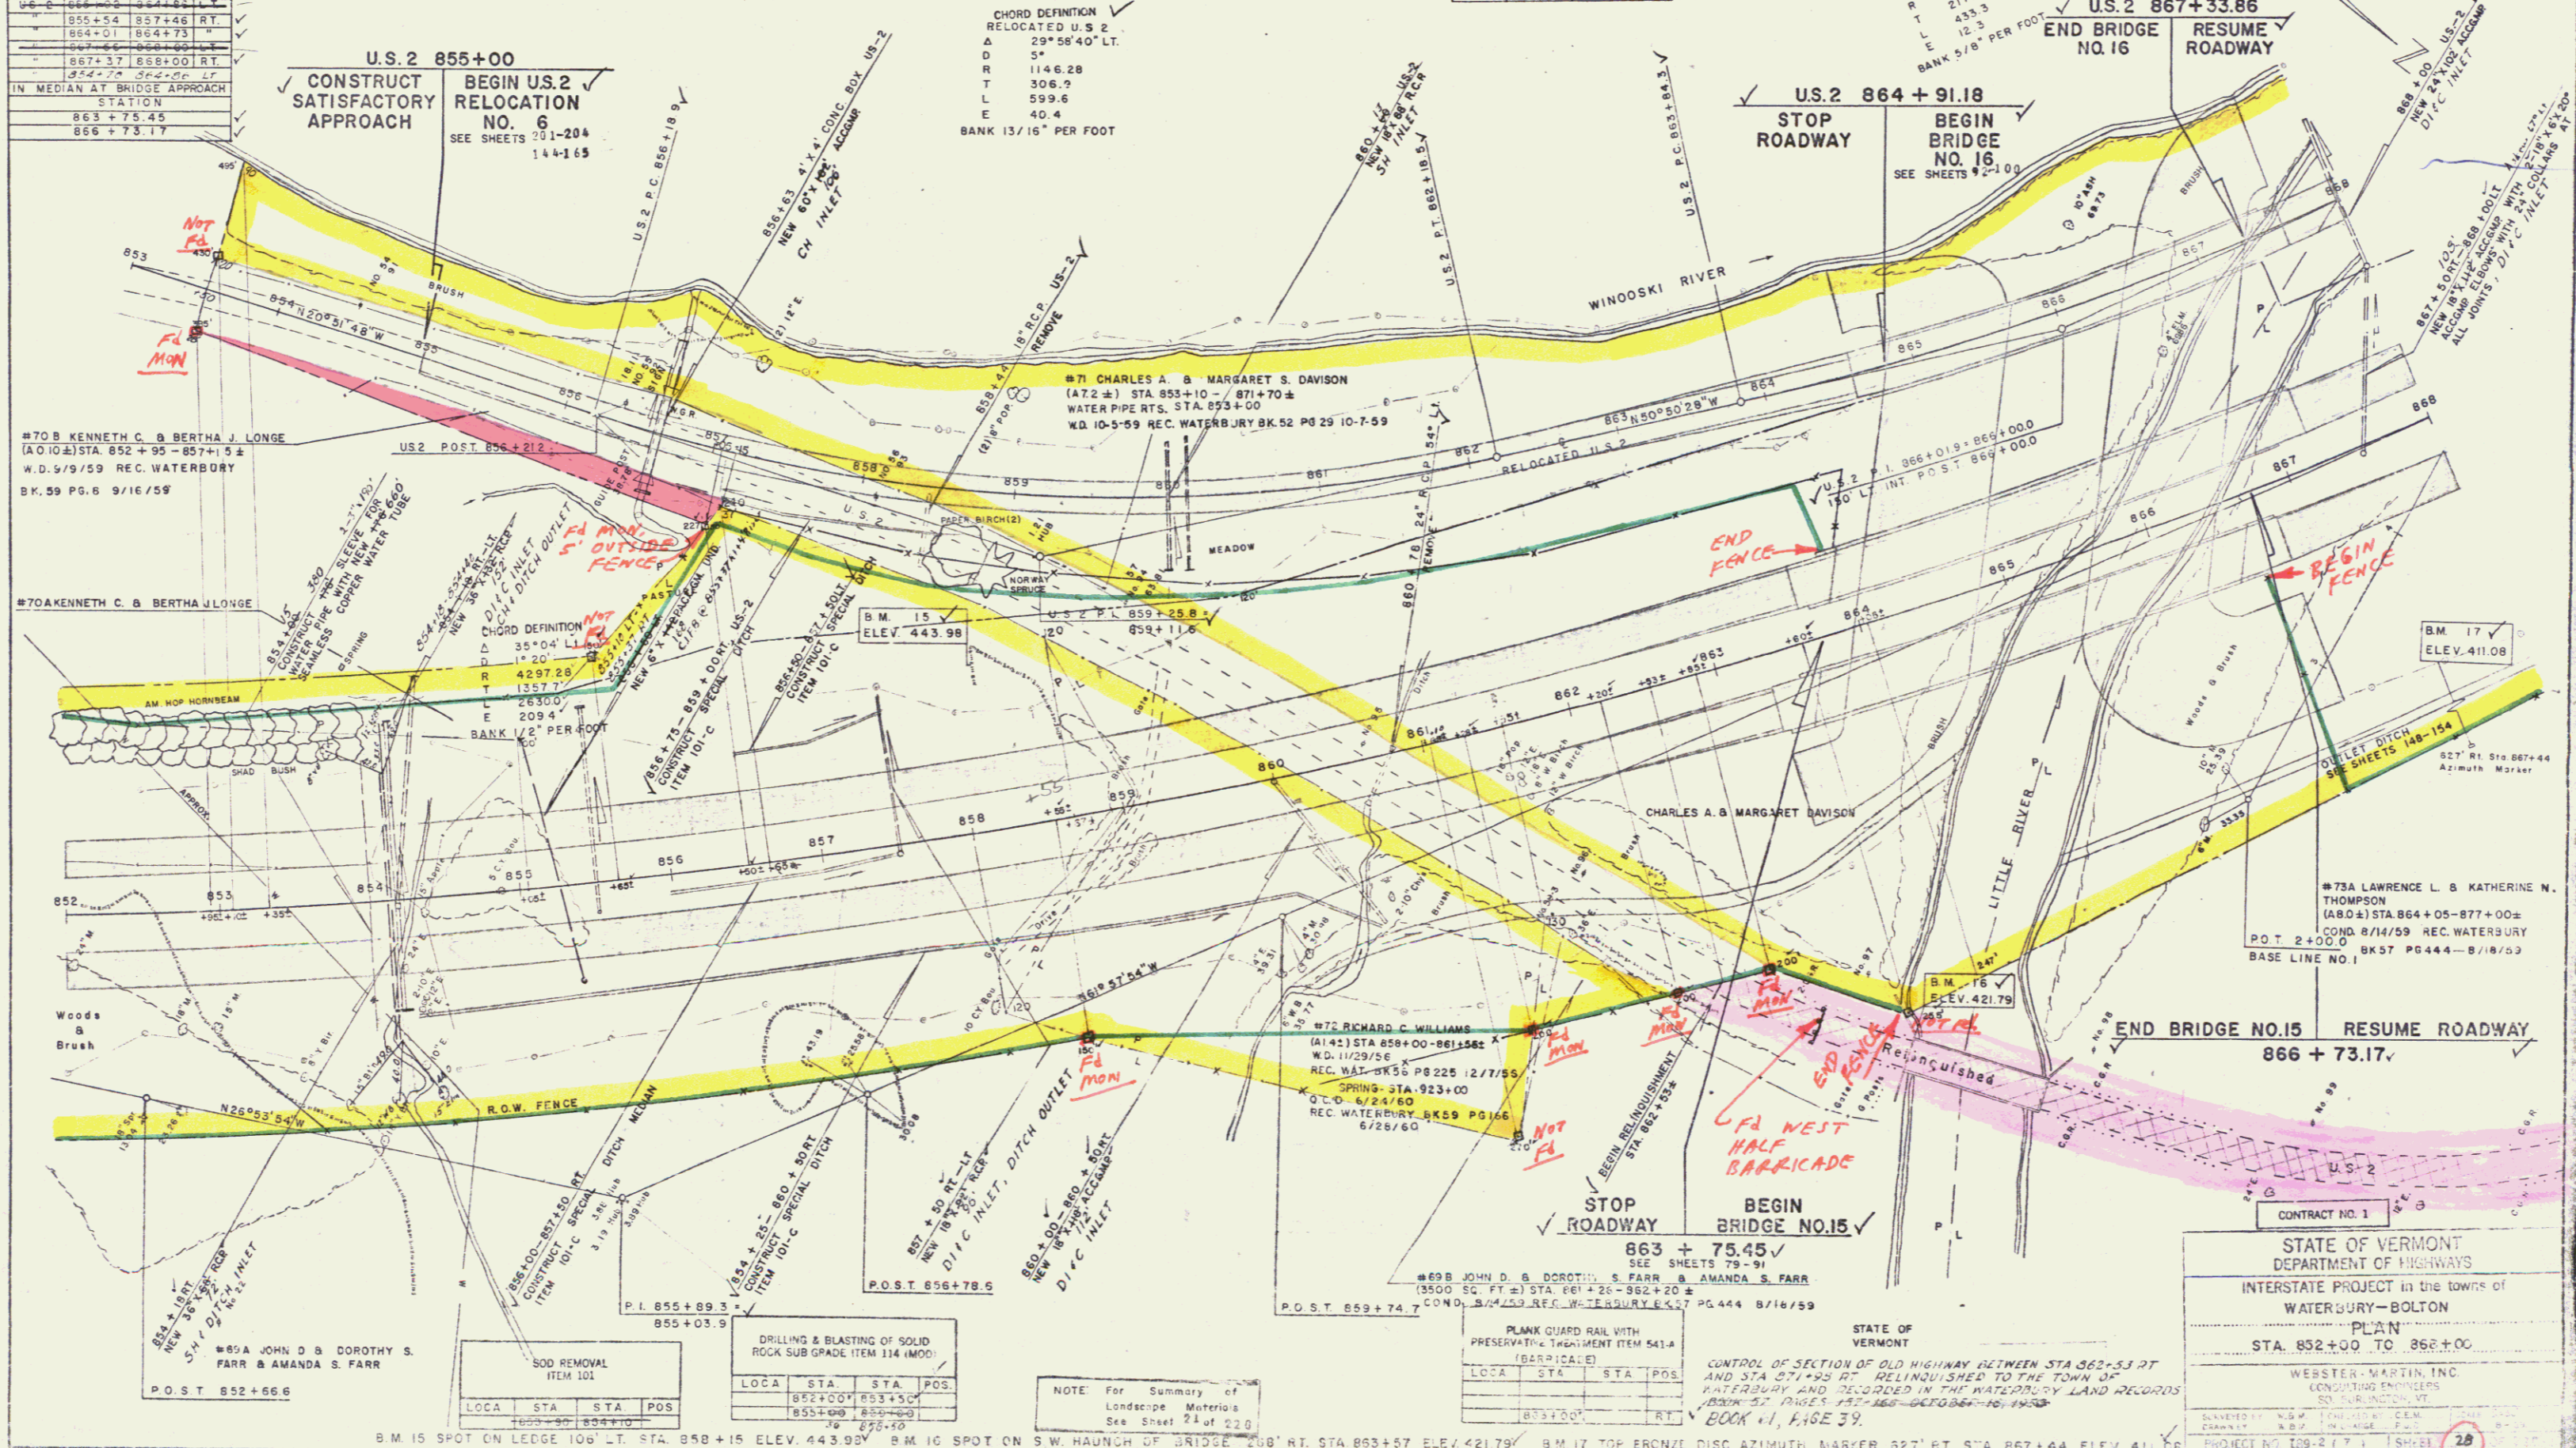

STATE OF VERMONT  
DEPARTMENT OF HIGHWAYS  
INTERSTATE PROJECT in the towns of  
WATERBURY-BOLTON  
PLAN  
STA. 852+00 TO 868+00  
WESTER-MARTIN, INC.  
CONSULTING ENGINEERS  
500 BURLINGTON ST.  
BURLINGTON, VT.  
PROJECT NO. 109-2 (7-1) SHEET 28

B.M. 15 SPOT ON LEDGE 106' LT. STA. 858+15 ELEV. 443.92' B.M. 16 SPOT ON S.W. HAUNCH OF BRIDGE NO. 15 RT. STA. 863+57 ELEV. 421.79' B.M. 17 TOP BRONZE DISC AZIMUTH MARKER 527' RT. STA. 867+44 ELEV. 411.08'