

CONSTRUCT ROCK FILL SEE SPECIAL PROVISION NO. 6				CONSTRUCT DRIVE				TWO CABLE GUARD RAIL ITEM 542				CHANNEL EXCAVATION ITEM 106			
LOCA.	STA.	STA.	POS.	LOCA.	STA.	STA.	POS.	LOCA.	STA.	STA.	POS.	LOCA.	STA.	STA.	POS.
US-2	868+00	872+30	RT	WATERBURY DAM ROAD	3+80			WATERBURY DAM ROAD	2+80	4+56	RT	US-2	868+00	872+50	LT
WATERBURY DAM ROAD	2+80	6+00	RT												

THREE CABLE GUARD RAIL WITH STEEL POSTS ITEM 543				CONSTRUCT RAMP			
LOCA.	STA.	STA.	POS.	LOCA.	STA.	STA.	POS.
872+00	872+00	872+00	LT	877+00	877+00	877+00	RT
872+00	872+00	872+00	RT	877+00	877+00	877+00	LT
872+00	872+00	872+00	LT	877+00	877+00	877+00	RT
872+00	872+00	872+00	RT	877+00	877+00	877+00	LT
872+00	872+00	872+00	LT	877+00	877+00	877+00	RT
872+00	872+00	872+00	RT	877+00	877+00	877+00	LT

PROPERTY LINE FENCE ITEM 583-B (MOD) W/ STEEL POSTS			
LOCA.	STA.	STA.	POS.
RT LANE	873+00	877+00	RT
RT LANE	877+15	884+00	RT
RT LANE	877+15	884+00	LT
LT LANE	873+15	884+00	LT


DEMOLITION & REMOVAL OF BUILDING ITEM 500			
BLDG. NO.	POS.	STATION	
6	RT	873+28	
7	LT	876+25	
8	LT	876+45	
9	LT	876+78	
10	RT	877+00	
11	LT	877+05	
12	LT	877+05	
13	LT	877+38	
14	LT	877+70	
15	LT	877+73	

CONTRACT NO. 1
STATE OF VERMONT
DEPARTMENT OF HIGHWAYS
INTERSTATE PROJECT in the towns of
WATERBURY - BOLTON
PLAN
STA. 868+00 TO 884+00
WEBSTER-MARTIN INC.
CONSULTING ENGINEERS
30 BURLINGTON, VT.
SURVEYED BY W.B.M. CHECKED BY C.E.M. DATE 11-1-59
DRAWN BY W.B.M. IN CHARGE P.C.L. DATE 11-1-59
PROJECT NO. 123-2 (7) SHEET 30 OF 120

EXCAVATION & REMOVAL OF ROAD SURFACE ON ROADWAYS ITEM 110-A			
LOCA.	STA.	STA.	POS.
WATERBURY DAM ROAD	872+72	873+25	RT
WATERBURY DAM ROAD	5+50	6+48	RT

SEEDING (SPECIAL) ITEM 611			
LOCA.	STA.	STA.	POS.
WATERBURY DAM ROAD	877+50	881+00	RT

REMOVAL OF EXISTING PAVT. ITEM 101-C			
LOCA.	STA.	STA.	POS.
WATERBURY DAM ROAD	5+00	5+50	

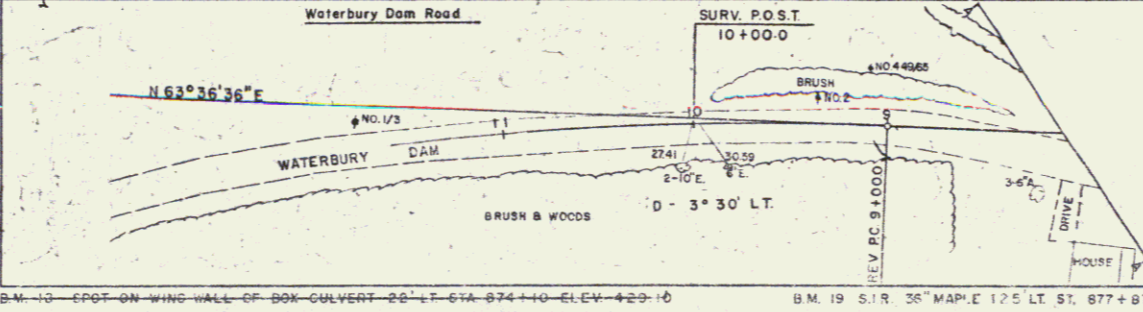

BM 10 - SPOT ON WIND WALL OF 608 - CHURCH - 26 - 7 - STA. 874+40 - ELEV. 429.10
BM 19 - S.W. 36' MAPLE 175' LT. ST. 877+87 - ELEV. 454.92