


PROPERTY LINE FENCE ITEM 583-B (MOD) W / STEEL POSTS			
LOCA	STA	STA	POS
U.S. 2	996+00	1012+00	LT

CHANNEL EXCAVATION ITEM 106			
LOCA	STA	STA	POS
U.S. 2	1003+00	1007+50	LT

CONSTRUCT ROCK FILL SEE SPECIAL PROVISION NO 6			
LOCA	STA	STA	POS
U.S. 2	1002+30	1012+00	LT

EXCAVATION & REMOVAL OF ROAD SURFACE ON ROADWAYS ITEM 118-A			
LOCA	STA	STA	POS
U.S. 2	996+00	1002+75	LT
U.S. 2	996+75	1012+00	LT

DEMOLITION & REMOVAL OF BUILDING ITEM 586		
BLDG NO	STATION	POS
24	1008+75	LT

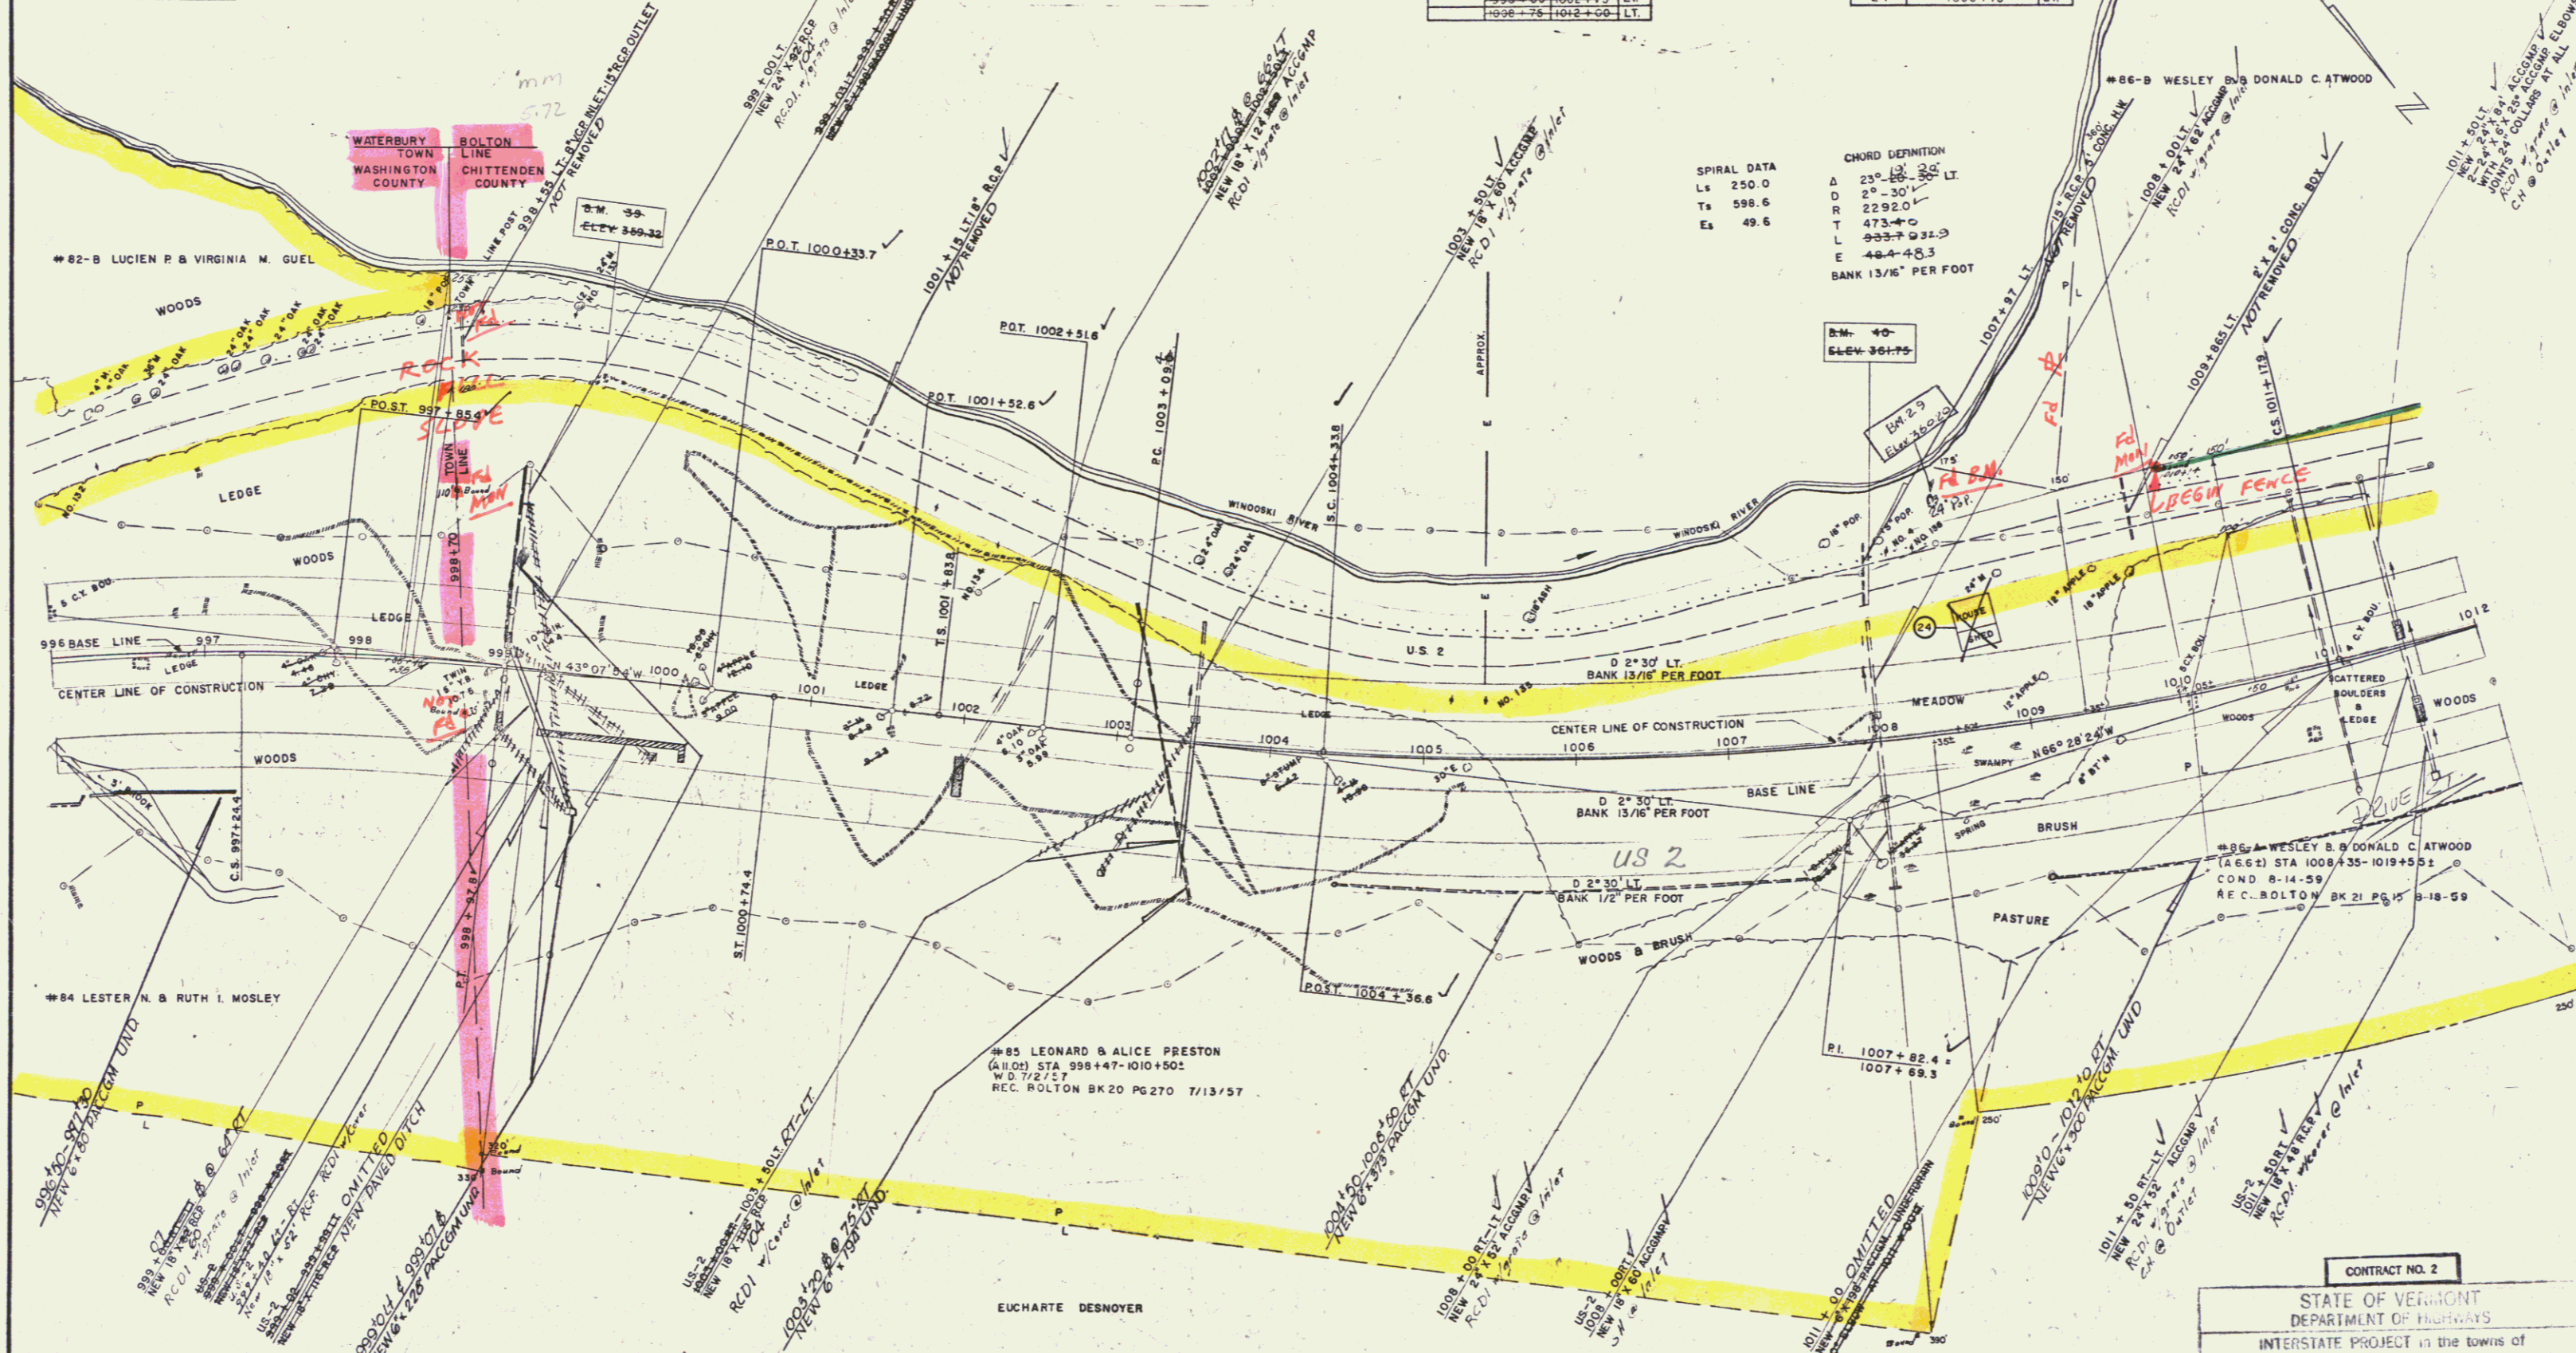

SPIRAL DATA
 Ls 250.0
 Ts 598.6
 Es 49.6

CHORD DEFINITION
 D 23° 30' 30" LT
 D 2° 30' 30" LT
 R 2292.0
 T 473.4
 L 993.7 @ 32.3
 E 484.4 @ 3.3
 BANK 13/16" PER FOOT

DRILLING & BLASTING OF SOLID ROCK SUB GRADE ITEM 114 (MOD)			
LOCA	STA	STA	POS
U.S. 2	996+25	1004+50	LT
U.S. 2	1009+50	1012+00	LT

DRILLING & BLASTING OF SOLID ROCK ITEM 113			
LOCA	STA	STA	POS
U.S. 2	1002+00	1005+50	LT

THREE CABLE GUINED RAIL WITH STEEL POSTS ITEM 543			
LOCA	STA	STA	POS
U.S. 2	996+00	997+50	LT
U.S. 2	1002+25	1012+00	LT

STANDARD STEEL BEAM GUARD RAIL WITH STEEL POSTS (MEDIAN TYPE) ITEM 547-A			
LOCA	STA	STA	POS
U.S. 2	996+00	1012+00	LT

GRANITE CURB ITEM 556-B			
LOCA	STA	STA	POS
U.S. 2	996+00	1012+00	LT

SOD REMOVAL ITEM 101			
LOCA	STA	STA	POS
U.S. 2	996+00	1007+50	LT
U.S. 2	1009+50	1012+00	LT

CONTRACT NO. 2
 STATE OF VERMONT
 DEPARTMENT OF HIGHWAYS
 INTERSTATE PROJECT IN THE TOWNS OF
 WATERBURY - BOLTON
 PLAN
 STA. 996+00 TO 1012+00
 WEBSTER MARTIN, INC.
 CONSULTING ENGINEER
 50 BURLINGTON, VT.
 W.M. CEM. P.D.
 PROJECT NO. 129 2 (7) 47 215

BM 29 SPOT ON LEDGE 165 FT STA 999+40 ELEV 559.52
 BM 29 3.1T 24" POP 150' LT STA 1006+50 EL. 520.22
 BM 40 SPOT ON HEADWALL 15' RCP CULVERT 52' LT STA 1007+38 ELEV 561.75