


DEMOLITION & REMOVAL OF BUILDING ITEM 596				PROPERTY LINE FENCE ITEM 583-B (MOD) W/ STEEL POSTS			
BLOG NO.	STA.	POS.	LOCA.	STA.	STA.	POS.	
25	1015+60	LT	LT LANE	1018+00	1028+00	LT	
27	1024+25	LT					
28	1028+30	LT					
26	1023+00 (US-2)	RT					

REMOVAL OF EXISTING PAVEMENT ITEM 101-C			
LOCA.	STA.	STA.	POS.
	1025+00	1028+00	

EXCAVATION & REMOVAL OF ROAD SURFACE ON ROADWAYS ITEM 118-A			
LOCA.	STA.	STA.	POS.
	1012+00	1014+00	LT
	1022+00	1027+00	LT

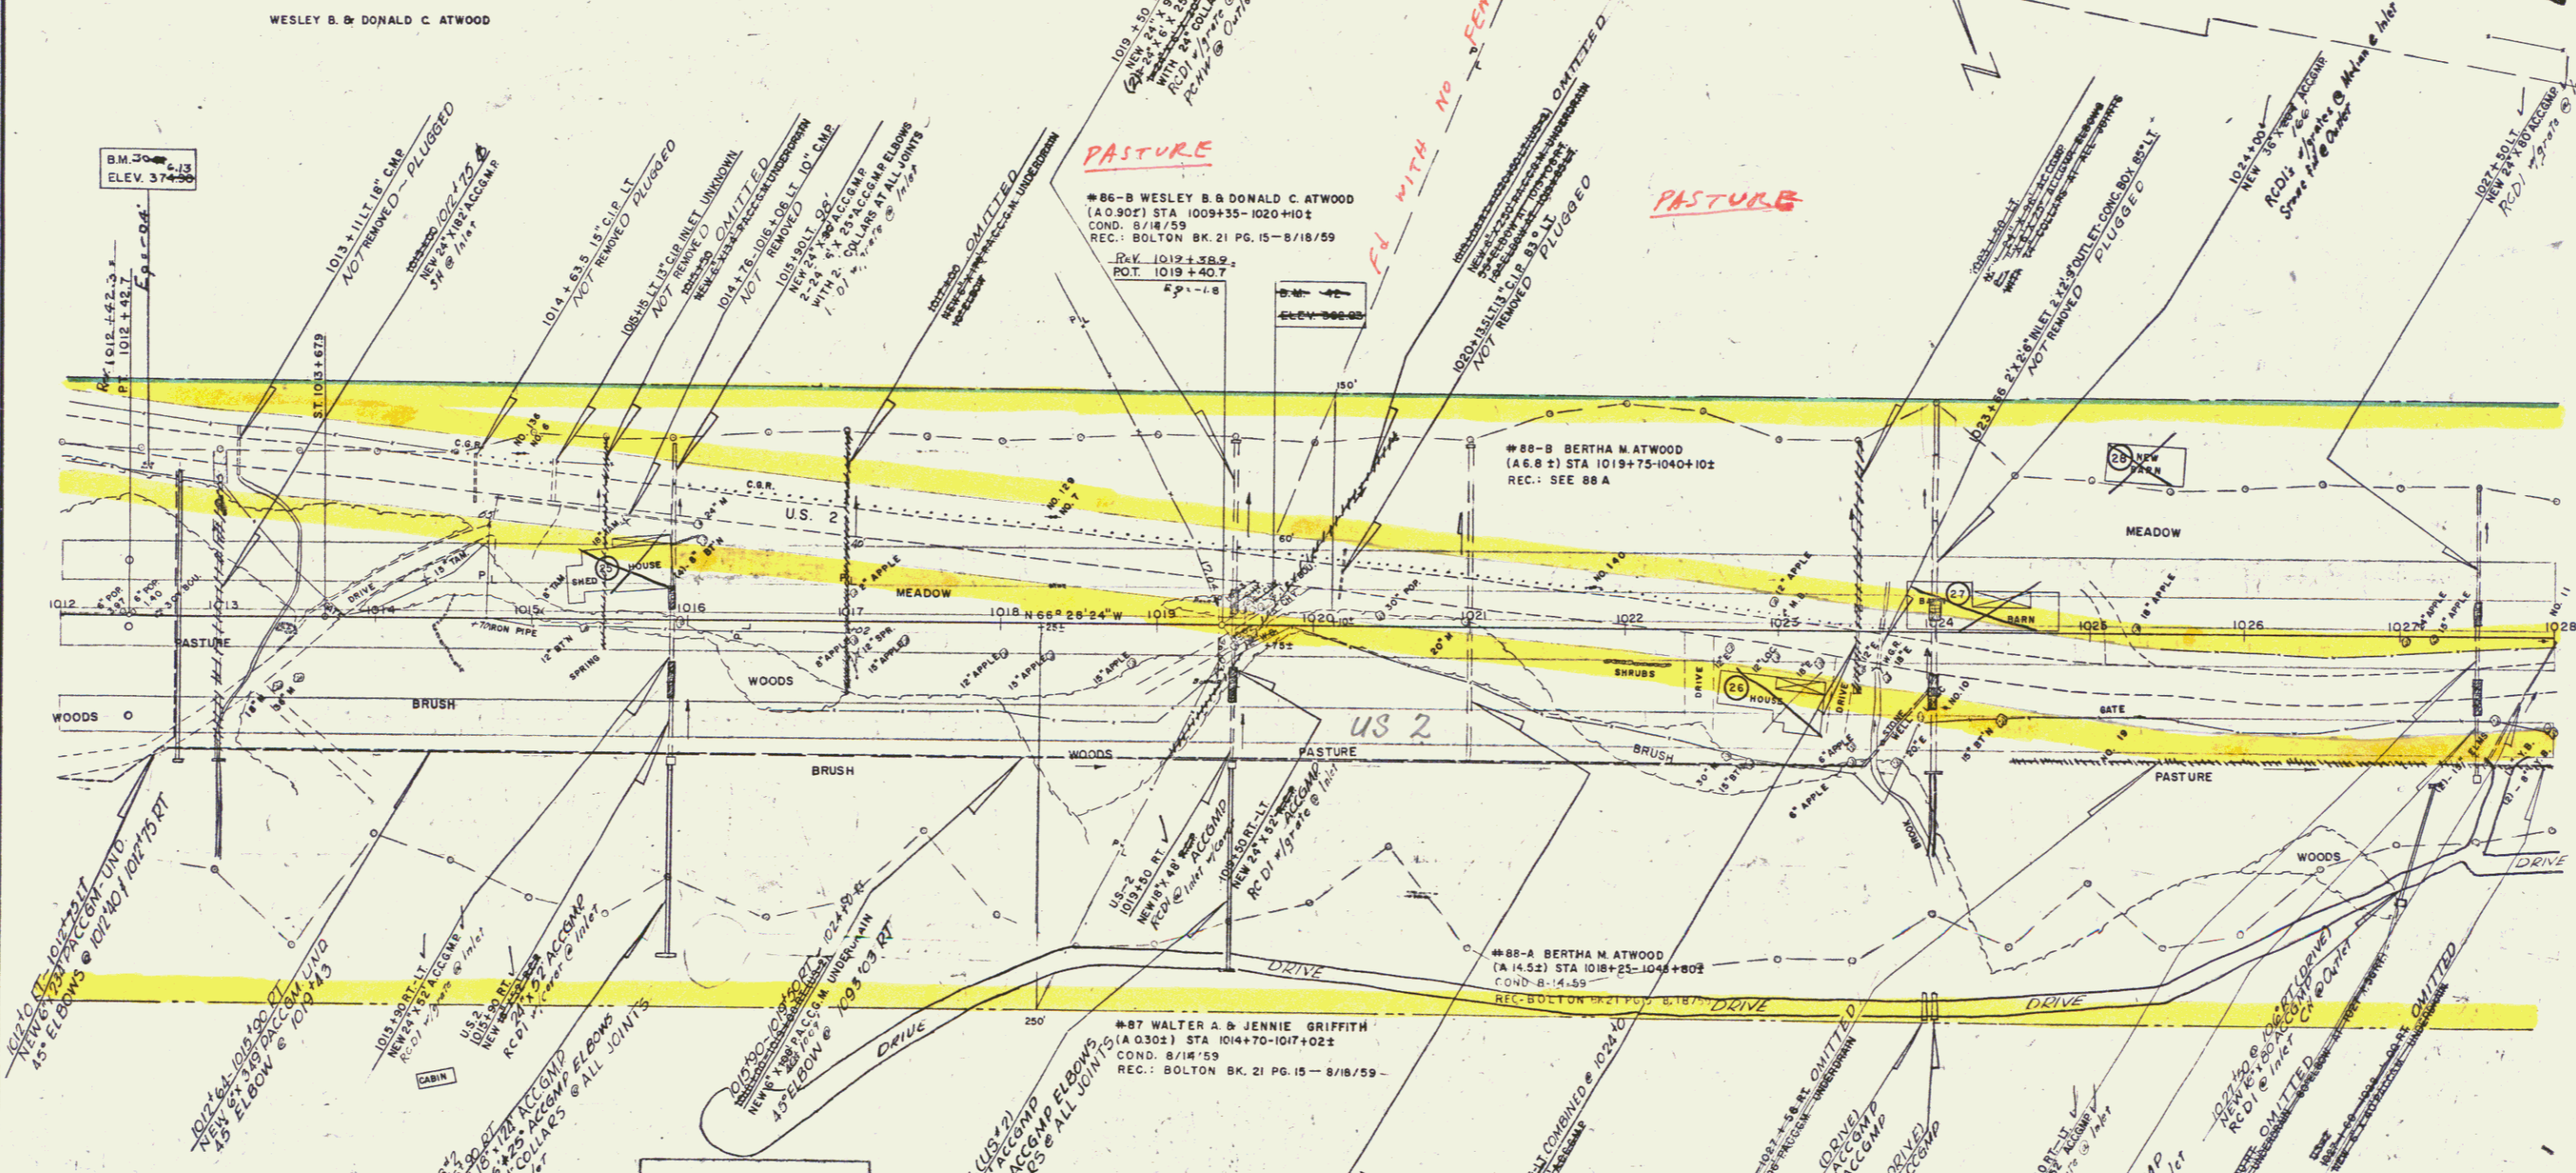

B.M. 306  
ELEV. 374.98

WESLEY B. & DONALD C. ATWOOD

BERTHA M. ATWOOD

86-B WESLEY B. & DONALD C. ATWOOD  
(A 0.90') STA 1009+35-1020+10  
COND. 8/18/59  
REC. BOLTON BK. 21 PG. 15 - 8/18/59

88-B BERTHA M. ATWOOD  
(A 6.8') STA 1019+75-1040+10  
REC. SEE 88 A

88-A BERTHA M. ATWOOD  
(A 14.5') STA 1018+25-1048+80  
COND. 8-14-59  
REC. BOLTON BK. 21 PG. 15 - 8/18/59

87 WALTER A. & JENNIE GRIFFITH  
(A 0.30') STA 1014+70-1017+02  
COND. 8/18/59  
REC. BOLTON BK. 21 PG. 15 - 8/18/59

GRANITE CURB ITEM 556-B			
LOCA.	STA.	STA.	POS.
LT LANE	1012+00	1028+00	RT
RT LANE	1012+00	1028+00	LT
US-2	1012+00	1028+00	LT

THREE CABLE GUARD RAIL WITH STEEL POSTS ITEM 543			
LOCA.	STA.	STA.	POS.
LT LANE	1012+00	1028+00	LT

STANDARD STEEL BEAM GUARD RAIL WITH STEEL POSTS (MEDIUM TYPE) ITEM 547-A			
LOCA.	STA.	STA.	POS.
RT LANE	1012+00	1028+00	RT
LT LANE	1012+00	1028+00	MED

DRILLING & BLASTING OF SOLID ROCK ITEM 113			
LOCA.	STA.	STA.	POS.
	1012+50	1015+00	
	1014+00	1018+50	

DRILLING & BLASTING OF SOLID ROCK SUB GRADE ITEM 114 (MOD)			
LOCA.	STA.	STA.	POS.
	1020+00	1021+50	
US-2	1012+50	1018+50	
	1019+00	1021+50	

SOD REMOVAL ITEM 101			
LOCA.	STA.	STA.	POS.
	1014+00	1014+70	
	1023+00	1023+50	

CONTRACT NO. 2  
STATE OF VERMONT  
DEPARTMENT OF HIGHWAYS  
INTERSTATE PROJECT in the towns of  
WATERBURY - BOLTON  
PLAN  
STA. 1012+00 TO 1028+00  
WEBSTER MARTIN, INC.  
CONSULTING ENGINEERS  
50 BURLINGTON ST.  
BURLINGTON, VT. 05401  
PROJECT NO. 289 2 (7) SHEET 49

B.M. 307 SPOT ON LEDGE 100' LT STA 1012+54 ELEV. 375.15

B.M. 42 SPOT ON LEDGE 18' LT STA 1019+73 ELEV. 382.83