


PROPERTY LINE FENCE ITEM 583-B (MOD) W/ STEEL POSTS			
LOCA	STA	STA	POS
LT LANE	1060+00	1076+00	LT

SOD REMOVAL ITEM 101			
LOCA	STA	STA	POS
	1060+00	1060+60	
	1065+50	1067+80	
	1069+40	1072+80	

THREE CABLE GUARD RAIL WITH STEEL POSTS ITEM 543			
LOCA	STA	STA	POS
LT LANE			LT
RT LANE	1060+00	1076+00	RT

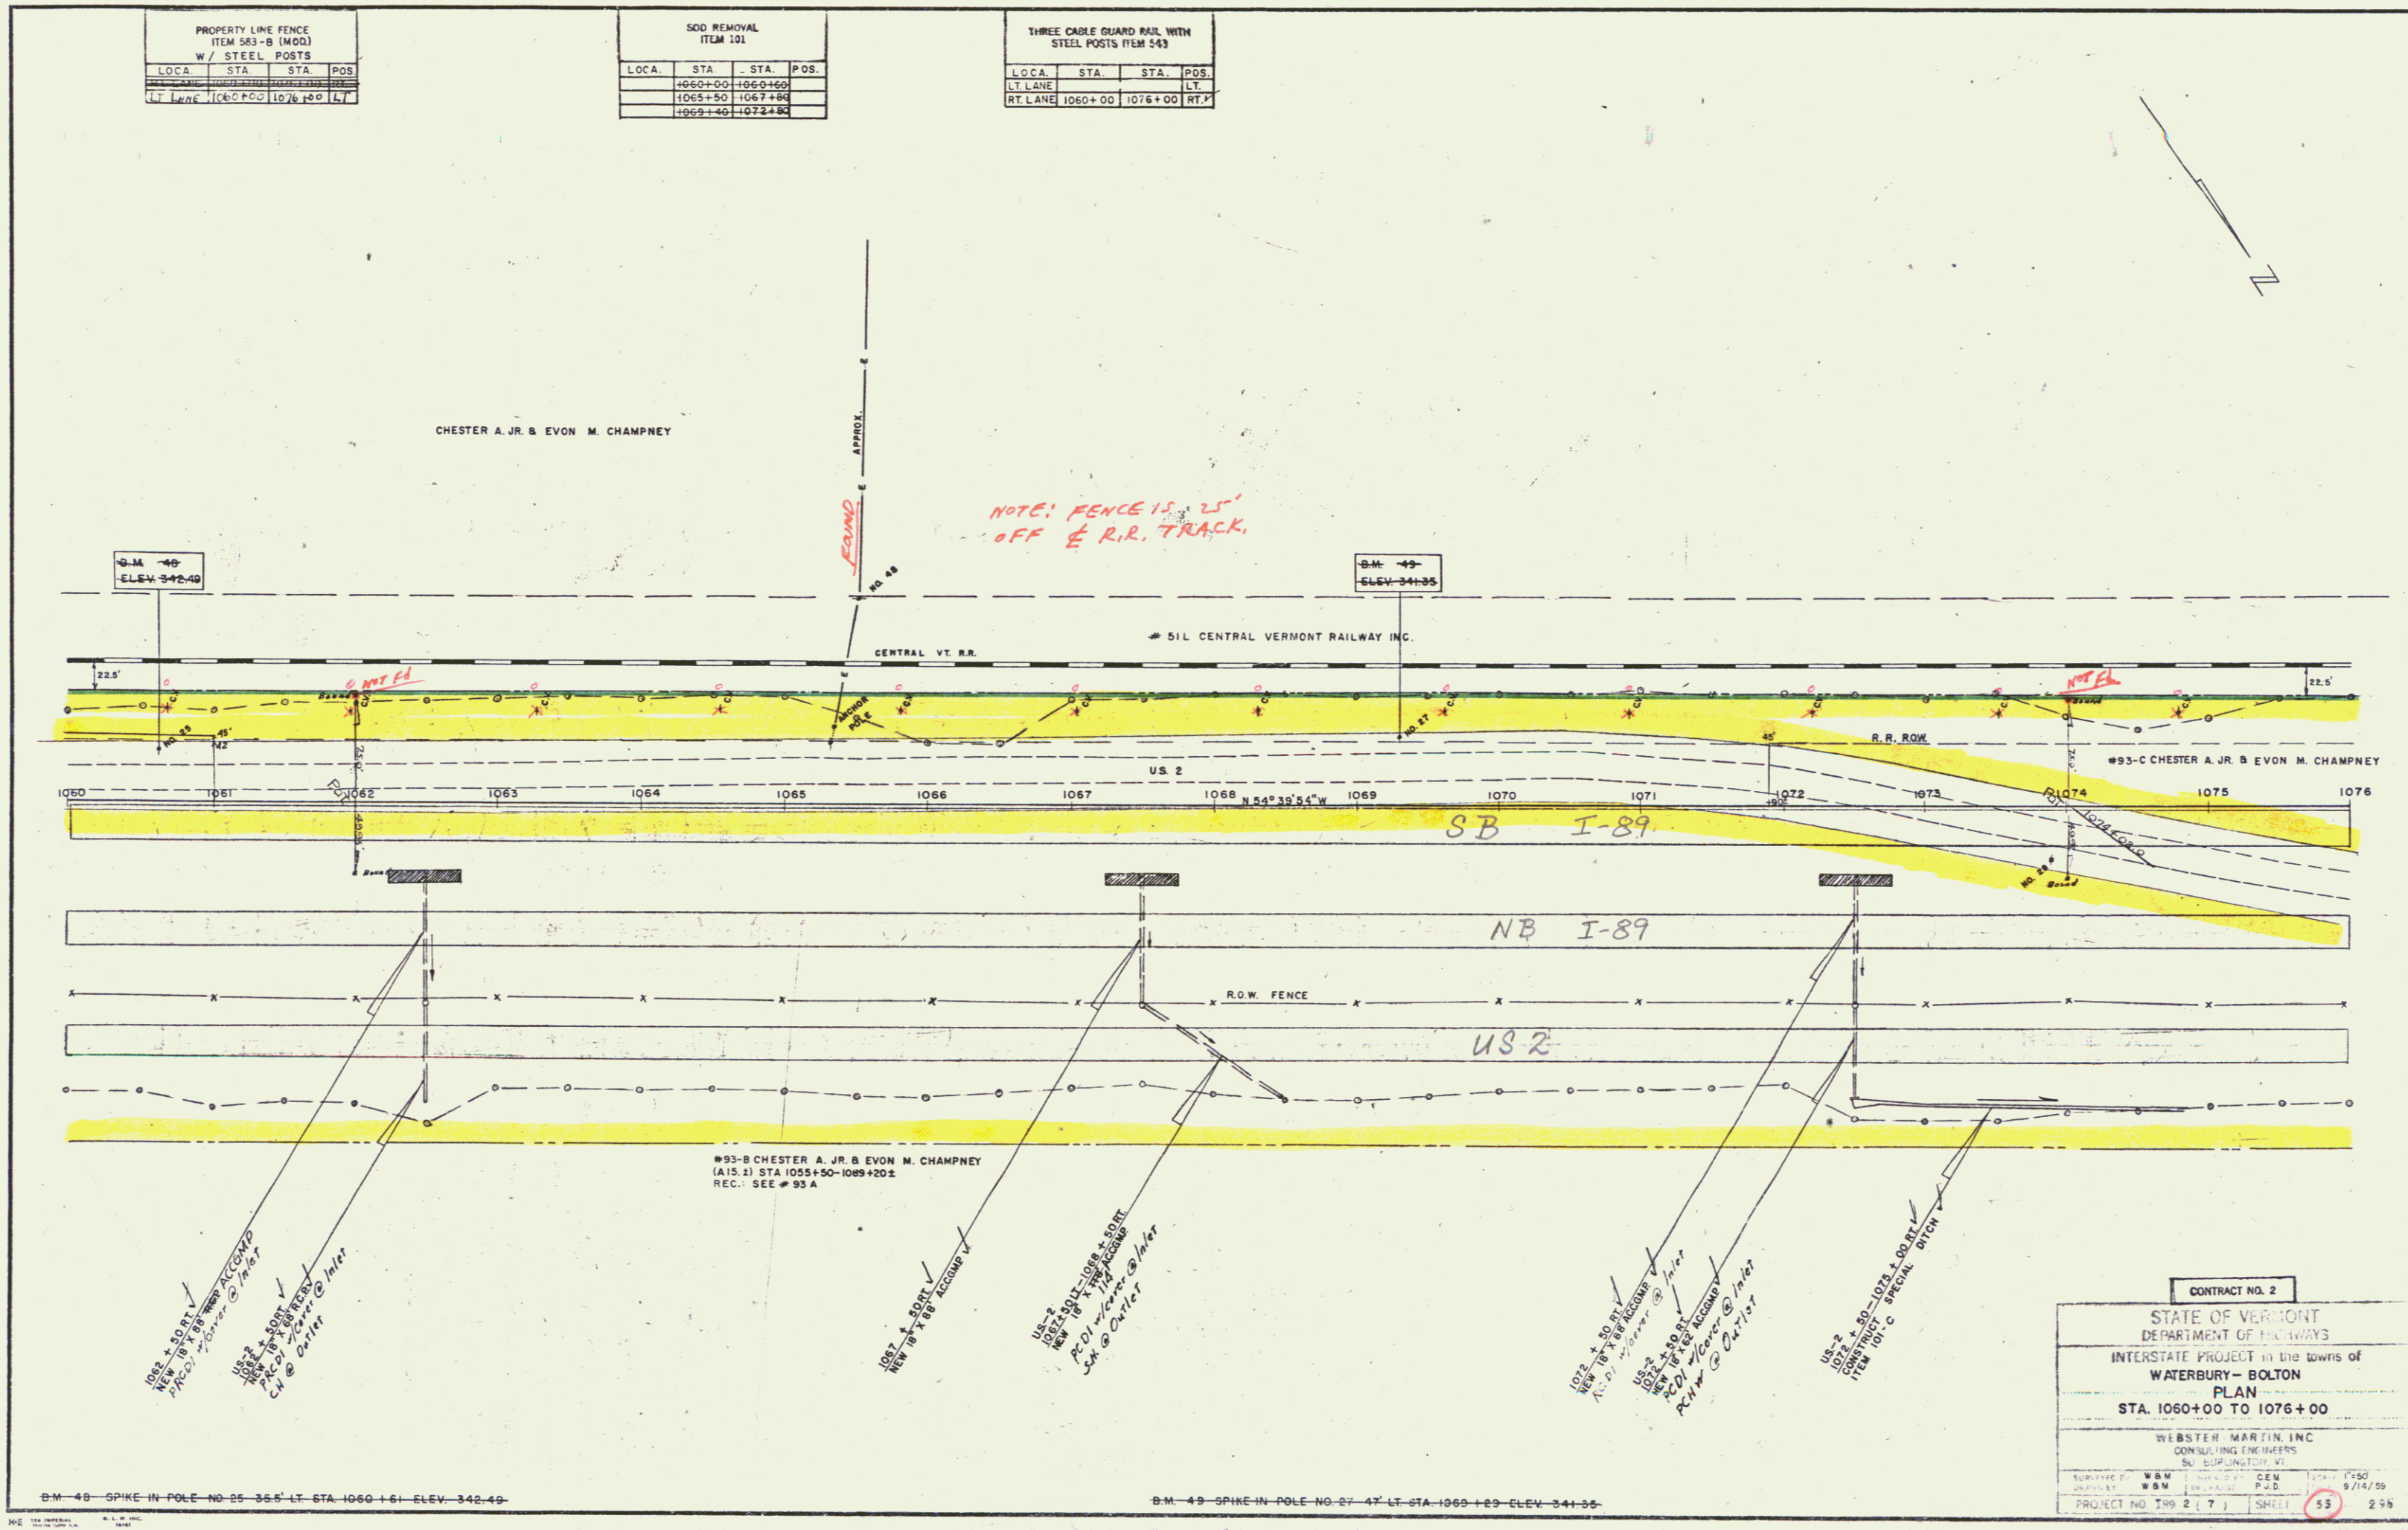

NOTE: FENCE IS 25'  
OFF E. R.R. TRACK.

1065 + 50 RT LANE  
NEW 18" X 24" CONC. POSTS  
ACCOMP. BY 1/2" X 1/2" GALV.  
STEEL W/COVER @ Inter  
C/L @ Outlet

1067 + 50 RT LANE  
NEW 18" X 24" CONC. POSTS  
ACCOMP. BY 1/2" X 1/2" GALV.  
STEEL W/COVER @ Inter  
C/L @ Outlet

1072 + 50 RT LANE  
NEW 18" X 24" CONC. POSTS  
ACCOMP. BY 1/2" X 1/2" GALV.  
STEEL W/COVER @ Inter  
C/L @ Outlet

1073 + 50 RT LANE  
NEW 18" X 24" CONC. POSTS  
ACCOMP. BY 1/2" X 1/2" GALV.  
STEEL W/COVER @ Inter  
C/L @ Outlet

CONTRACT NO. 2

STATE OF VERMONT  
DEPARTMENT OF HIGHWAYS

INTERSTATE PROJECT in the towns of  
WATERBURY - BOLTON

PLAN  
STA. 1060+00 TO 1076+00

WEBSTER MARTIN, INC.  
CONSULTING ENGINEERS  
50 BURLINGTON ST.  
BURLINGTON, VT.

DESIGNED BY: WBM  
CHECKED BY: WBM  
PROJECT NO. TR9 2 ( 7 )  
SHEET 53 255