


MUCK EXCAVATION ITEM 116			
LOCA	STA	STA	POS
1173+75	1182+25		

SEEDING (SPECIAL) ITEM 518			
LOCA	STA	STA	POS
1172+00	1188+00		

DRILLING & BLASTING SOLID ROCK
SUBGRADE
STA. 1185+21 - 1187+00 RT.

THREE CABLE GUARD RAIL WITH STEEL POSTS ITEM 543			
LOCA	STA	STA	POS
1172+00	1188+00		
1185+10	1190+00	LT	

U.S. 2

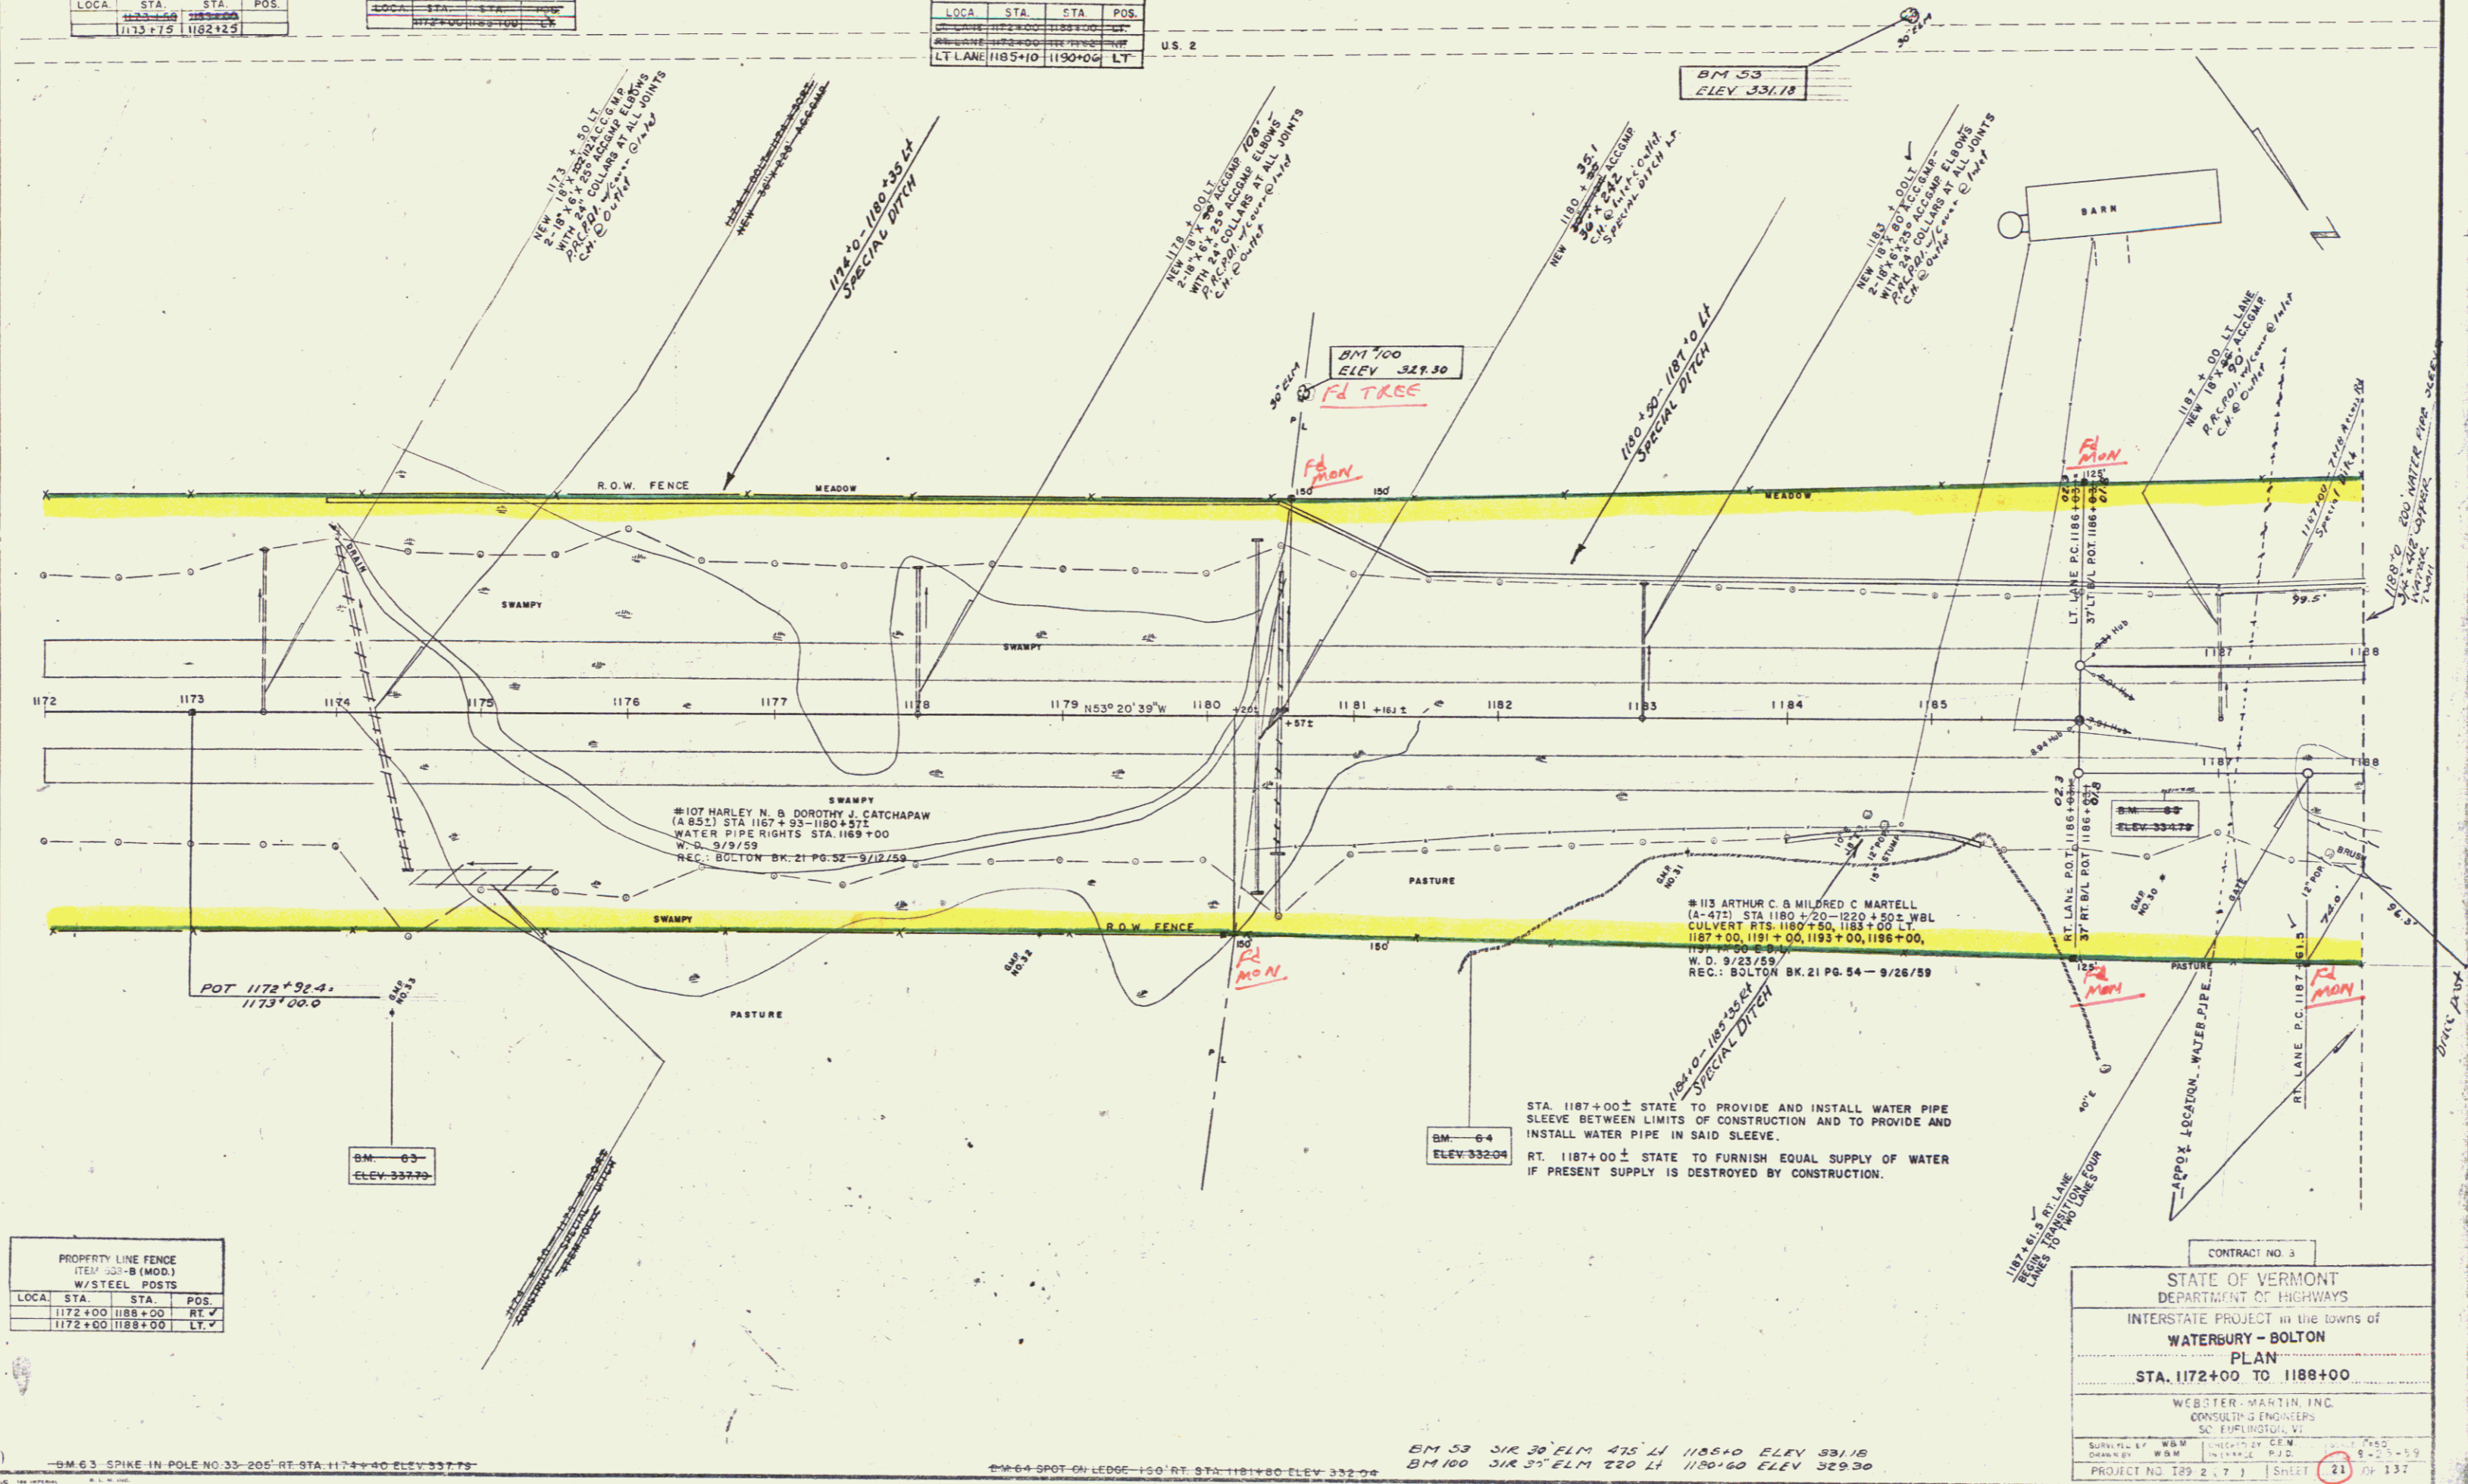

PROPERTY LINE FENCE (ITEM 32-B (MOD.)) W/STEEL POSTS			
LOCA	STA	STA	POS
1172+00	1188+00		RT ✓
1172+00	1188+00		LT ✓

CONTRACT NO. 3

STATE OF VERMONT
DEPARTMENT OF HIGHWAYS
INTERSTATE PROJECT in the towns of
WATERBURY - BOLTON
PLAN
STA. 1172+00 TO 1188+00

WEBSTER-MARTIN, INC.
CONSULTING ENGINEERS
50 EMBURY STREET
BURLINGTON, VT.

DESIGNED BY: WBM
CHECKED BY: WBM
DRAWN BY: WBM
DATE: 8-21-59
PROJECT NO. 129-2-7-3
SHEET 23 OF 137

BM 63 SPIKE IN POLE NO 33-205 RT STA 1174+00 ELEV 337.75

BM 64 SPOT ON LEDGE 150' RT STA 1181+80 ELEV 332.04

BM 53 312 30' ELM 475' LH 1185+00 ELEV 331.18
BM 100 312 30' ELM 220' LH 1185+60 ELEV 329.30