


CONCRETE SURFACE
 FROM 1871+00 TO 1872+00
 1871+00 TO 1872+00

Subbase of Sand Item 202
 1871+00 TO 1872+00

STONE FILL FOR SLOPE
 PROTECTION
 1871+00 TO 1872+00

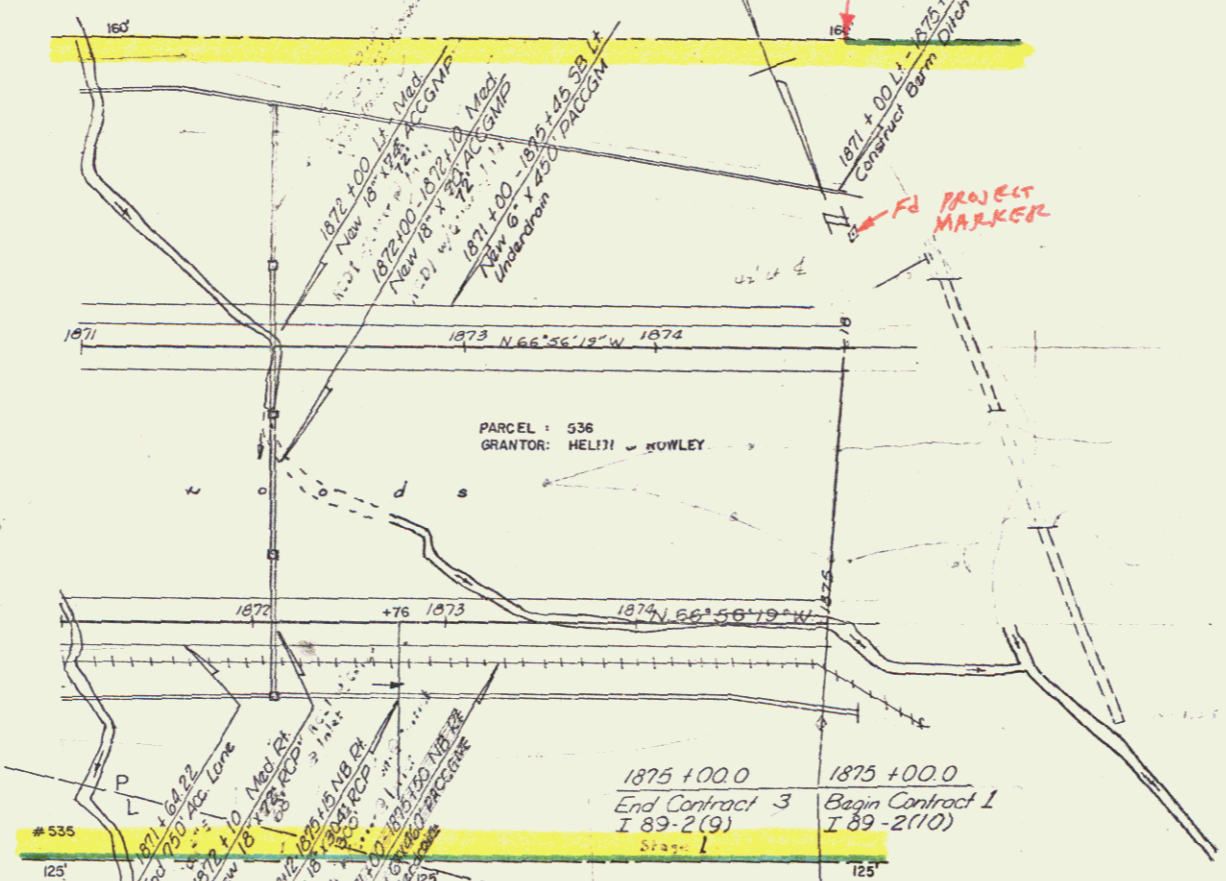


1875 +00.0
 End Contract 3
 I 89-2(9)
 Stage 1

1875 +00.0
 Begin Contract 1
 I 89-2(10)

Terminal Quantities
 Fill 100 cu yds NB
 Cut 100 cu yds SB

E.M. 182-A
 El. 373.52

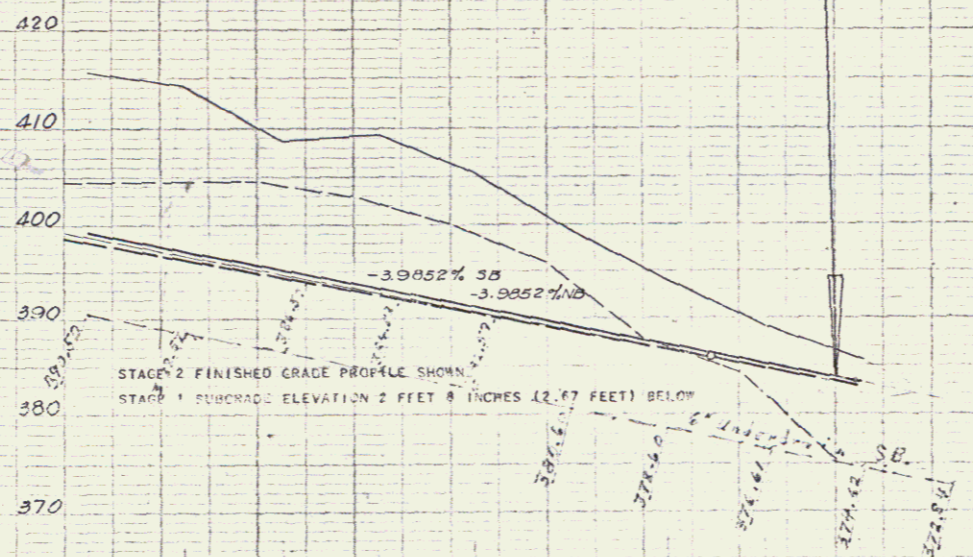

Southbound	1871	1872	1873	1874	1875
1871	450	450	450	450	450
Northbound	1871	1872	1873	1874	1875
1871	450	450	450	450	450

29
 WILLISTON
 1-89-2(4)
 Sheet 34
 Contract #3