

INDEX OF SHEETS

TITLE SHEET
DATA SHEET
SECTIONS (3' ELEVATION CONCRETE PAVEMENT)

TABLES
SINKING TABLES
GRADE & EXIT TERMINALS
DETAIL OF C&G RAIL
CURB DETAILS

12 D-3 TREATED GUTTERS
15 D-4 UNDERDRAIN FLUSHING
16 E-1 BARRICADES, SIGNS & LIGHTS FOR ROADWAYS
17 E-3 REGULATORY SIGNS (FOR TRAFFIC)
18 E-4 ROUTE & AUXILIARY SIGNS (FOR TRAFFIC)
19 E-6 REGULATORY, WARNING & GUIDE SIGNS (FOR TRAFFIC)
20 E-7 STANDARD SIGN PLACEMENT FOR TRAFFIC
21 E-8 DELINEATORS
22 E-9 CONSTRUCTION IDENTIFICATION SIGNS
23 G-1 STANDARD STEEL BEAM GUARD RAIL
24 G-3 THREE CABLE GUARD RAIL WITH STEEL POSTS
25 G-4 PLANK GUARD RAIL, GUIDE & MARKER POSTS
26 J-1 PROJECT & BOUNDARY MARKERS
27 E-5A SIGN POST FOOTINGS
28 BLANK
29-30 QUANTITY SHEETS
31-32 GRADE SHEETS
33-38 PLAN SHEETS
39-43 PROFILE SHEETS
44-48 PLAN SHEETS
49-55 PROFILE SHEETS
56-A-56-P TRAFFIC SIGNS
57-78 CROSS-SECTIONS (2023+50 - 2060+50)
79-89 CROSS-SECTIONS SHELBY INTERCHANGE A,B,C,D
90-101 CROSS-SECTIONS SHELBY CONNECTION E
102-115 CROSS-SECTIONS SHELBY CONNECTION F
116-130 CROSS-SECTIONS SHELBY CONNECTION G
131-138 CROSS-SECTIONS SHELBY CONNECTION H
139-141 CROSS-SECTIONS SHELBY CONNECTION I
142-153 CROSS-SECTIONS SOUTH BURLINGTON INTERCHANGE W
154-167 CROSS-SECTIONS SHELBY ROAD 16+339 - 23+000 A,B,D

PROJECT NAME & NUMBER TYPE PAVEMENT AREA
BURLINGTON-SO. 1-89-3(16) BITUMINOUS 29,333 S.Y.
BURLINGTON 1-189-3(17) CONCRETE 38,504 S.Y.

RECORD PLANS STAGE

MATERIALS
GRAVEL BACKFILL - CASEY PIT - VERMONT.
SUB BASE OF CRUSHED ROCK, CRUSHED STONE, SANDERS & PENETRANT
AGGREGATE CRUSHED STONE, BASE COURSE, JERRY-MILLISTON, VT.
RIS - DEMERS QUARRY - WINDOCK, VT.
SAND CUSHION - U.V.N. PIT & L-M PLOUGH PIT - BURLINGTON, VT.
ST. GELAIS PIT - COLCHES - ARMONT.
OUTBACK ASPH. & ASPH. CEMENT - TRIM JOINT BIT. - EVERETT, MASS.
TAR EMULSION FOR BRIDGE FLOORS - KOFFERS PROC. - VERET, MASS.
BITUMINOUS CONCRETE - L.M. PIKE & SON INC. - CHIA, N.H.
JOINT SEALER - HOT POURED ELASTIC TYPE - SERVICE - ROD CO. - CHICAGO, ILL.
CONCRETE CLASS "B" - ST. GRISWOLD & CO. INC. - NTON, VT.
REIN. STEEL, STEEL CABLE, BEAM & PILE - FISH - RAIL, STEEL GUIDE &
MARKER POSTS - BETHLEHEM STEEL CO. - PETH - PA
ASPH. GID. CORR. GALV. MET. PIPE & ELBOWS, C.I.P. - TERRAIN FLUSHING
DRAINAGE - NEW ENGLAND METAL PIPE CO. - WHITE - JUNCTION, VT.
STEEL DROP INLET GRATES - VERMONT STRUCTURAL - CORP. - BURLINGTON, VT.
GRANITE SLOPE EDGING - BARRETT TO GRANITE CO. - RD, N.H.
TRAFFIC SIGNS - STANDARD SIGNS & SIGNAL CO. - CL - MASS.
OVERHEAD TRAFFIC SIGN SUPPORTS - PLANET CORP. - NG, MICH.
DELINEATORS - ELIZABETH DIV. ELASTIC SHOP - NAT - F AMERICA - ELIZ, N.J.
SEEDING (SLOPES) - JOHN D. LYONS - CAMBRIDGE - S.
COMMERCIAL FERTILIZER - BURLINGTON RENDERING - BURLINGTON, VT.
CONTRACTOR - THE LAF CONSTRUCTION CORP. - C
MERIDIAN CON. - SEPTEMBER 28, 1961
RESIDENT ENGINEER - DONALD H. REMICK - APRIL 19, 1962
INSPECTORS - J. STEARNS, WAYNE JARVIS, A. - D-NOV. 29, 1962
ELWOOD, G. - A. - NOVEMBER 29, 1962
RECORD PLANS - JAMES W. STEARNS.

CONVENTIONAL SIGNS

R.O.W. FENCE
COUNTY LINE
FENCE LINE
STONE WALL
UNFENCED PROPERTY
GUARD RAIL
TRAVELED WAY
DRAINAGE
POWER POLE
TELEPHONE POLE
TREES
MIDGE

STAGE 2 CONSTRUCTION
BURLINGTON-SO. BURLINGTON 1-89-3(16) & 1-189-3(17)
CONTR. - THE LAF CONSTRUCTION CORP. - MERIDEN, CONN.
RECORD PLANS - JAMES W. STEARNS.
CONST. COMPLETED - NOVEMBER 1962

ELEVATION DATUM
ELEVATION DATUM
CURVE DATA
OF ANGLE
OF CURVE
OF CURVE
DISTANCE
OF CURVE
TANGENT
INTERSECTION
CURVE
TANGENT

STATE OF VERMONT
DEPARTMENT OF HIGHWAYS
PROPOSED IMPROVEMENT

CITY OF BURLINGTON - TOWN OF SO. BURLINGTON
COUNTY OF CHITTENDEN

PROJECT I-89-3(16) STAGE 2
BEGINNING AT A POINT IN SOUTH BURLINGTON 2.268 MILES WEST OF THE WILLISTON-SOUTH BURLINGTON TOWN LINE AT MUDDY BROOK AND EXTENDING NORTHERLY FOR A DISTANCE OF 1.042 MILES.
LENGTH OF ROADWAY 5,327.96 FEET or 1.009 MILES
LENGTH OF BRIDGES 172.04 FEET or 0.033 MILE
LENGTH OF PROJECT 5,500.00 FEET or 1.042 MILES



DESIGN DESIGNATION

ADT 1959	4530
ADT 1975	14340
DHV	2075
D	5%
V	70 MPH

PROJECT I-189-3(17) STAGE 2 (Construction #4)
BEGINNING AT A POINT APPROXIMATELY 0.217 MILE WEST OF THE CITY OF BURLINGTON AND THE TOWN OF SOUTH BURLINGTON TOWN LINE ON U.S. ROUTE 7 AND EXTENDING EASTERLY 1.367 MILES.
LENGTH OF ROADWAY 6,871.45 FEET or 1.301 MILES
LENGTH OF BRIDGES 348.00 FEET or 0.066 MILE
LENGTH OF PROJECT 7,219.45 FEET or 1.367 MILES

DESIGN DESIGNATION

ADT 1959	4450
ADT 1975	8550
DHV	1250
D	5%
V	60 MPH

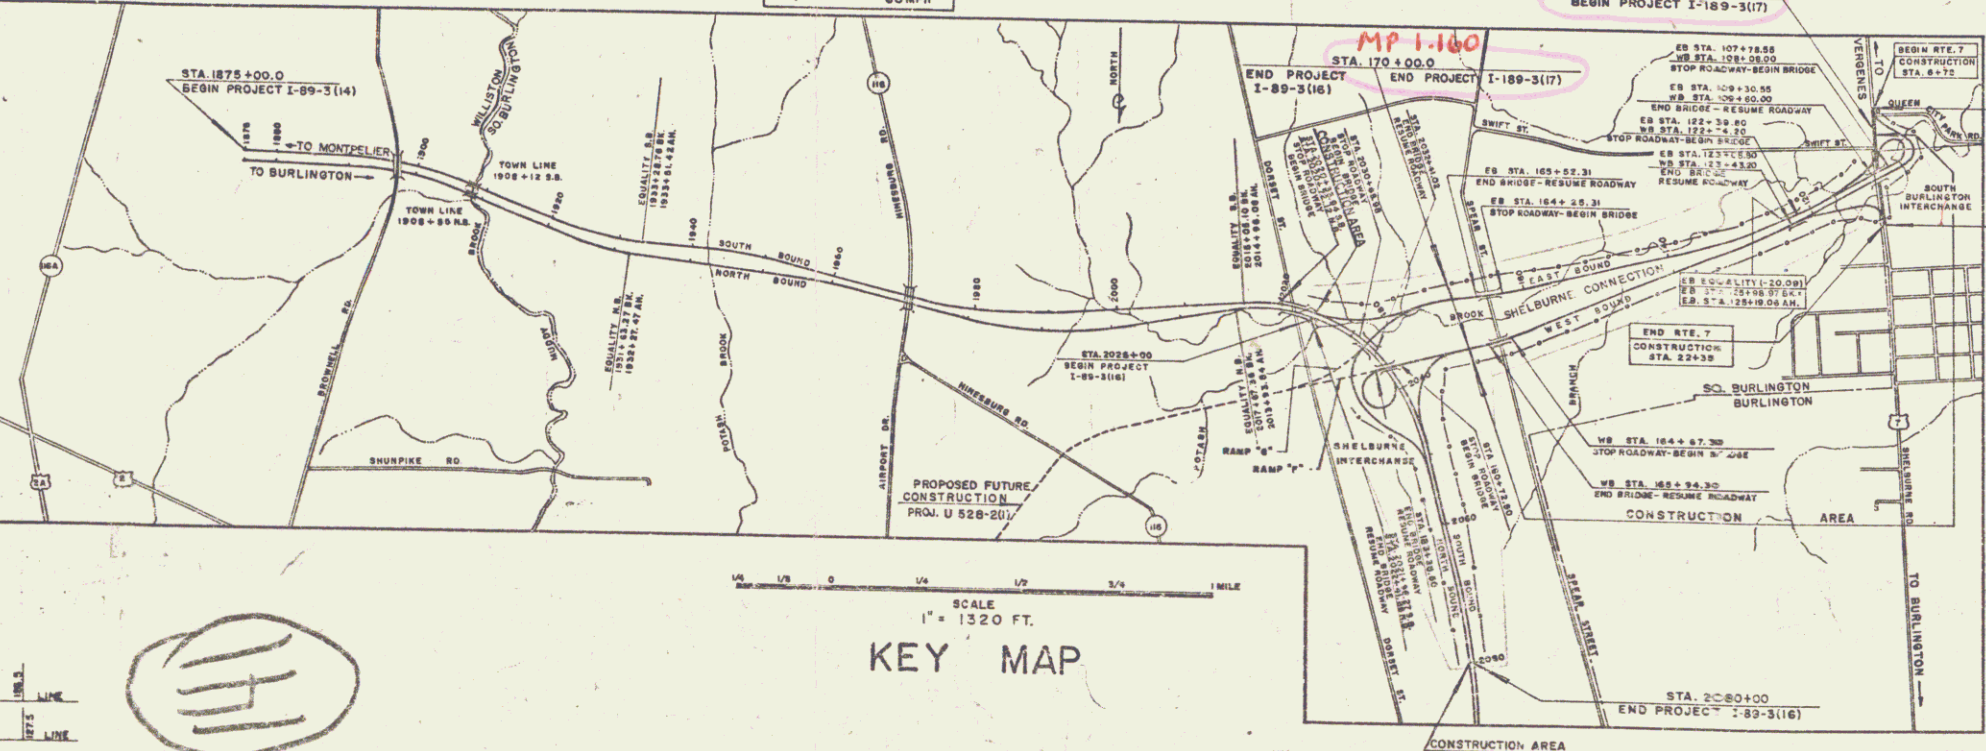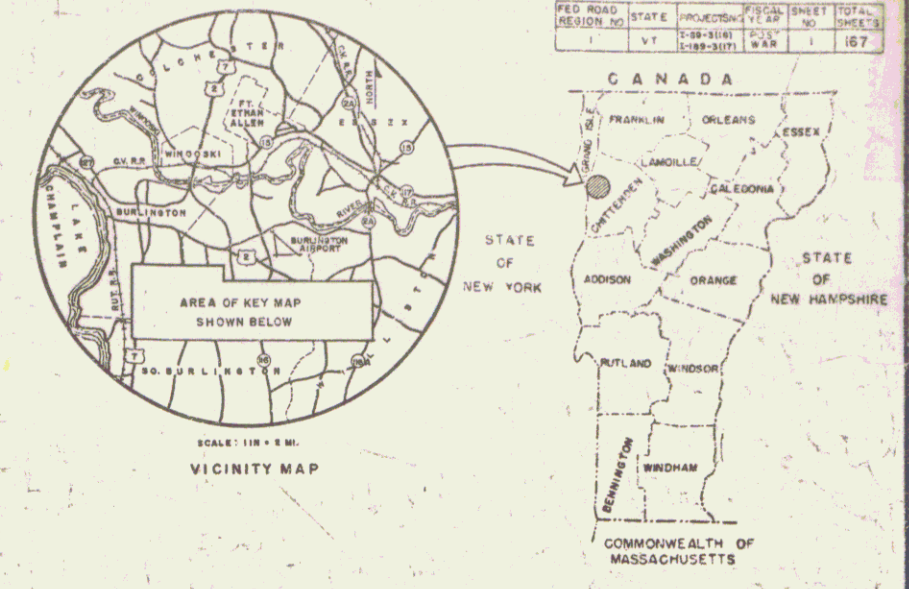

SCALES

TITLE	1" = 1320 FT.
TYPICAL	1" = As Shown
PLAN	1" = 30 FT.
PROFILE HORIZONTAL	1" = 50 FT.
PROFILE VERTICAL	1" = 10 FT.
CROSS-SECTIONS	1" = 10' or 5'

THESE PLANS ARE SUBJECT TO SUCH REVISIONS AS MAY BE REQUIRED BY THE BUREAU OF PUBLIC ROADS OR THE COMMISSIONER OF HIGHWAYS.
CONSTRUCTION IS TO BE CARRIED ON IN ACCORDANCE WITH THE PLANS AND THE STANDARD SPECIFICATIONS FOR HIGHWAY AND BRIDGE CONSTRUCTION OF JANUARY 1955 SUBMITTED TO THE BUREAU OF PUBLIC ROADS AS APPROVED JULY 5, 1956, INCLUDING ALL SUBSEQUENT APPROVED REVISIONS AND SUCH REVISED SPECIFICATIONS AND SPECIAL PROVISIONS AS ARE SUBMITTED WITH THE PLANS.

APPROVED SECONDARY ENGINEER DATE	APPROVED CONSTRUCTION ENGINEER DATE July 14, 1961	APPROVED BRIDGE ENGINEER DATE July 17, 1961	APPROVED DISTRICT ENGINEER DATE July 19, 1961	APPROVED HIGHWAY ENGINEER DATE July 13, 1961	APPROVED DATE July 12, 1961
--	---	---	---	--	--------------------------------

STAGE 2 CONSTRUCTION

DEPARTMENT OF COMMERCE
BUREAU OF PUBLIC ROADS

APPROVED

DIVISION ENGINEER DATE

PROJECT I NO. 189-3(17)

SHEET D OF 167 SHEETS

Pin # 99202D
Project I-189-3(17)
Route I-189