
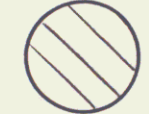


RIGHT-OF-WAY DIVISION
TOWN FILE
PERPETUAL
Town of _____
(To Be Returned To R.O.W. Division)

See STP Bike (6) S.P.# 92K294
Renewed 8/3/95 (BK 381, Pg 501-505)
expires 4/27/2005

 Sold to City of SB
12/19/1999 BK 466 pg 28
LEASED AREA to City of So. Burlington,
Lessee 4/28/85 to 4/27/95

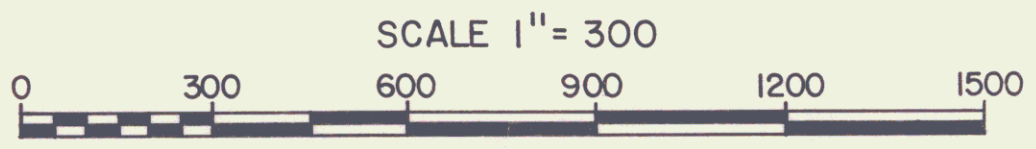

REF I 189-3(11) SHEETS 14-17 OF 200

STATE OF VERMONT
AGENCY OF TRANSPORTATION

Sheet 13C

CITY OF SOUTH BURLINGTON

APPROX. SCALE 1" = 300'	DATE 3-11-82	DRAWN BY FJM
-------------------------	--------------	--------------