

CHAIN LINK FENCE (ALUMINUM)
ITEM 590-A
(6' HIGH)
STA. 21+35 TO 29+00 RAMP 'D' RT. - 745'
STA. 15+00 TO 16+50 RAMP 'C' RT. - 210'
955'

STANDARD STEEL BEAM GUARD RAIL
ITEM 547-A
STA. 119+95 TO 120+55 W.B. LT. & RT.
(OVERHEAD SIGN LOCATION)

GRANITE SLOPE EDGING
ITEM-556 A
RAMP 'D' BULLNOSE STA 23+94 LT.

THREE CABLE GUARD RAIL WITH
STEEL POSTS - ITEM 543
119+00
STA. 115+00 TO 117+50 W.B. LT.
RAMP 'C' STA. 14+96 TO 18+00 RT.
RAMP 'D' STA. 25+52 TO 29+00 RT. 24+49-28+00 RT.
RAMP 'D' STA. 26+50 TO 29+00 LT.
STA. 118+00 TO 119+60 E.B. RT.
12+25 - 122+49 W.B. LT.
124+00 - 124+56 W.B. LT.
121+40 - 121+97 E.B. RT.
123+41 - 123+65 E.B. RT.

* STAGE 2
316 CODE
PLANTING TREES, SHRUBS AND
VINES - ITEM 601
SEE SHADED AREAS AND
QUANTITY SHEET
BITUMINOUS CONCRETE CURB - ITEM 555


PAVED DITCH ITEM 361-B
STA. 118+73 TO 119+27 MED.
STA. 124+77 TO 125+02' MED.
STA. 129+02' TO 129+27' MED.
115+0-118+50 LT. W.B.
118+0 W.B. LT.
122+40 W.B. LT.
128+35-129+25 W.B. LT.
118+0-119+50 E.B. RT.
121+50-122+00 E.B. LT.
122+0 RT. E.B.
Ramp C 16+0-17+0 RT.
Ramp D 28+90-27+0 RT.
128+0-129+15 E.B. RT.

FED. ROAD DIV. NO.	STATE	FEDERAL PROJECT NO.	SHEET	TOTAL SHEETS
1	VERMONT	1-189-3(III)	14	210

PROPERTY LINE FENCE WITH STEEL POSTS
ITEM 583-B
STA. 117+00 TO 121+35 E.B. RT. - 465'
STA. 122+25 TO 131+00 E.B. RT. - 845'
STA. 123+55 TO 131+00 W.B. LT. - 750'
2060'

SHEET 13
CHAIN LINK FENCE (ALUMINUM)
ITEM 590-A
(6' HIGH)
STA. 6+43 TO 8+18 SHELburne RD. LT. - 266'
STA. 8+32 TO 10+75 SHELburne RD. LT. - 256'
STA. 95+77 TO 108+88 RAMP 'A' LT. - 1427'
STA. 29+00 TO 34+66 RAMP 'D' RT. - 518'
STA. 84+40 TO 15+00 RAMP 'C' RT. - 660'
3127'

PLAN	REVISIONS	DATE	BY
1	1		
2	2		
3	3		
4	4		
5	5		

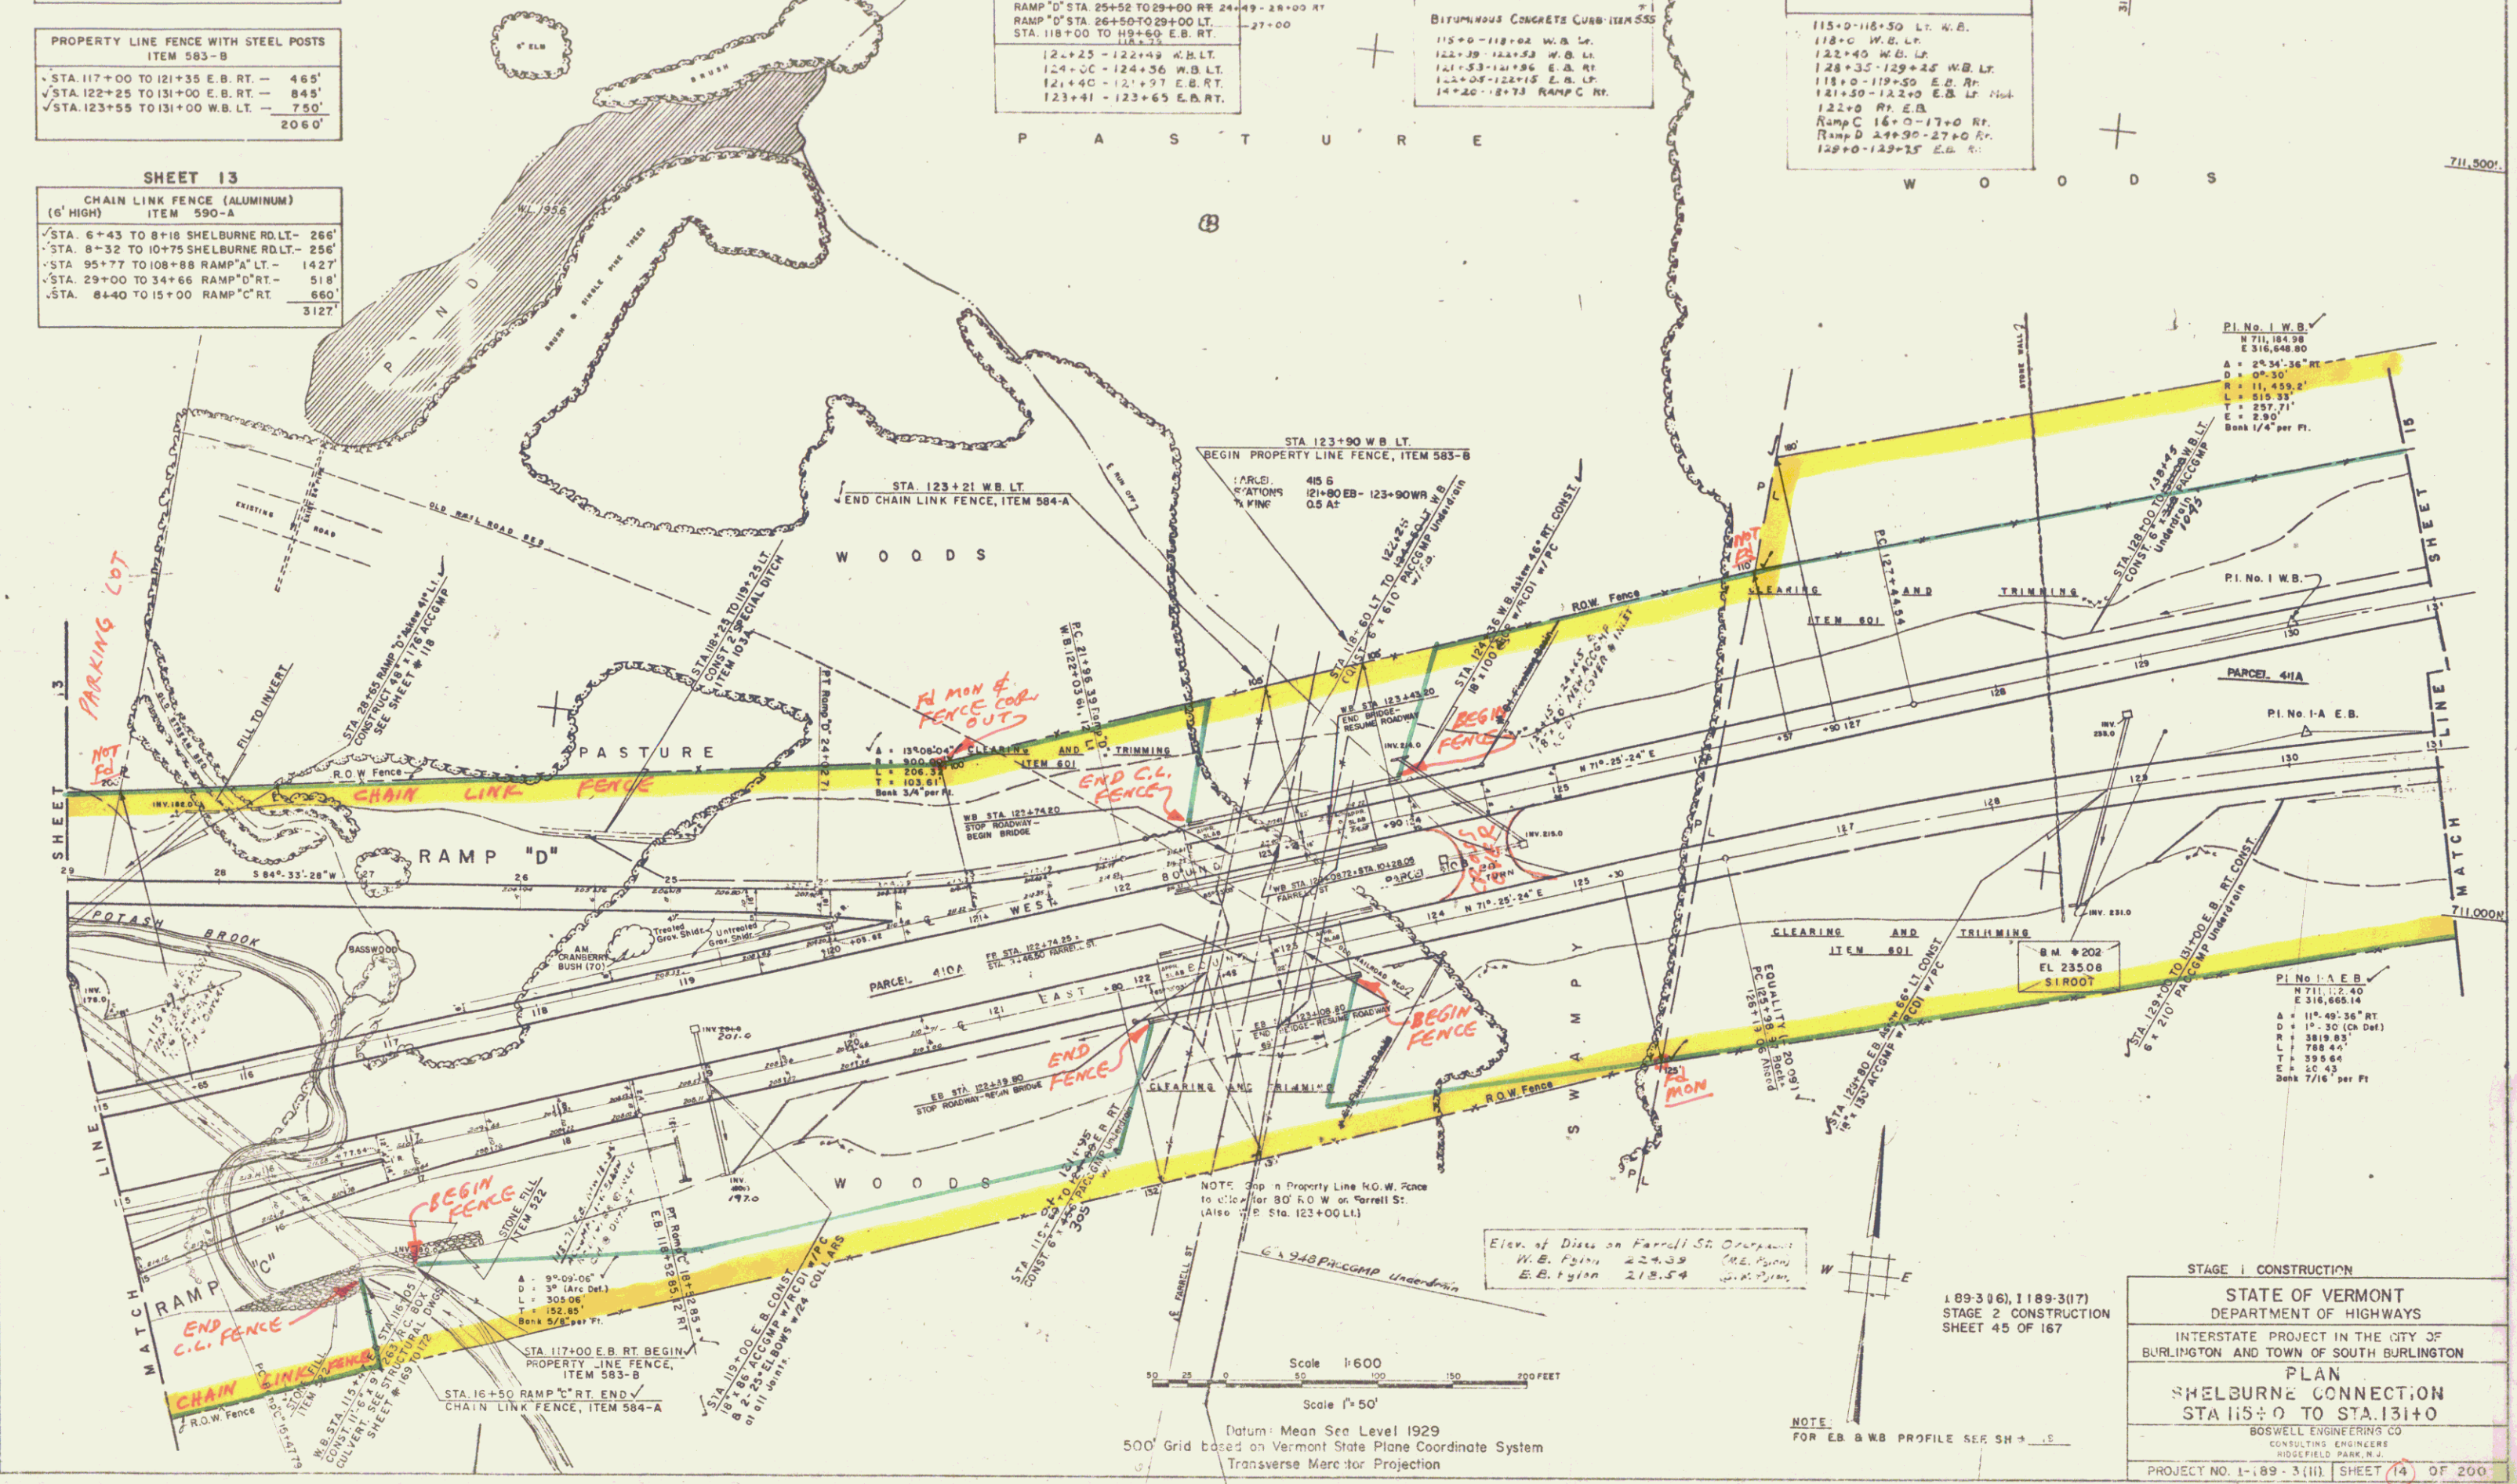

NOTE: Top of Property Line (G.W. Pins to 1/16" for 80' R.O.W. or Farrell St. (Also for Sta. 123+00 LT.))

Elev. of Ditch on Farrell St. Overlain
W.B. Point 224.39 (NE. 1/4)
E.B. Point 218.54 (SW. 1/4)

Scale 1"=600'
Scale 1"=50'
Datum: Mean Sea Level 1929
500' Grid based on Vermont State Plane Coordinate System
Transverse Mercator Projection

189-3(6), 1189-3(7)
STAGE 2 CONSTRUCTION
SHEET 45 OF 167

STAGE 1 CONSTRUCTION

STATE OF VERMONT
DEPARTMENT OF HIGHWAYS

INTERSTATE PROJECT IN THE CITY OF
BURLINGTON AND TOWN OF SOUTH BURLINGTON

PLAN
SHELburne CONNECTION
STA 115+0 TO STA 131+0

BOSTWELL ENGINEERING CO.
CONSULTING ENGINEERS
MIDDLEFIELD PARK, N.J.

PROJECT NO. 1-189-3(III) SHEET 14 OF 200

118