


DATE	
BY	
REVISIONS	
1. CHECKED	
2. APPROVED	
3. FIELD CHECKED	
4. TOLERANCE	

FED. ROAD DIST. NO.	STATE	FEDERAL PROJECT NO.	SHEET	TOTAL SHEETS
1	VERMONT	1-89-3(4)	6	160

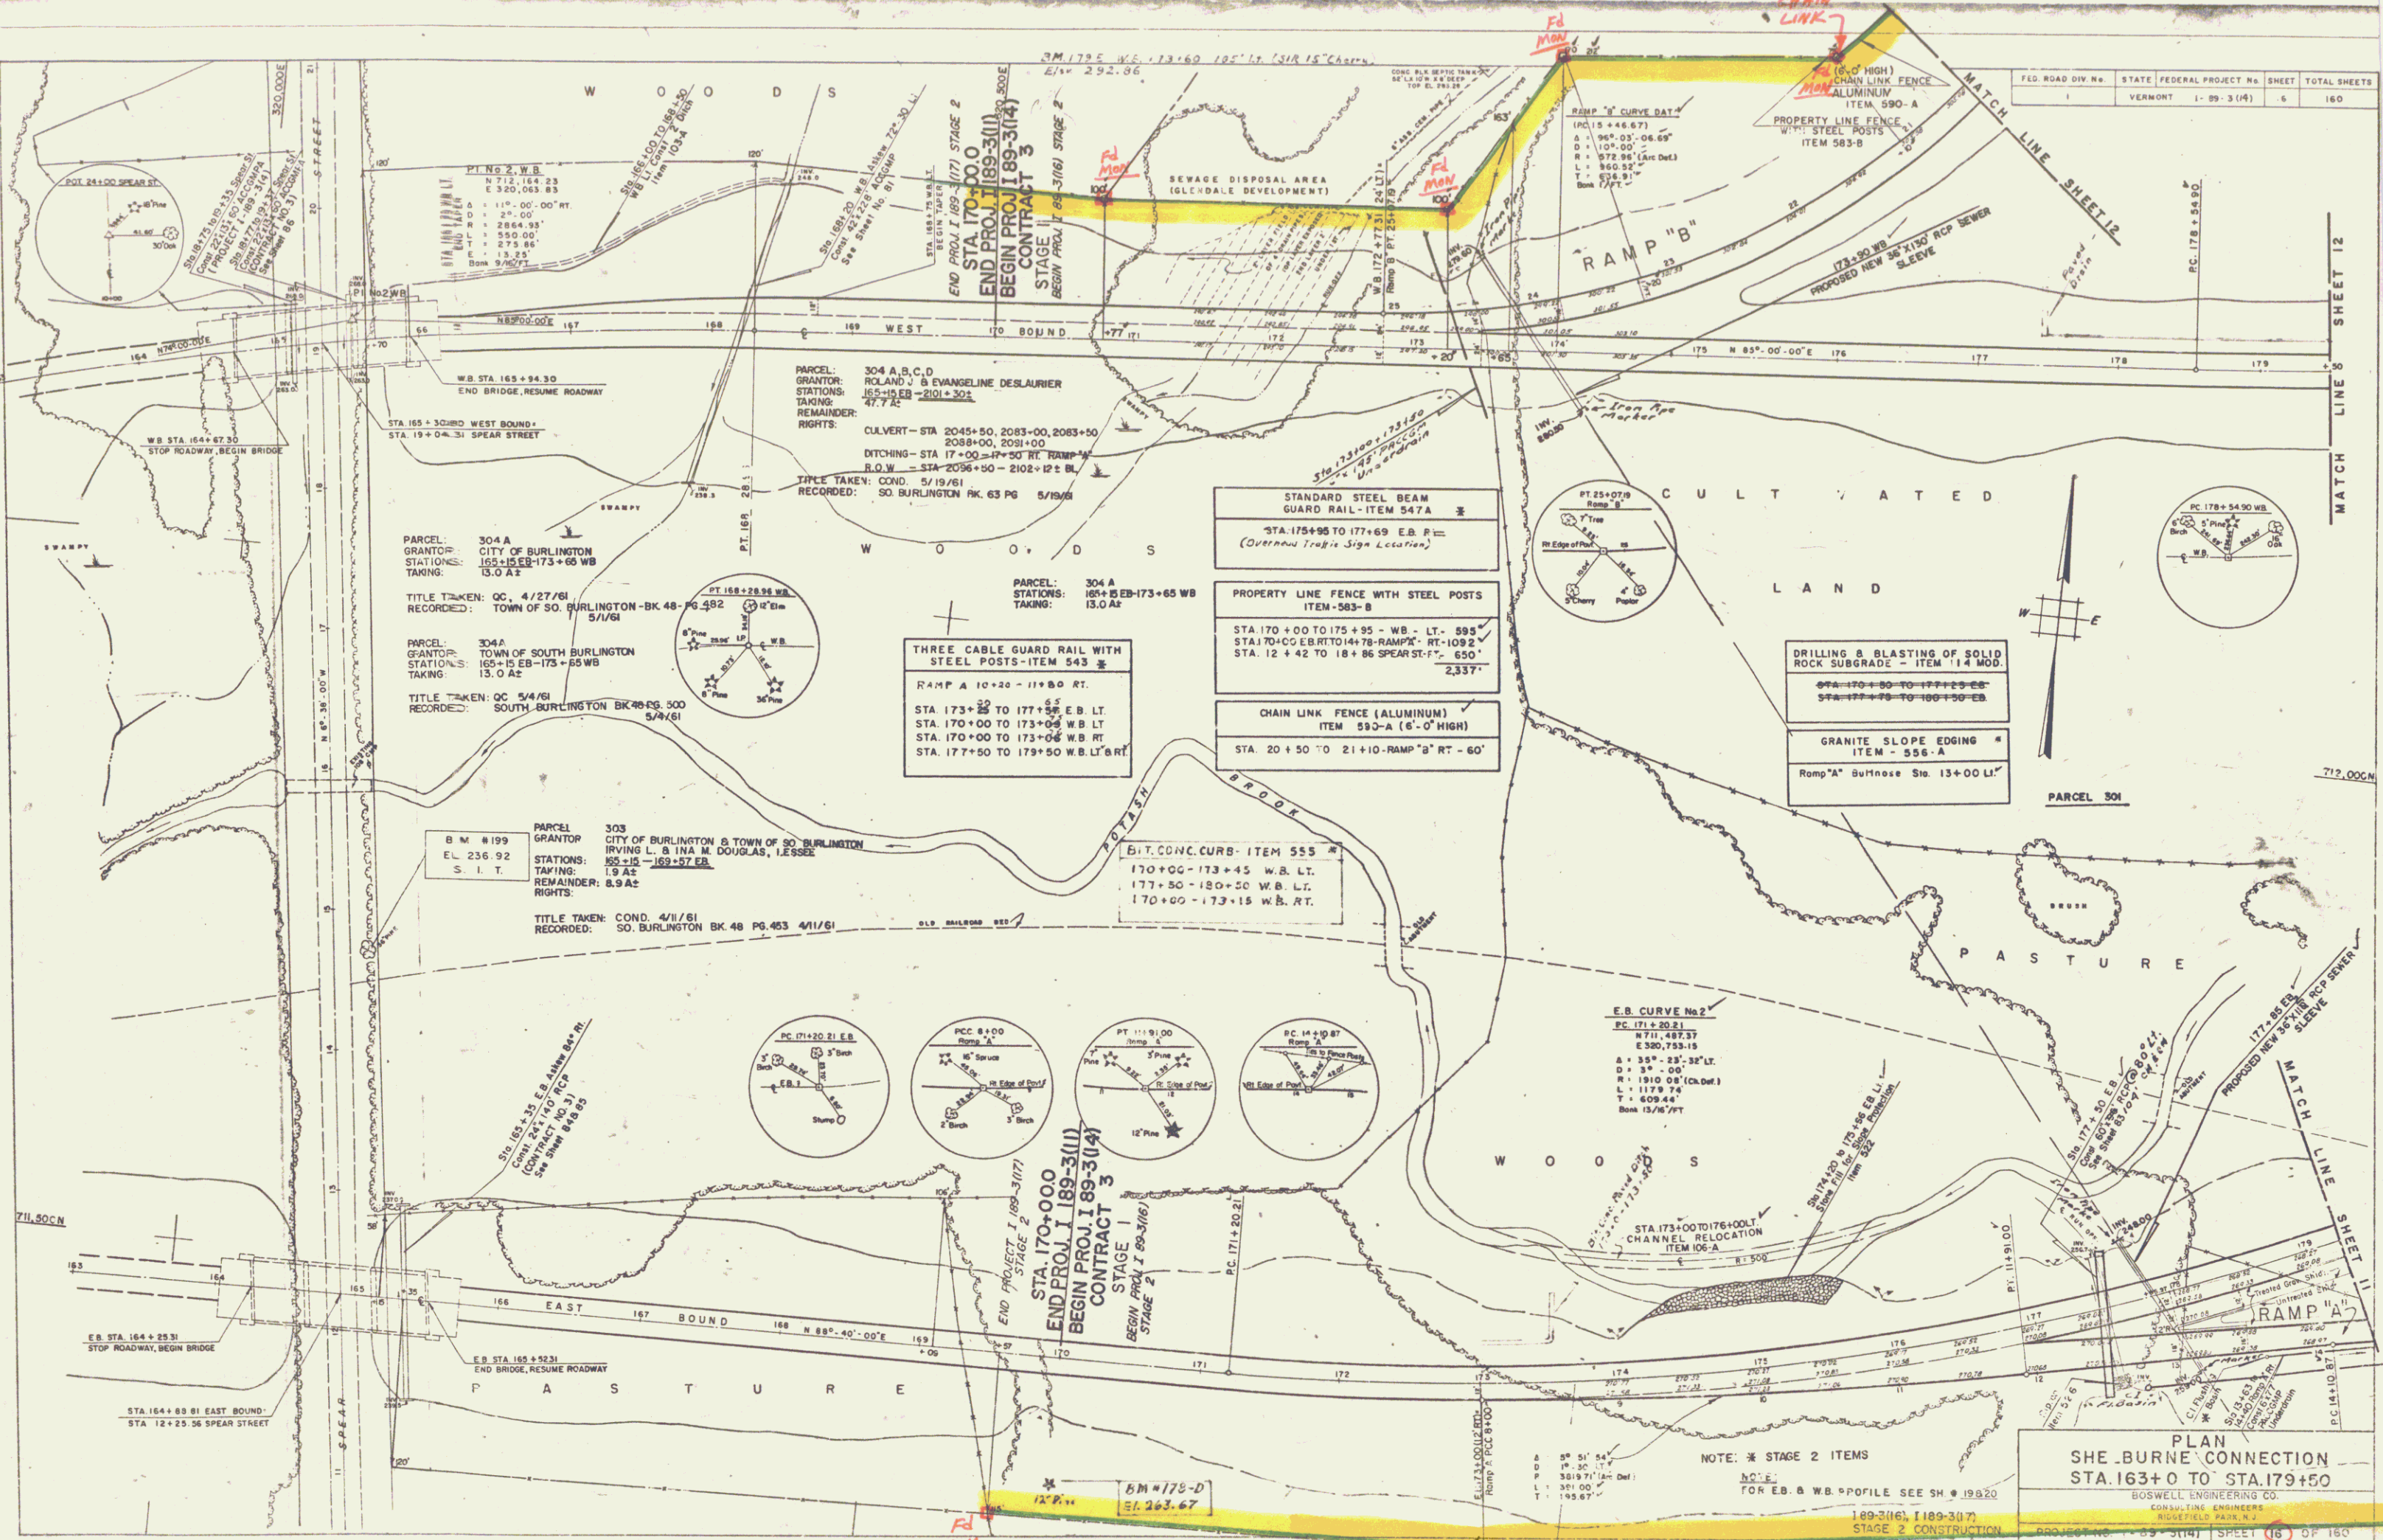

END PROJECT I 189-3(1/1) STAGE 2
 STA. 170+00.0
 END PROJ. I 189-3(1/1)
 BEGIN PROJ. I 89-3(1/4)
 CONTRACT 3
 STAGE 1
 BEGIN PROJ. I 89-3(1/6) STAGE 2

PARCEL: 304 A
 GRANTOR: CITY OF BURLINGTON
 STATIONS: 165+15 EB-173+65 WB
 TAKING: 13.0 AC
 TITLE TAKEN: COND. 4/27/61
 RECORDED: TOWN OF SO. BURLINGTON BK 48 PG 482 5/1/61

PARCEL: 304 A, B, C, D
 GRANTOR: ROLAND J. & EMANUELE DESLAURIER
 STATIONS: 165+15 EB-201+30 E
 TAKING: 47.7 AC
 REMAINDER:
 RIGHTS: CULVERT - STA 2045+50, 2083+00, 2083+00
 2088+00, 2091+00
 DITCHING - STA 17+00 - 17+50 RT RAMP "A"
 R.O.W. - STA 2056+50 - 2102+12 E
 TITLE TAKEN: COND. 5/19/61
 RECORDED: SO. BURLINGTON BK 63 PG 61/61

PARCEL: 303
 GRANTOR: CITY OF BURLINGTON & TOWN OF SO. BURLINGTON
 IRVING L. & INA M. DOUGLAS, LESSEES
 STATIONS: 165+15 EB-169+57 EB
 TAKING: 1.9 AC
 REMAINDER: 8.9 AC
 RIGHTS:
 TITLE TAKEN: COND. 4/1/61
 RECORDED: SO. BURLINGTON BK 48 PG 483 4/1/61

STANDARD STEEL BEAM
 GUARD RAIL - ITEM 547 A
 STA. 175+95 TO 177+69 E.B. RT.
 (Overhaul Traffic Sign Location)

PROPERTY LINE FENCE WITH STEEL POSTS
 ITEM - 583-B
 STA. 170+00 TO 173+95 W.B. LT. - 898'
 STA. 170+00 TO 173+06 W.B. LT. - 1092'
 STA. 12+42 TO 18+86 SPEAR ST. - 650'
 2,337'

CHAIN LINK FENCE (ALUMINUM)
 ITEM - 590-A (6'-0" HIGH)
 STA. 20+50 TO 21+10 RAMP "B" RT - 60'

DRILLING & BLASTING OF SOLID
 ROCK SUBGRADE - ITEM 114 M03
 STA. 170+00 TO 177+00 EB
 STA. 170+00 TO 180+00 EB

GRANITE SLOPE EDGING
 ITEM - 558-A
 Ramp "A" Surface Sta. 13+00 LI'

END PROJECT I 189-3(1/1) STAGE 2
 STA. 170+00.0
 END PROJ. I 189-3(1/1)
 BEGIN PROJ. I 89-3(1/4)
 CONTRACT 3
 STAGE 1
 BEGIN PROJ. I 89-3(1/6) STAGE 2

E.B. CURVE No 2
 PC (171+20.2)
 PVI (171+48.37)
 E (171+48.37)
 A = 35° - 25' - 35" LT.
 D = 35' - 00"
 R = 1510.08' (Cl. Def.)
 L = 1179.78'
 T = 609.44'
 Bch = 13.76'/PT

NOTE: * STAGE 2 ITEMS
 FOR E.B. & W.B. PROFILE SEE SH 9 19820
 189-3(1/6) 189-3(1/7)
 STAGE 2 CONSTRUCTION
 SHEET 38 OF 167

PLAN
 SHE. BURNE CONNECTION
 STA. 163+00 TO STA. 179+50
 BOSWELL ENGINEERS CO.
 CONSULTING ENGINEERS
 WINDFELDER PARK, N.Y.