



BITUMINOUS CONCRETE SIDEWALK
Lt
229+60-233+00

GRANITE CURB
Lt
229+60-233+00

GRANITE SLOPE EDGING
E
230+08-232+78

THREE CABLE GUARD RAIL
WITH STEEL POSTS
Lt
230+78-231+90
230+86-231+82
234+54-235+66

MUCK EXCAVATION
231+00-232+00
232+00-236+00

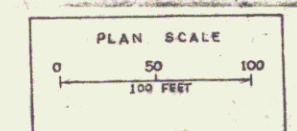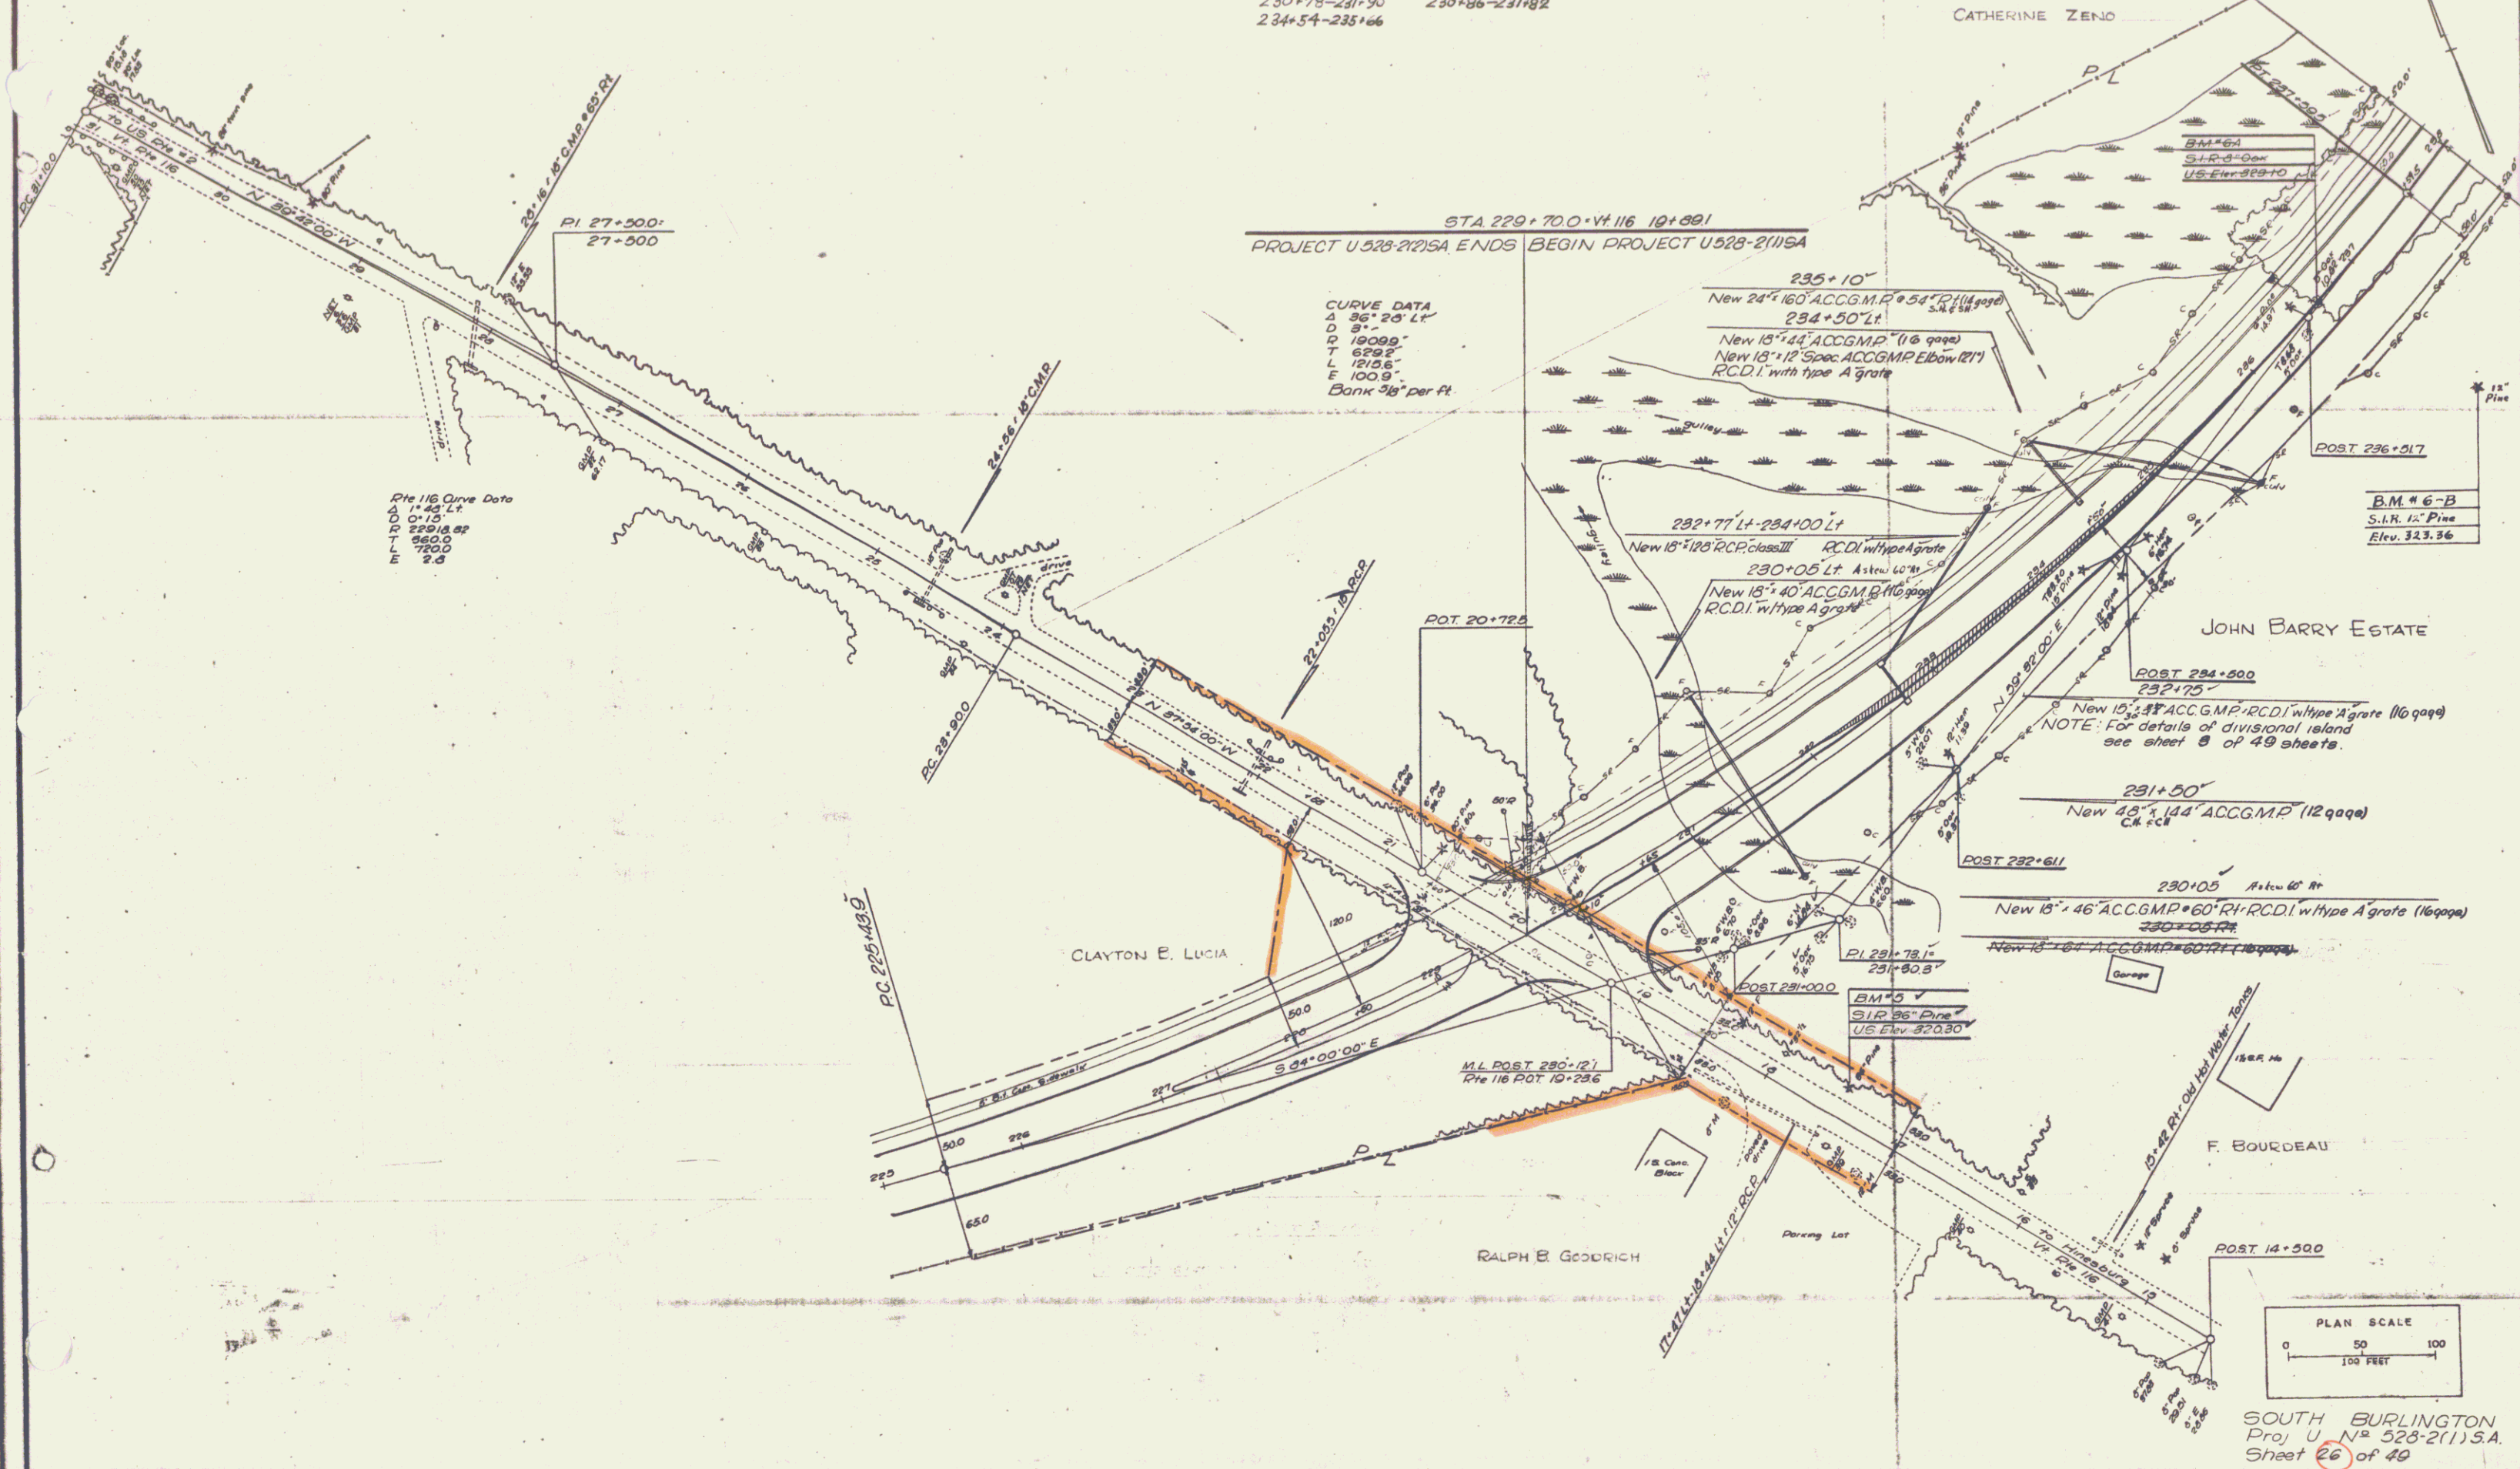

SOUTH BURLINGTON
Proj U. N^o 528-2(1) S.A.
Sheet 26 of 49