


DATE	BY
REVISED	CHECKED
DATE	BY
DATE	BY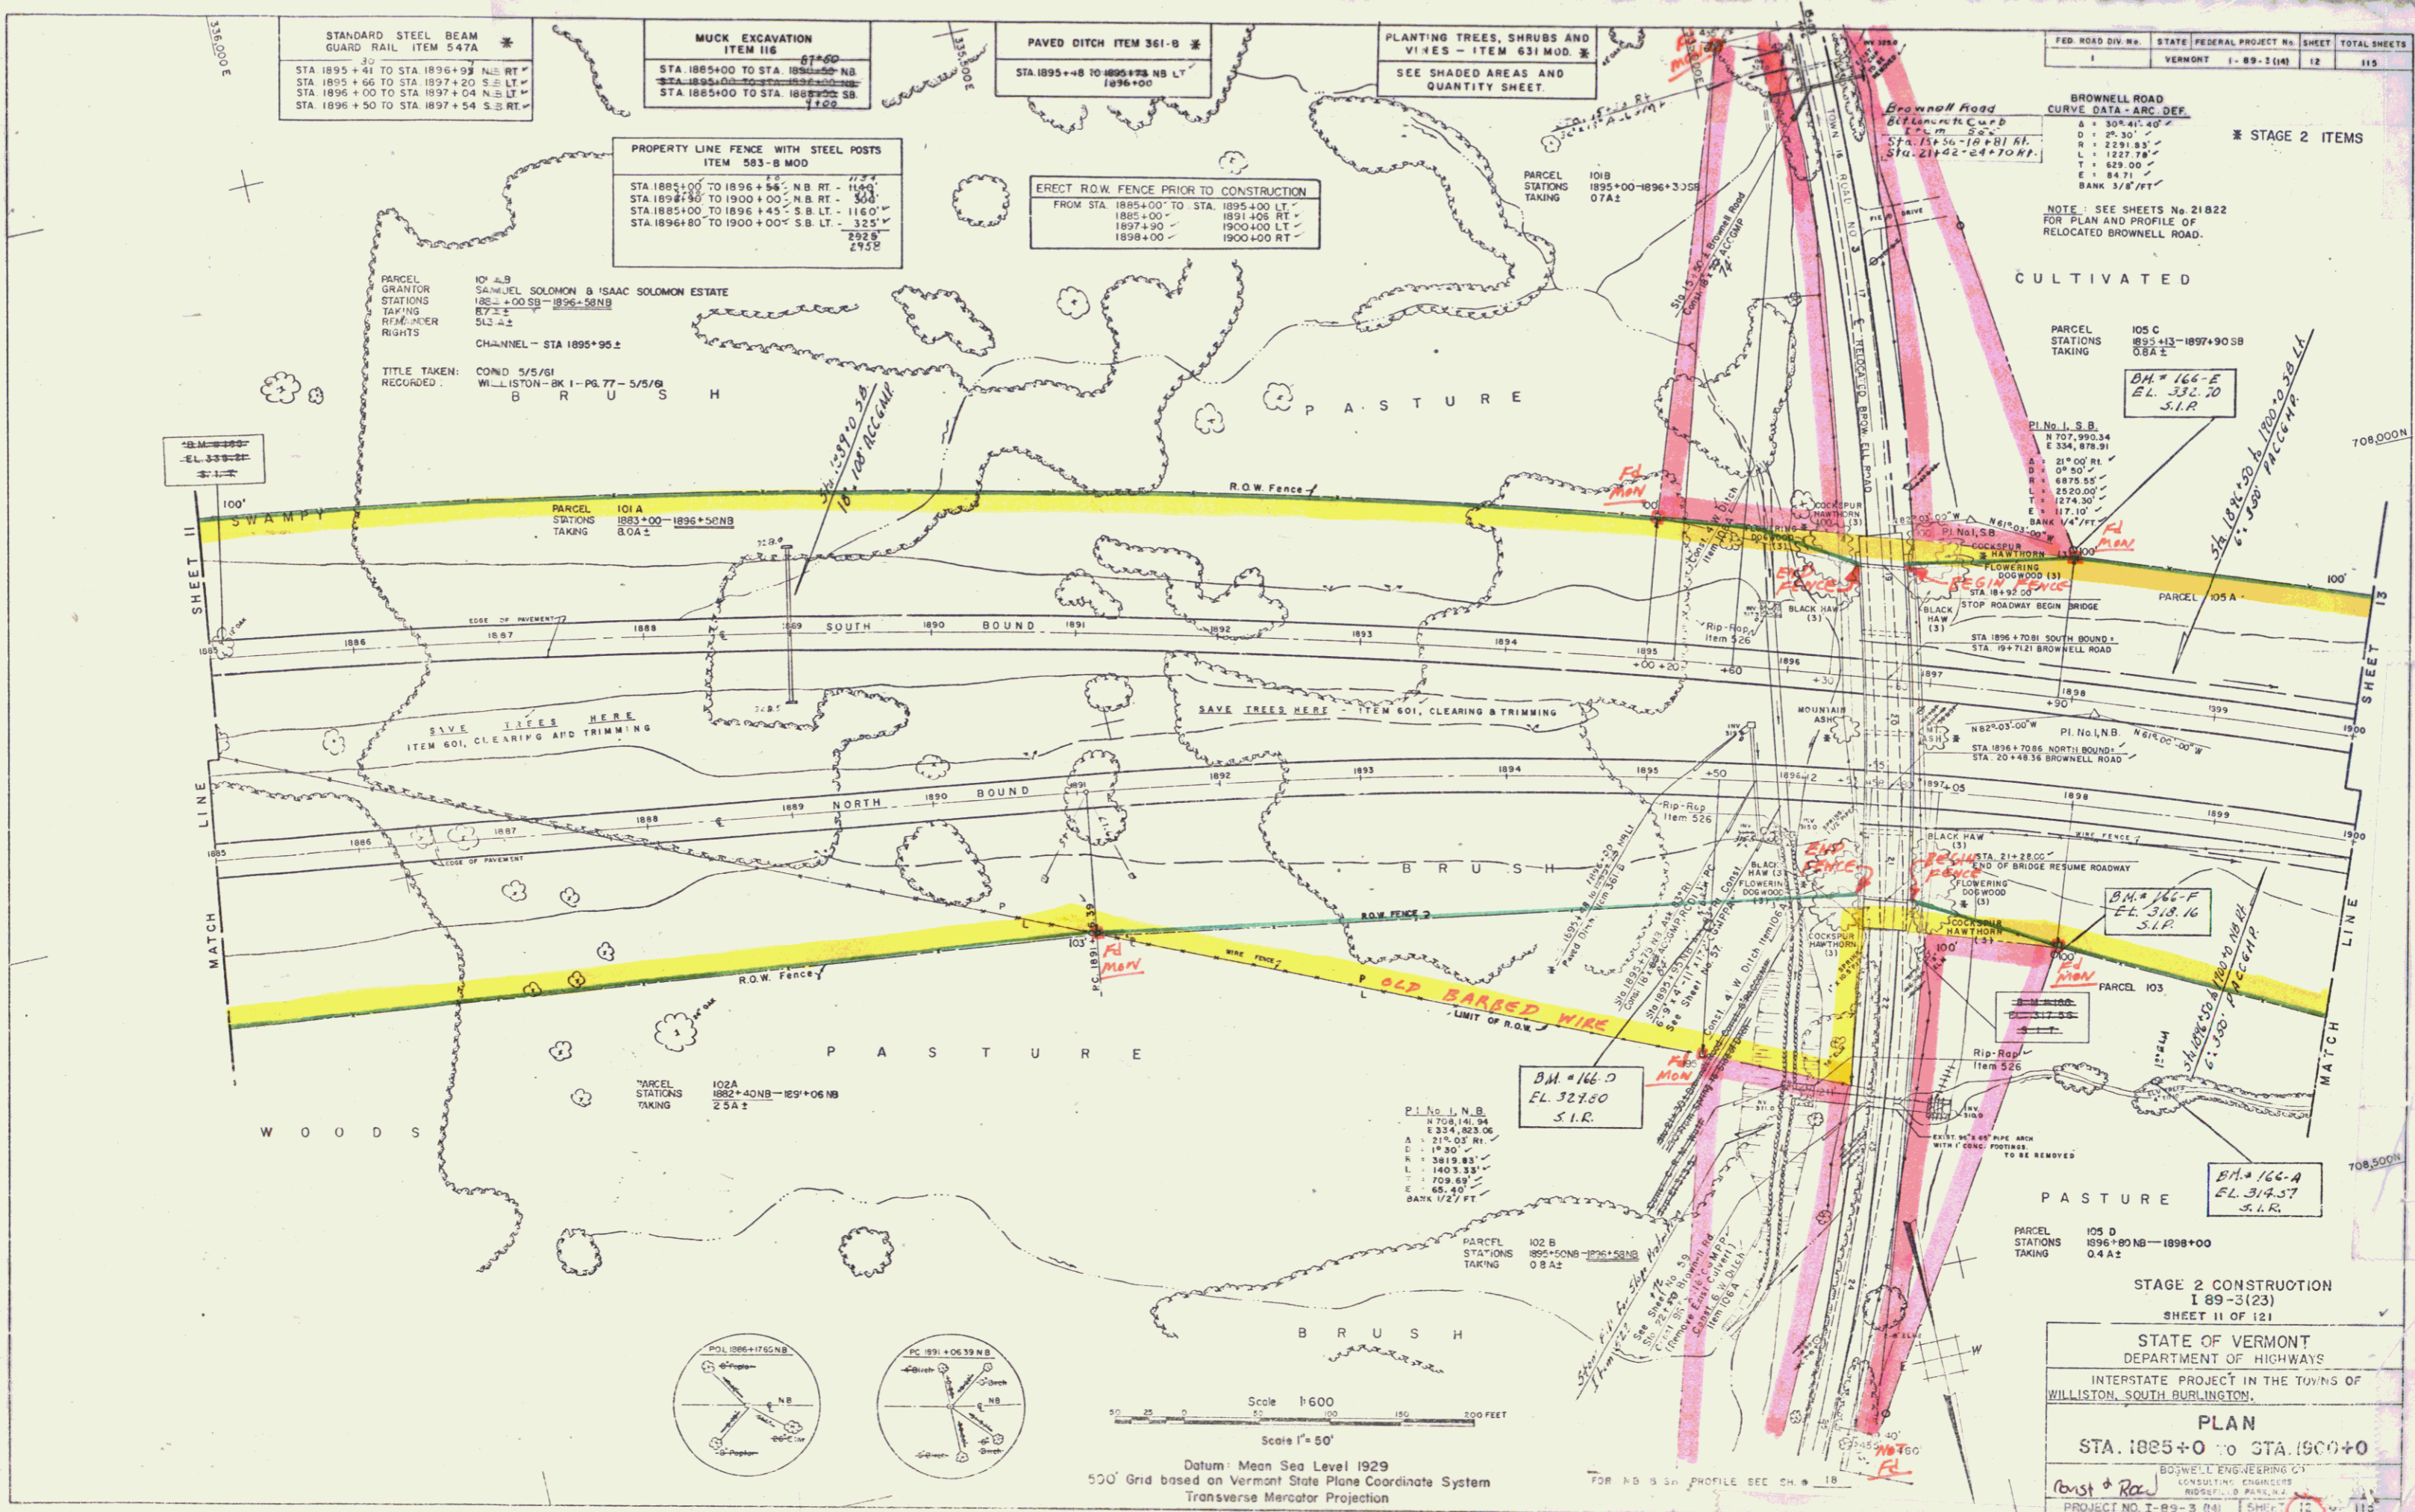
FED. ROAD DIV. NO.	STATE	FEDERAL PROJECT NO.	SHEET	TOTAL SHEETS
1	VERMONT	I-89-3(23)	12	115

BROWNELL ROAD
 CURVE DATA - ARC DEF
 A = 30° 41' 40"
 D = 25.30'
 E = 2391.85'
 L = 1227.78'
 T = 629.00'
 E = 84.71'
 BANK 3/8'/FT

NOTE - SEE SHEETS No 21822 FOR PLAN AND PROFILE OF RELOCATED BROWNELL ROAD.

CULTIVATED

PARCEL STATIONS TAKING 105 C 1895+13-1897+90 SB 08A Z

PL No. I, S.B.
 N 107° 59' 34"
 E 334.876 34'
 S 21° 00' 00"
 R = 4875.55'
 L = 2520.00'
 T = 274.30'
 E = 17.10'

PL No. I, S.B.
 N 107° 59' 34"
 E 334.876 34'
 S 21° 00' 00"
 R = 4875.55'
 L = 2520.00'
 T = 274.30'
 E = 17.10'

PL No. I, S.B.
 N 107° 59' 34"
 E 334.876 34'
 S 21° 00' 00"
 R = 4875.55'
 L = 2520.00'
 T = 274.30'
 E = 17.10'

STAGE 2 CONSTRUCTION
 I 89-3(23)
 SHEET 11 OF 121

STATE OF VERMONT
 DEPARTMENT OF HIGHWAYS

INTERSTATE PROJECT IN THE TOWNS OF
 WILLISTON, SOUTH BURLINGTON.

PLAN
 STA. 1885+00 TO STA. 1900+00

BOYDELL ENGINEERING CO.
 CONSULTING ENGINEERS
 100 STATE ST. BURLINGTON, VT.

PROJECT NO. I-89-3(23) SHEET 11 OF 121

STAGE 2 CONTRACT 1

3