


PLAN	DATE	BY
DESIGNED		
CHECKED		
APPROVED		
BY		
DATE		

- THREE CASTLE GUARD RAIL WITH STEEL POSTS - ITEM 543 \*
  - STA 1960+00 TO 1961+00 N.B. RT.
  - STA 1960+00 TO 1962+00 S.B. LT.
  - FLUOROPOLYMER CONCL. CURB - ITEM 555
  - STA 1960+00 TO 1961+00 N.B. RT.
- STANDARD STEEL BEAM GUARD RAIL ITEM 547 A \*
  - STA 1969+75 TO 1970+79 N.B. LT.
  - STA 1969+83 TO 1970+87 N.B. RT.
  - STA 1970+25 TO 1971+29 S.B. LT.
  - STA 1970+30 TO 1971+34 S.B. RT.
- DRILLING & BLASTING OF SOLID ROCK SUBGRADE - ITEM 114 MOD.
  - STA 1967+50 TO 1972+50 N.B.
  - STA 1967+50 TO 1972+50 S.B.
- PLANTING TREES, SHRUBS AND VINES - ITEM 631 \*
  - SEE SHADED AREAS AND QUANTITY SHEET
- PAVED DITCH - ITEM 361-B \*
  - STA 1963+33 TO 1963+50 N.B. LT.

- \* STAGE 2 ITEMS
  - Much Elevation - Item 114
  - Sta. 1961+50 to 1969+00 N.B.
  - Sta. 1962+00 to 1969+00 S.B.
  - Sta. 1973+50 to 1975+00 S.B.
  - E. Hinesburg Rd. 1975+00
  - Sta. 1960 to 1969
- PROPERTY LINE FENCE WITH STEEL POSTS ITEM 585 B MOD.
  - STA 1960+00 TO 1970+60 N.B. RT. - 1088'
  - STA 1970+98 TO 1975+00 N.B. RT. - 403'
  - STA 1960+00 TO 1970+10 S.B. LT. - 1018'
  - STA 1970+50 TO 1975+00 S.B. LT. - 445'
  - 2985'

ERECT ROW FENCE PRIOR TO CONSTRUCTION  
FROM STA. 1960+00 TO STA. 1970+00 RT.  
1960+00 1969+00 LT.

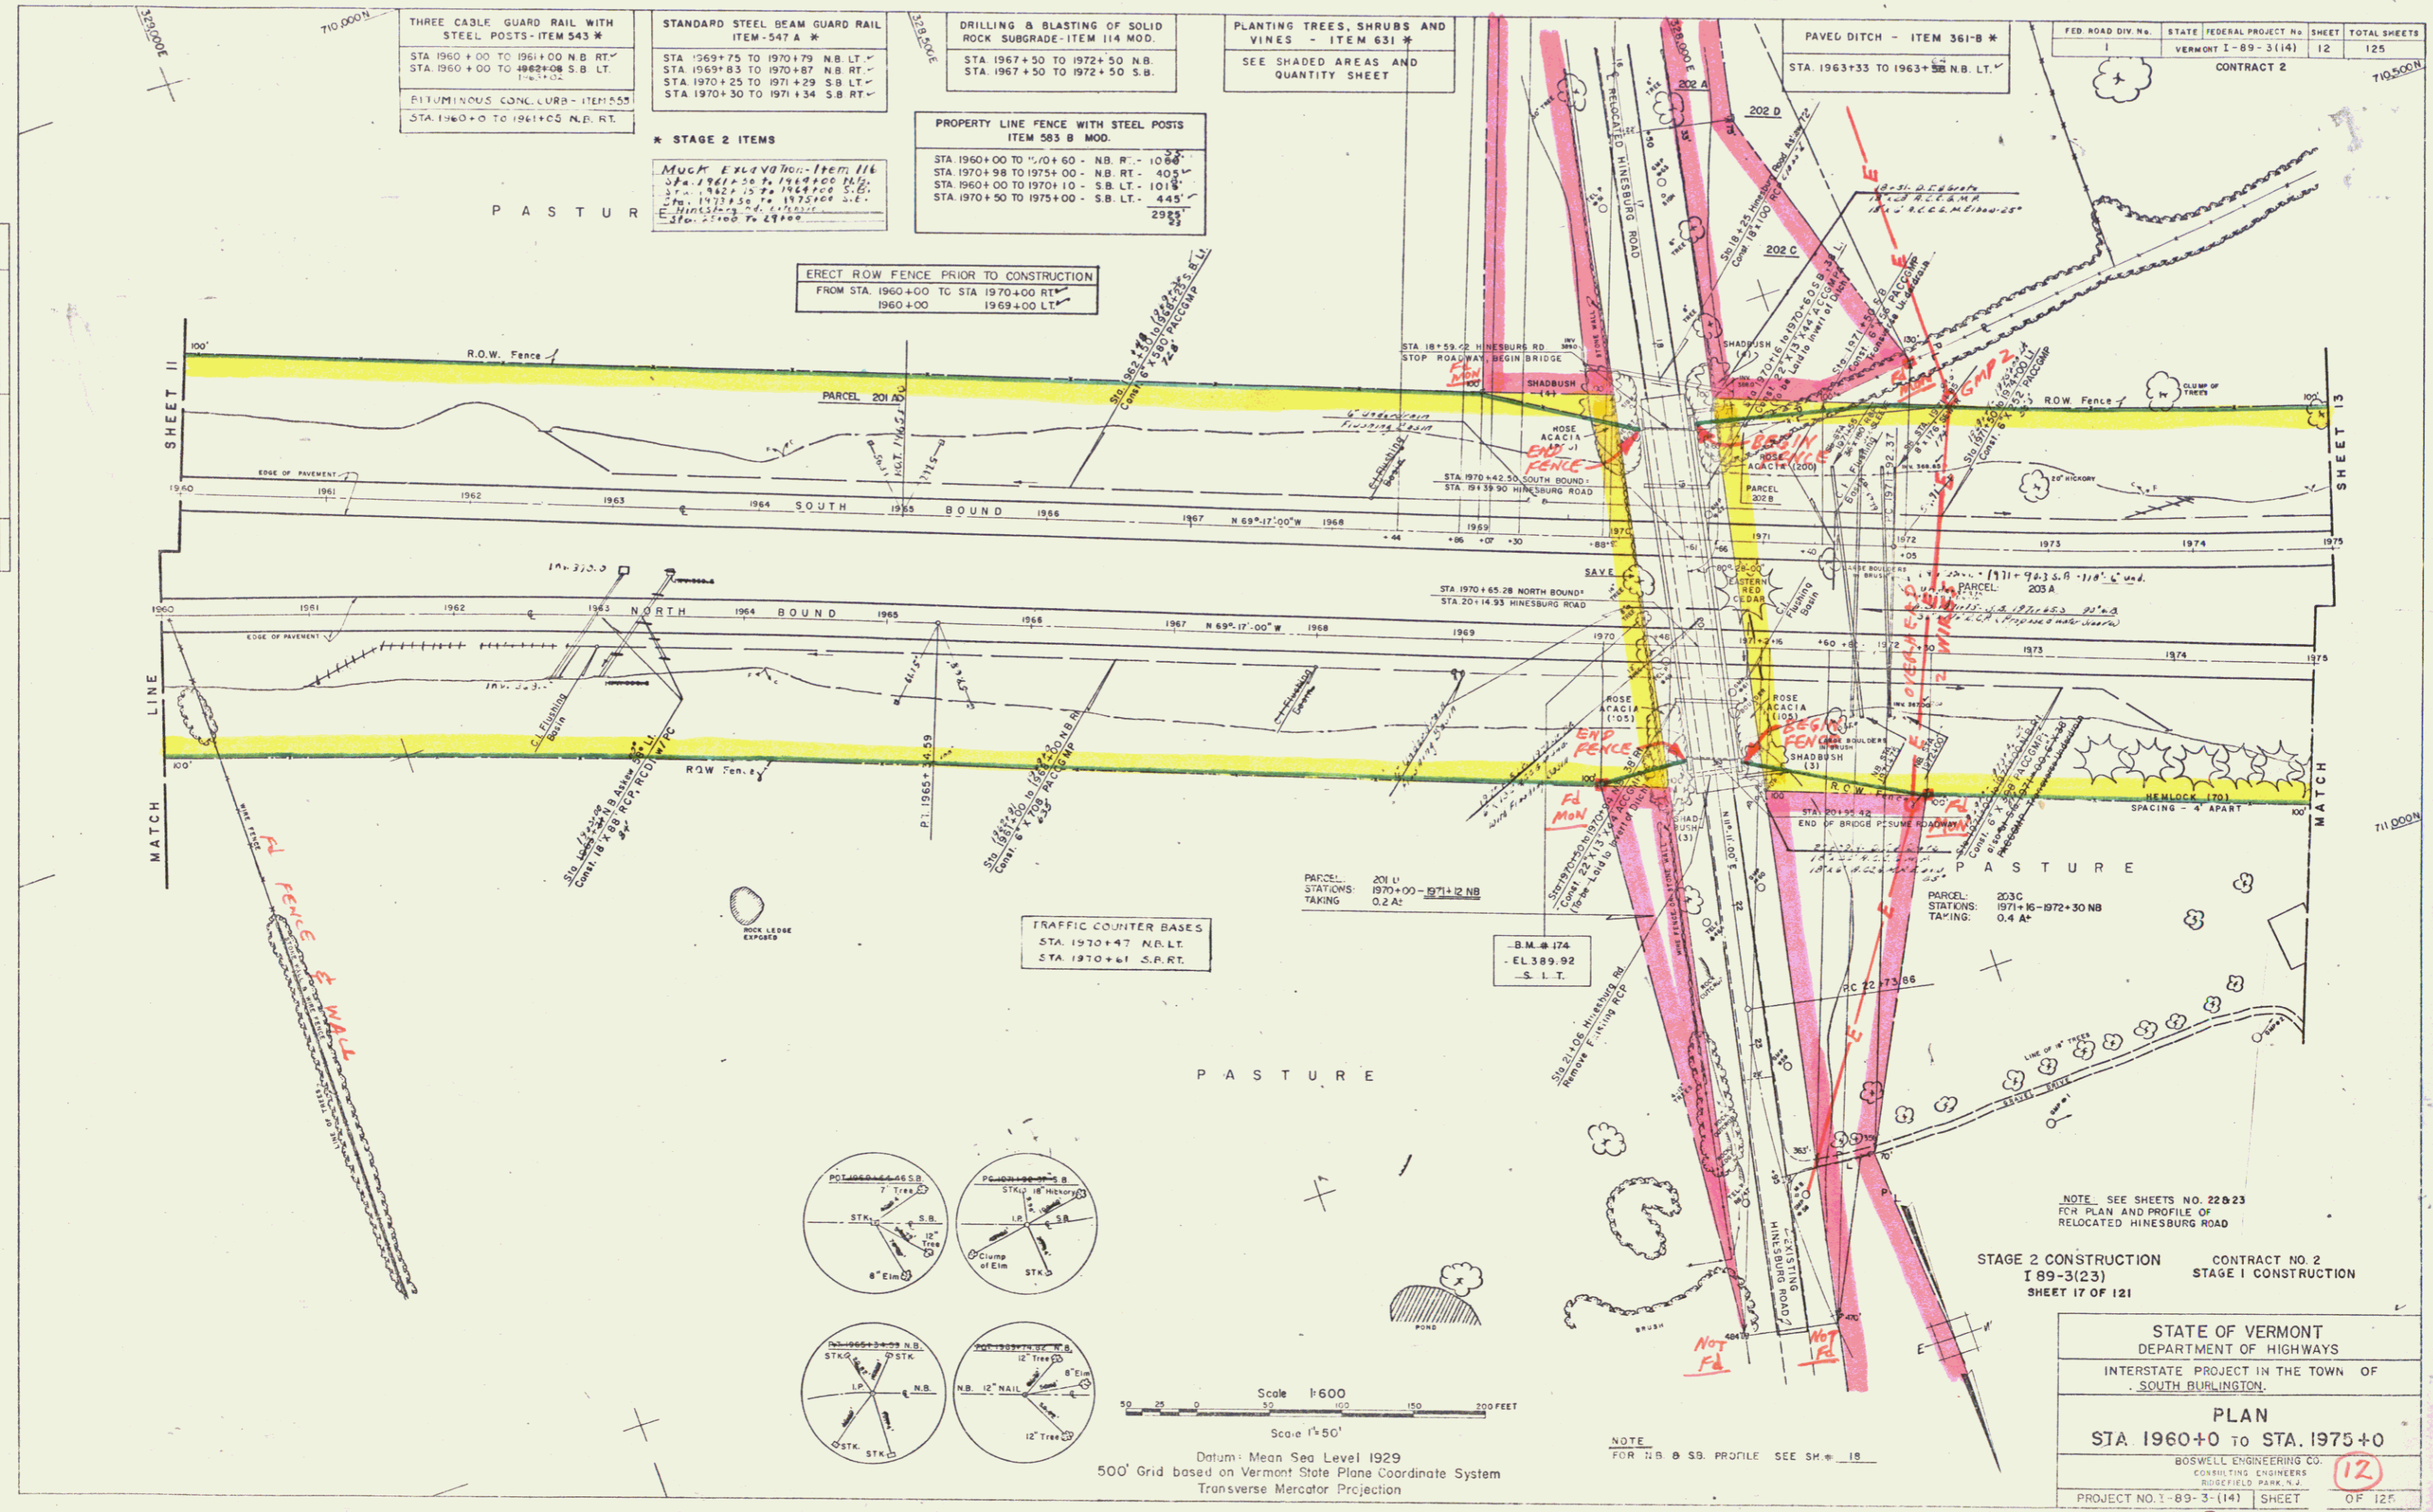

FED. ROAD DIV. NO.	STATE	FEDERAL PROJECT NO.	SHEET	TOTAL SHEETS
1	VERMONT	I-89-3(14)	12	125

CONTRACT 2

NOTE: SEE SHEETS NO. 22023 FOR PLAN AND PROFILE OF RELOCATED HINESBURG ROAD

STAGE 2 CONSTRUCTION I 89-3(23) SHEET 17 OF 121

CONTRACT NO. 2 STAGE 1 CONSTRUCTION

STATE OF VERMONT  
DEPARTMENT OF HIGHWAYS  
INTERSTATE PROJECT IN THE TOWN OF  
SOUTH BURLINGTON.

PLAN  
STA. 1960+0 TO STA. 1975+0

BOSWELL ENGINEERS CO.  
CONSULTING ENGINEERS  
ROSELAND PARK, N.J.

PROJECT NO. I-89-3(14) SHEET 12 OF 125

Const + Row

Scale 1"=50'  
500' Grid based on Vermont State Plane Coordinate System  
Transverse Mercator Projection

NOTE FOR N.B. & S.B. PROFILE SEE SH. 18