

DATE	
BY	
PLAN	
1957	
1958	
1959	
CURVE DATA				
NO.	D	R	L	T
E-3	161°-49'-35.5"	225.0	633.45	1406.81
F-3	66°-19'-00.4"	200.0	23.49	30.82
G-1	175°-57'-4.116"	230.0	767.78	172
H-1	175°-57'-4.116"	230.0	767.78	172

GRANITE SLOPE EDGING
ITEM 556-A #

STA 364.72 TO 373.39 L. "Ramp E"
STA 22+37 TO 2+26 L. "Ramp F"
STA 10+28 TO 1+03 L. "Ramp G"
STA 22+25 TO 23+73 R. "Ramp H"

CONSTRUCT DRIVES

Reloc Dorset St. 3+45.75
Reloc Dorset St. 3+55.00
Reloc Dorset St. 8+66.00
Reloc Dorset St. 8+66.00

PLANTING TREES - SHRUBS - J
VINES - ITEM 631 - MOD. M

ISEE SHADED AREAS & QUANTITY SHEET
SPECIAL GRASS SEED:
U.S. RTE. 2 STA. 31+00 TO 31+60. RT.


"PFL" SAMPLE QUAMP TML WITH
"FEL" POS. - ITEM 543 K

321.500E
322.000E

FED. ROAD DIV. NO.	STATE	FEDERAL PROJECT NO.	SHEET	TOTAL SHEETS
1	VERMONT	1-89-3(12)	16	175

CHAIN LINK FENCE (ALUMINUM)
ITEM 550-A 6' HIGH

STA 19+85 TO 26-88 RAMP "H" RT. - 7' 2"
STA 21+70 TO 28-60 RAMP "H" RT. - 7' 2"
500'

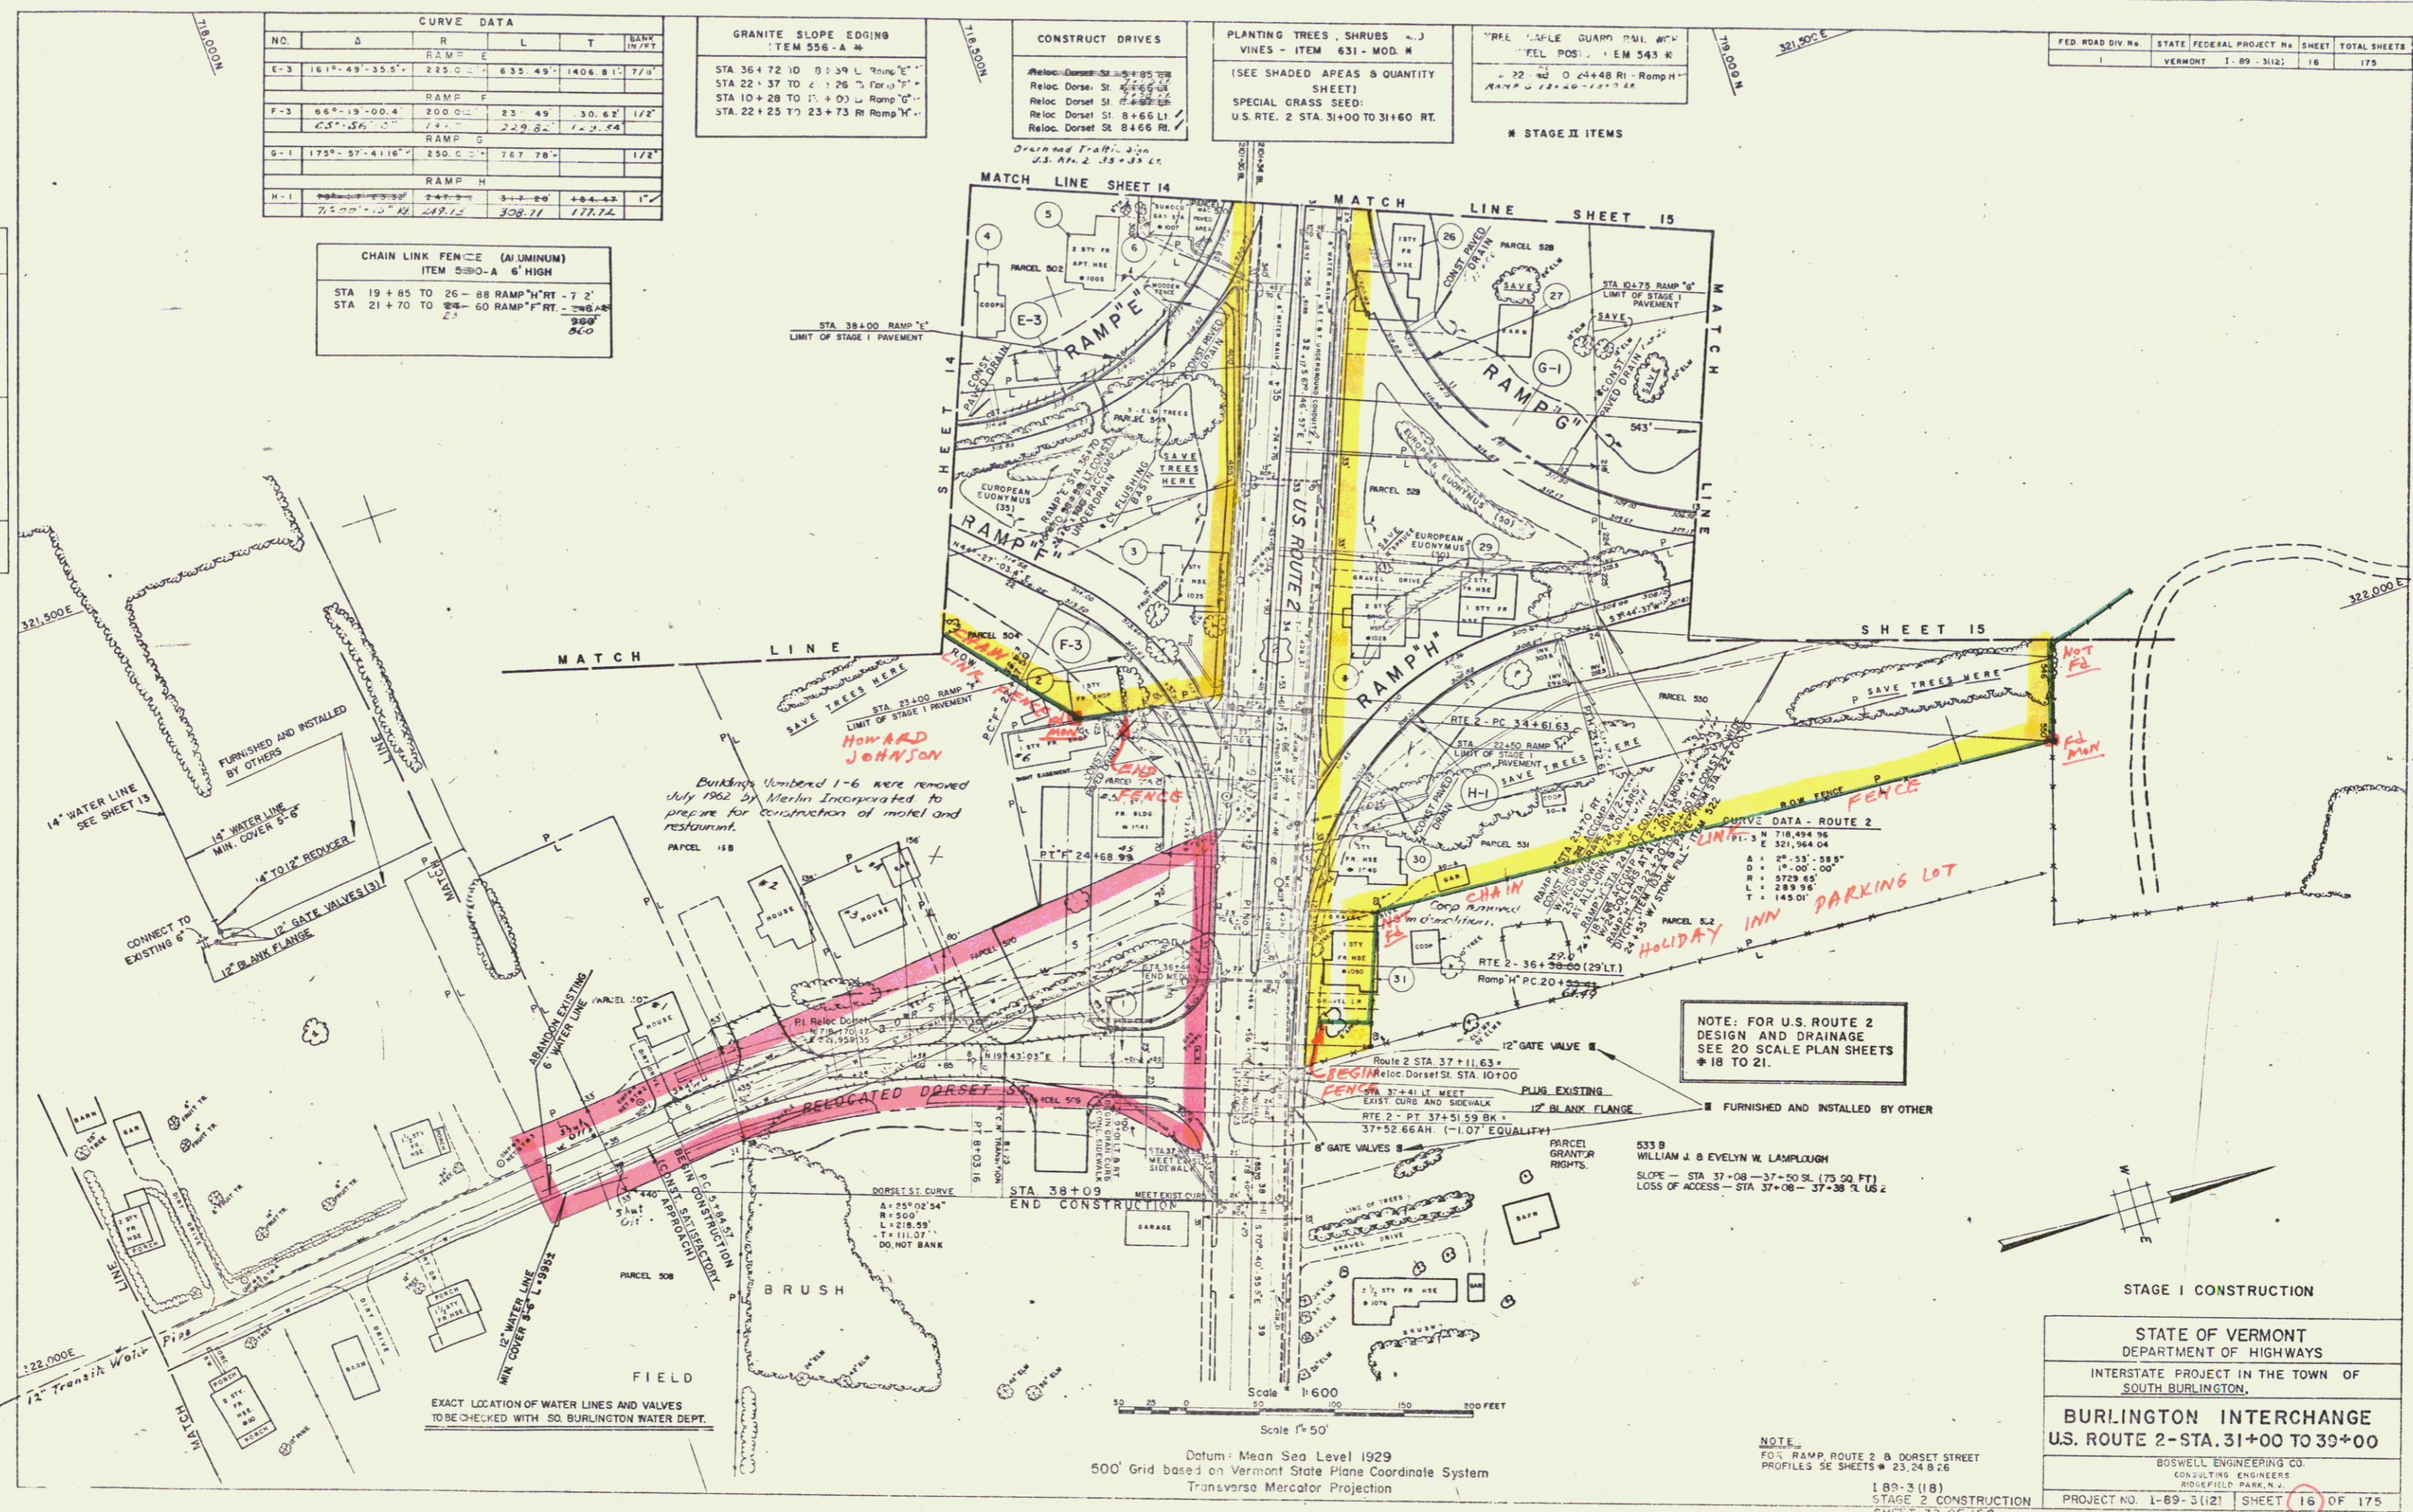

Building Number 1-6 were removed July 1962 by Merlin Incorporated to prepare for construction of motel and restaurant.

NOTE: FOR U.S. ROUTE 2 DESIGN AND DRAINAGE SEE 20 SCALE PLAN SHEETS #18 TO 21.

STAGE I CONSTRUCTION

STATE OF VERMONT
DEPARTMENT OF HIGHWAYS
INTERSTATE PROJECT IN THE TOWN OF
SOUTH BURLINGTON.

BURLINGTON INTERCHANGE
U.S. ROUTE 2 - STA. 31+00 TO 33+00

BOSWELL ENGINEERING CO.
CONSULTING ENGINEERS
BIOFIELD PARK, N.J.

PROJECT NO. 1-89-3(12) SHEET 16 OF 175

Datum: Mean Sea Level 1929
500' Grid based on Vermont State Plane Coordinate System
Transverse Mercator Projection

NOTE:
FOR RAMP, ROUTE 2 & DORSET STREET
PROFILES SEE SHEETS # 23, 24 & 26

1-89-3(18)
STAGE 2 CONSTRUCTION
SHEET 32 OF 156