

REMOVING & RESETTING CURB ITEM 557	
REMOVE	RESET
STA. 16+55 TO 17+70 LT.	STA. 16+55 TO 17+70 LT.
STA. 18+55 TO 19+70 LT.	STA. 18+55 TO 19+70 LT.
STA. 19+85 TO 22+35 LT.	STA. 19+85 TO 22+35 LT.
STA. 22+75 TO 23+50 LT.	STA. 22+75 TO 23+50 LT.
STA. 16+55 TO 17+70 RT.	STA. 16+55 TO 17+70 RT.
STA. 18+55 TO 19+70 RT.	STA. 18+55 TO 19+70 RT.
STA. 19+85 TO 20+56 RT.	STA. 19+85 TO 20+56 RT.
STA. 20+85 TO 22+45 RT.	STA. 20+85 TO 22+45 RT.
STA. 22+75 TO 23+50 RT.	STA. 22+75 TO 23+50 RT.


GRANITE CURB ITEM 556-B	
STA. 21+08 TO 23+00 LT. (incl. 2' R)	STA. 21+08 TO 23+00 LT. (incl. 2' R)
STA. 22+04 TO 23+00 RT. (incl. 2' R)	STA. 22+04 TO 23+00 RT. (incl. 2' R)
Median STA. 19+99 TO 23+00 LT. & RT.	Median STA. 19+99 TO 23+00 LT. & RT.

ONE COURSE CEMENT CONCRETE SIDEWALK - ITEM 560	
STA. 16+55 TO 21+25 LT.	STA. 16+55 TO 21+25 LT.
STA. 16+55 TO 22+04 RT.	STA. 16+55 TO 22+04 RT.
STA. 21+30 TO 23+00 LT.	STA. 21+30 TO 23+00 LT.
STA. 22+11 TO 23+00 RT.	STA. 22+11 TO 23+00 RT.

CONSTRUCT DRIVES	
STA. 17+85 LT.	STA. 17+85 LT.
STA. 18+19 RT.	STA. 18+19 RT.

REMOVAL & DISPOSAL OF PRESENT GUARD RAIL - ITEM 550	
STA. 18+62 TO 19+44 RT.	STA. 18+62 TO 19+44 RT.

FED. ROAD DIV. NO.	STATE	FEDERAL PROJECT NO.	SHEET	TOTAL SHEETS
1	VERMONT	I-89-3(12)	18	175

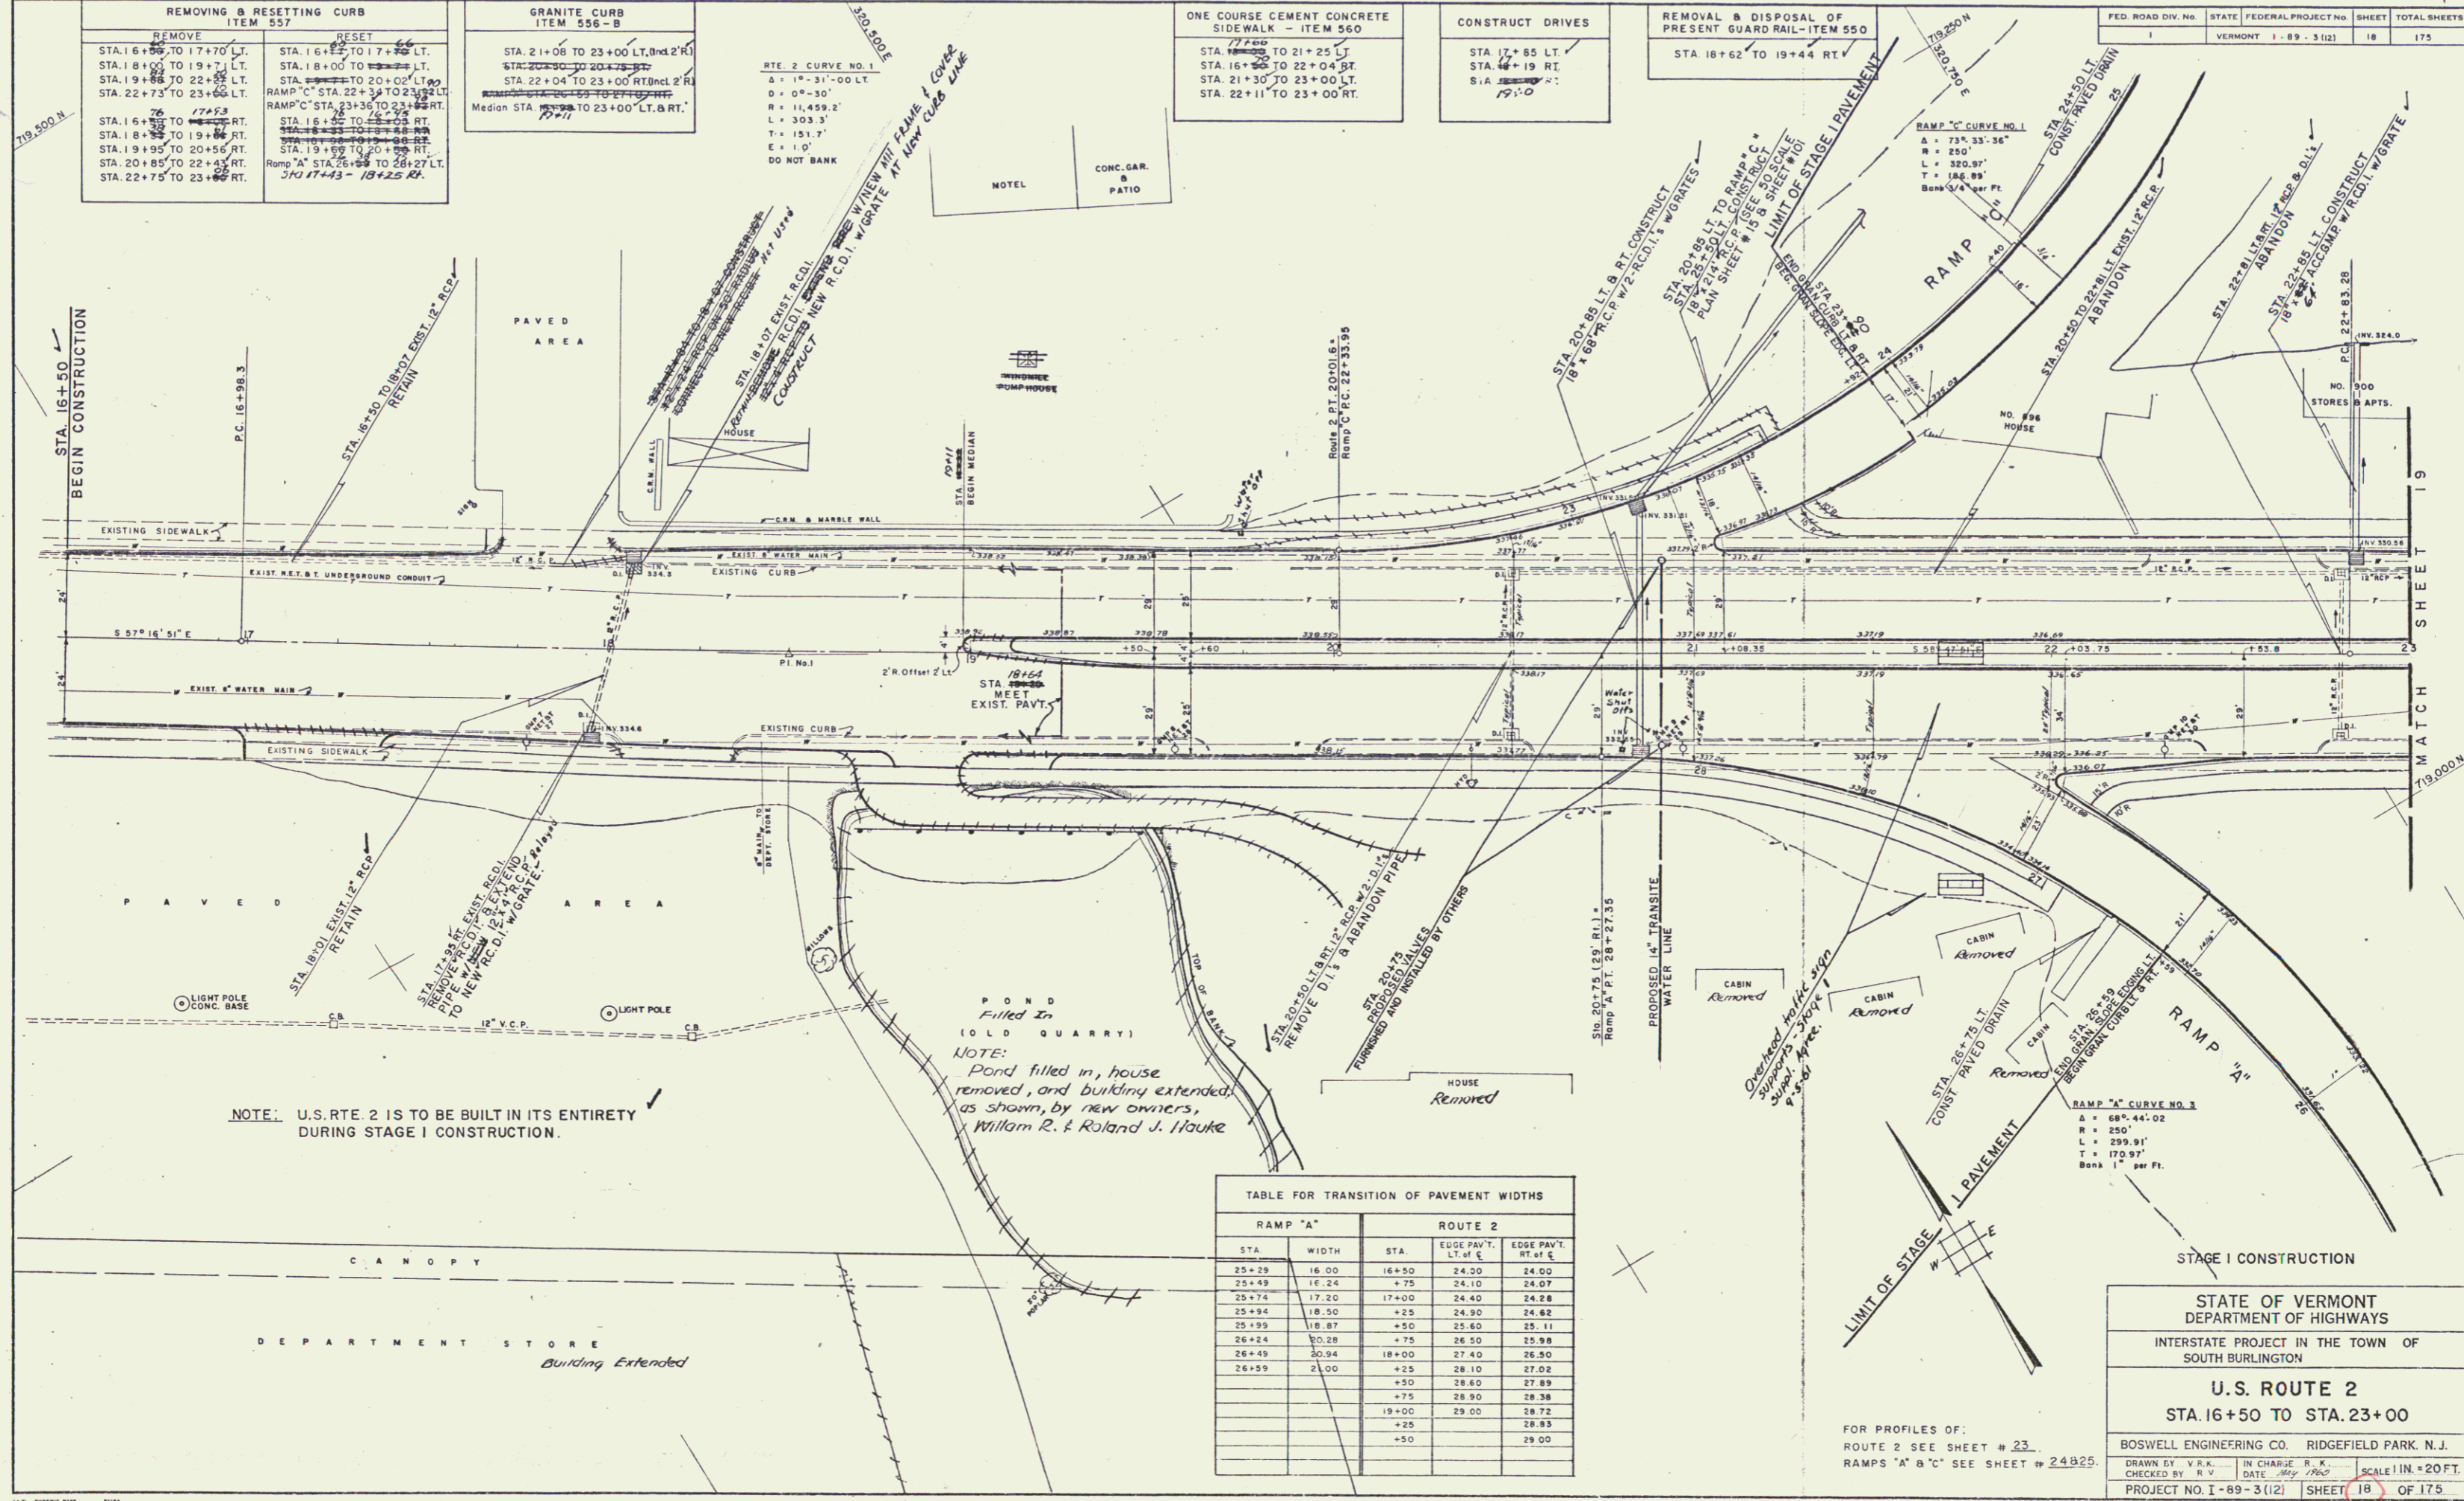

NOTE: U.S. RTE. 2 IS TO BE BUILT IN ITS ENTIRETY DURING STAGE I CONSTRUCTION.

NOTE: Pond filled in, house removed, and building extended, as shown, by new owners, William R. & Roland J. Hauke

RAMP "A"		ROUTE 2	
STA.	WIDTH	STA.	EDGE PAV'T. LT. of C. / EDGE PAV'T. RT. of C.
25+29	16.00	16+50	24.00 / 24.00
25+49	16.24	+75	24.10 / 24.07
25+74	17.20	17+00	24.40 / 24.28
25+94	18.50	+25	24.90 / 24.62
25+99	18.87	+50	25.60 / 25.11
26+24	20.28	+75	26.50 / 25.98
26+49	20.34	18+00	27.40 / 26.90
26+59	21.00	+25	28.10 / 27.02
		+50	28.60 / 27.89
		+75	28.90 / 28.38
		19+00	29.00 / 28.72
		+25	28.83
		+50	29.00

STATE OF VERMONT  
DEPARTMENT OF HIGHWAYS  
INTERSTATE PROJECT IN THE TOWN OF  
SOUTH BURLINGTON

**U.S. ROUTE 2**  
STA. 16+50 TO STA. 23+00

BOSWELL ENGINEERING CO. RIDGEFIELD PARK, N.J.  
DRAWN BY V.A.R. IN CHARGE R.K. SCALE 1/4" = 20 FT.  
CHECKED BY R.V. DATE May 1962  
PROJECT NO. I-89-3(12) SHEET 18 OF 175

FOR PROFILES OF:  
ROUTE 2 SEE SHEET # 23.  
RAMPS "A" & "C" SEE SHEET # 24 & 25.