

INDEX OF SHEETS

- TITLE SHEET
- ALIGNMENT DATA SHEET With I-89-3(18) Stage I Plans
- TYPICAL SECTIONS (3" BITUMINOUS CONCRETE PAVEMENT, MOD) With I-89-3(18) Stage I Plans
- QUANTITY SHEETS
- GRADE SHEETS With I-89-3(18) Stage I Plans
- BANKING TABLES
- B-15 ENTRANCE & EXIT TERMINALS
- B-17 DETAIL OF GUARD RAIL IN MEDIAN
- C-1 CURB DETAILS
- D-3 TREATED GUTTERS
- D-4 UNDERDRAIN FLUSHING BASINS
- E-1 BARRICADES, SIGNS & LIGHTS (ROADWAY)
- E-3 REGULATORY SIGNS (TRAFFIC)
- E-4 ROUTE & AUXILIARY MARKERS (TRAFFIC)
- E-6 REGULATORY, WARNING & GUIDE SIGNS (TRAFFIC)
- E-7 STANDARD SIGN PLACEMENT (TRAFFIC)
- E-8 DELINEATORS
- E-9 CONSTRUCTION IDENTIFICATION SIGNS
- G-1 STANDARD STEEL BEAM GUARD RAIL
- G-3 THREE CABLE GUARD RAIL WITH STEEL POSTS
- G-4 PLANK GUARD RAIL, GUIDE & MARKER POSTS
- J-1 PROJECT & BOUNDARY MARKERS
- E-5A SIGN POST FOOTINGS
- PLAN SHEETS With I-89-3(18) Stage I Plans
- PROFILE SHEETS With I-89-3(18) Stage I Plans
- RIGHT OF WAY SHEETS
- TRAFFIC SIGNS
- TRAFFIC SIGNS
- CROSS SECTIONS, RAMPS-BURLINGTON INTERCHANGE
- CROSS SECTIONS, (2080+00 - 2204+50)

STATE OF VERMONT
DEPARTMENT OF HIGHWAYS
PROPOSED IMPROVEMENT

TOWN OF SOUTH BURLINGTON-CITY OF WINOOSKI


COUNTY OF CHITTENDEN

PROJECT 189-3(18) STAGE 2 CONSTRUCTION

BEGINNING AT A POINT IN SOUTH BURLINGTON 1.655 MILES SOUTH OF THE WINOOSKI-SOUTH BURLINGTON TOWN LINE AND EXTENDING NORTHERLY FOR A DISTANCE OF 2.346 MILES.

LENGTH OF ROADWAY 2.072 MILES = 10,938.64 FEET
LENGTH OF BRIDGES 0.274 MILES = 1,449.20 FEET
LENGTH OF PROJECT 2.346 MILES = 12,387.84 FEET

DESIGN	DESIGNATION
A D T	1959 7600
A D T	1975 17250
D H V	1975 2500
D	54%
V	4%
	70 M.P.H.

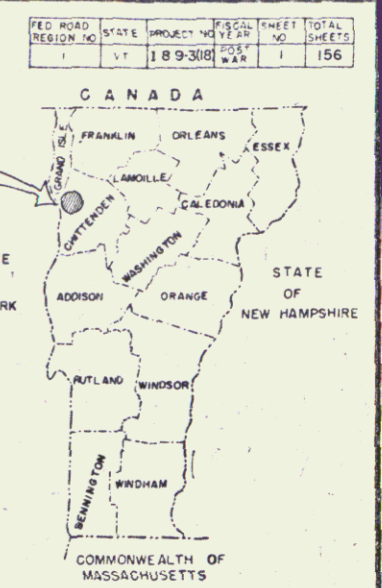


RECORD PLANS

PROJECT NAME & NUMBER TYPE PAVEMENT AREA
SOUTH BURLINGTON-WINOOSKI I-89-3(18) 66 OFB S.Y.

STONE GRITS — DEMERS QUARRY — WINOOSKI, VT.
SAND FOR CUSHION — U.V.M. PIT & LAMPLOUGH PIT — W. BURLINGTON, VT. & ST. GELAIS PIT — COLCHESTER, VT.
CUTBACK ASPHALT & ASPHALT CEMENT — TRIMOUNT, BITUMINOUS PRODUCT CO. — EVERETT, MASS.
TAR EMULSION FOR BRIDGE FLOORS — KOPPEL PRODUCTS CO. — EVERETT, MASS.
BITUMINOUS CONCRETE — L.M. PIKE & SON INC. — LAGOVIA, N.H.
JOINT SEALER, HOT POURED ELASTIC TYPE — SERVICISED PRODUCTS CORP. — CHICAGO, ILL.
CONCRETE CLASS "B" — S.T. GRIEWOLD & CO. INC. — ESSEX JUNCTION, VT.
REINFORCING STEEL, STEEL GUARD RAIL CABLE, STEEL BEAM GUARD RAIL, STEEL GUARD RAIL, GUIDE & MARKER POSTS —
ASPH. CTD. CORR. GALV. WET. PIPE & ELBOWS, CAST IRON PIPE UNDERDRAIN FLUSHING BASINS — NEW ENGLAND METAL PIPE CO. — WHITE RIVER JUNCTION, VT.
STEEL DROP INLET GRATES — VERMONT STRUCTURAL STEEL CORP. — BURLINGTON, VT.
GRANITE SLOPE EDGING — BARRETT GRANITE CO. — MILFORD, N.H.
TRAFFIC SIGNS — STANDARD SIGN AND SIGNAL CO. — CLINTON, MASS.
OVERHEAD TRAFFIC SIGN SUPPORTS — PLANET CORP. — LANSING, MICH.
DELINEATORS — ELIZABETH DIVISION OF ELASTIC SHOP NUT CORP. OF AMERICA — ELIZABETH, N.J.
SETTING (LAWNS) — JOHN G. LYONS — CAMBRIDGE, MASS.
COMMERCIAL FERTILIZER — BURLINGTON RENDERING CO. — BURLINGTON, VT.

CONTRACTOR — THE LANE CONST. CORP. MERIDEN, CONN.
RESIDENT ENGINEER — DONALD REMICK
INSPECTORS — J. STEARNS, WAYNE JARVIS, A. ELWOOD, G. MOFFAT, B. R. OLTRON
RECORD PLANS — JAMES W. STEARNS
CONTRACT — DATED — OCTOBER 6, 1961
STARTED — MAY 16, 1962
COMPLETED — NOV. 29, 1962
ACCEPTED — NOV. 29, 1962

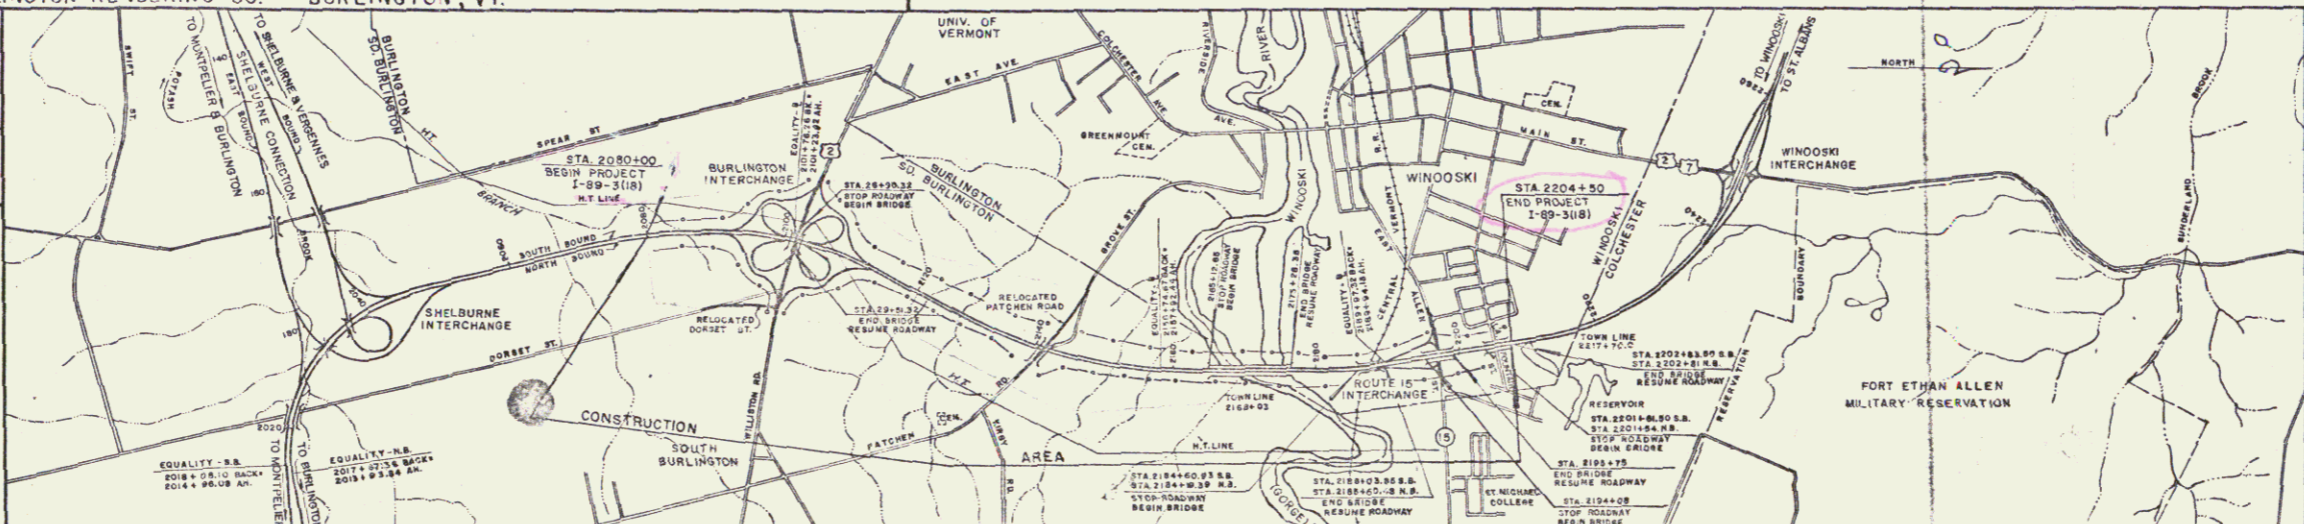

R.O. LANE CONST. CORP. MERIDEN, CONN.
SOUTH BURLINGTON-WINOOSKI (STAGE 2)
CONTRACTOR THE LANE CONSTRUCTION CORP. MERIDEN, CONN.
LOCATION Beginning of a point in So. Burlington 1.655 miles south of Winooksi-So. Burlington Town Line and extending northerly 2.346 miles to Winooksi-So. Burlington Town Line.

SCALES

TITLE	1" = 1320'
TYPICAL	1" = AS SHOWN
PLAN	1" = 50'
PROFILE HORIZONTAL	1" = 50'
PROFILE VERTICAL	1" = 10'
CROSS-SECTIONS	1" = 10' OR 5'

SCALES

TITLE 1" = 1320'
TYPICAL 1" = AS SHOWN
PLAN 1" = 50'
PROFILE HORIZONTAL 1" = 50'
PROFILE VERTICAL 1" = 10'
CROSS-SECTIONS 1" = 10' OR 5'

APPROVED [Signature] DATE July 14, 1961
APPROVED [Signature] DATE July 14, 1961
APPROVED [Signature] DATE July 13, 1961
APPROVED [Signature] DATE July 12, 1961
APPROVED [Signature] DATE July 13, 1961

MP 89.08-90.66

STAGE 2 CONSTRUCTION
DEPARTMENT OF COMMERCE
BUREAU OF PUBLIC ROADS
OCT 2 1974
PROJECT I NO. 89-3(18)
SHEET 1 OF 156 SHEETS

SOUTH BURLINGTON - WINOOSKI
2120+00 - 2181+50