


ONE COURSE CEM. CONC. SIDEWALK
8" THICK ACROSS COMMERCIAL
DRIVES:
STA. 40+40 TO 40+75 LT.
STA. 41+01 TO 41+38 LT.
STA. 41+92 TO 42+27 LT.
STA. 42+49 TO 42+84 LT.
(SIDEWALK IN REMAINDER OF AREAS
LISTED BELOW IS 5" THICK.)

GRANITE CURB - ITEM 556-B
STA. 40+15 TO 40+65 RT.
STA. 42+23 TO 45+00 RT.
STA. 40+00 TO 40+39 LT.
STA. 40+75 TO 41+00 LT.
STA. 41+39 TO 41+92 LT.
STA. 42+26 TO 42+49 LT.
STA. 42+73 TO 45+00 LT.
STA. 40+14 TO 41+90 MEDIAN
STA. 42+69 TO 45+00 MEDIAN
STA. 18+24 TO 19+66 LT. RAMP "A"
RAMP "A" SPUR RT.
RAMP "A" ISLAND

ONE COURSE CEMENT CONCRETE
SIDEWALK - ITEM 560
STA. 40+00 TO 41+47 RT.
STA. 41+44 TO 41+94 RT.
STA. 42+20 TO 45+00 RT.
STA. 40+00 TO 45+00 LT.
STA. 42+33 HOUSE WALK LT.
STA. 42+69 TO 45+00 CONC. MEDIAN
STA. 41+74 HOUSE WALK LT.
CONSTRUCT DRIVES
STA. 40+06 RT. (Relocated)
STA. 40+57 LT.
STA. 41+19 LT.
STA. 42+09 LT.
STA. 42+16 LT.
STA. 41+54 LT.

Note: Ties for house water shut-offs
in Bk. 4 pgs. 114-117. City of Winoski
water dept. has copy on file.

NOTE:
WATER AND SEWER SERVICES TO HOUSES LISTED FOR
DEMOLITION TO BE TERMINATED AND PLUGGED BY OTHERS;
WATER LINE TERMINATIONS AT THE MAIN; SEWER LINE
TERMINATIONS AS FEASIBLE UNDER FIELD CONDITIONS.
VT. RTE. 15 IS TO BE BUILT IN ITS ENTIRETY DURING
STAGE I CONSTRUCTION.

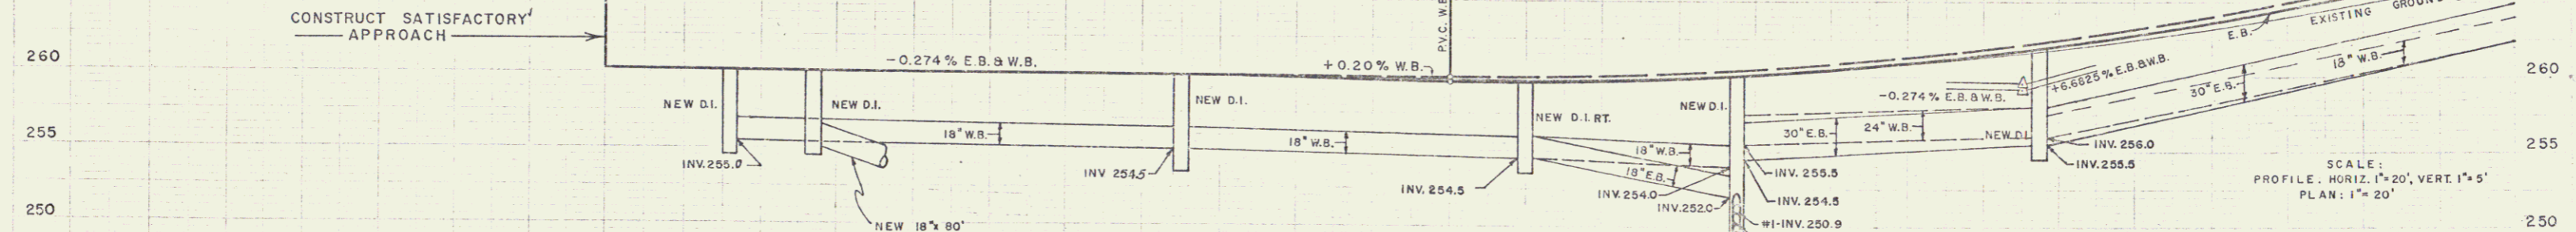

NOTE: STA. 41+50 W.B. MEETS E.B.
GRADE ELEV. 259.80
(TRANSITION W.B. FROM
STA. 41+00 TO 42+20)

SCALE:
PROFILE: HORIZ. 1" = 20', VERT. 1" = 5'
PLAN: 1" = 20'

STAGE I CONSTRUCTION

STATE OF VERMONT
DEPARTMENT OF HIGHWAYS
INTERSTATE PROJECT IN THE TOWN OF
WINOSKI

PLAN & PROFILE
ROUTE 15

BOSWELL ENGINEERING CO.
CONSULTING ENGINEERS
ROSELAND PARK, N.J.

PROJECT NO. 1 - 85 - 3(3) | SHEET 13 OF 150

16