
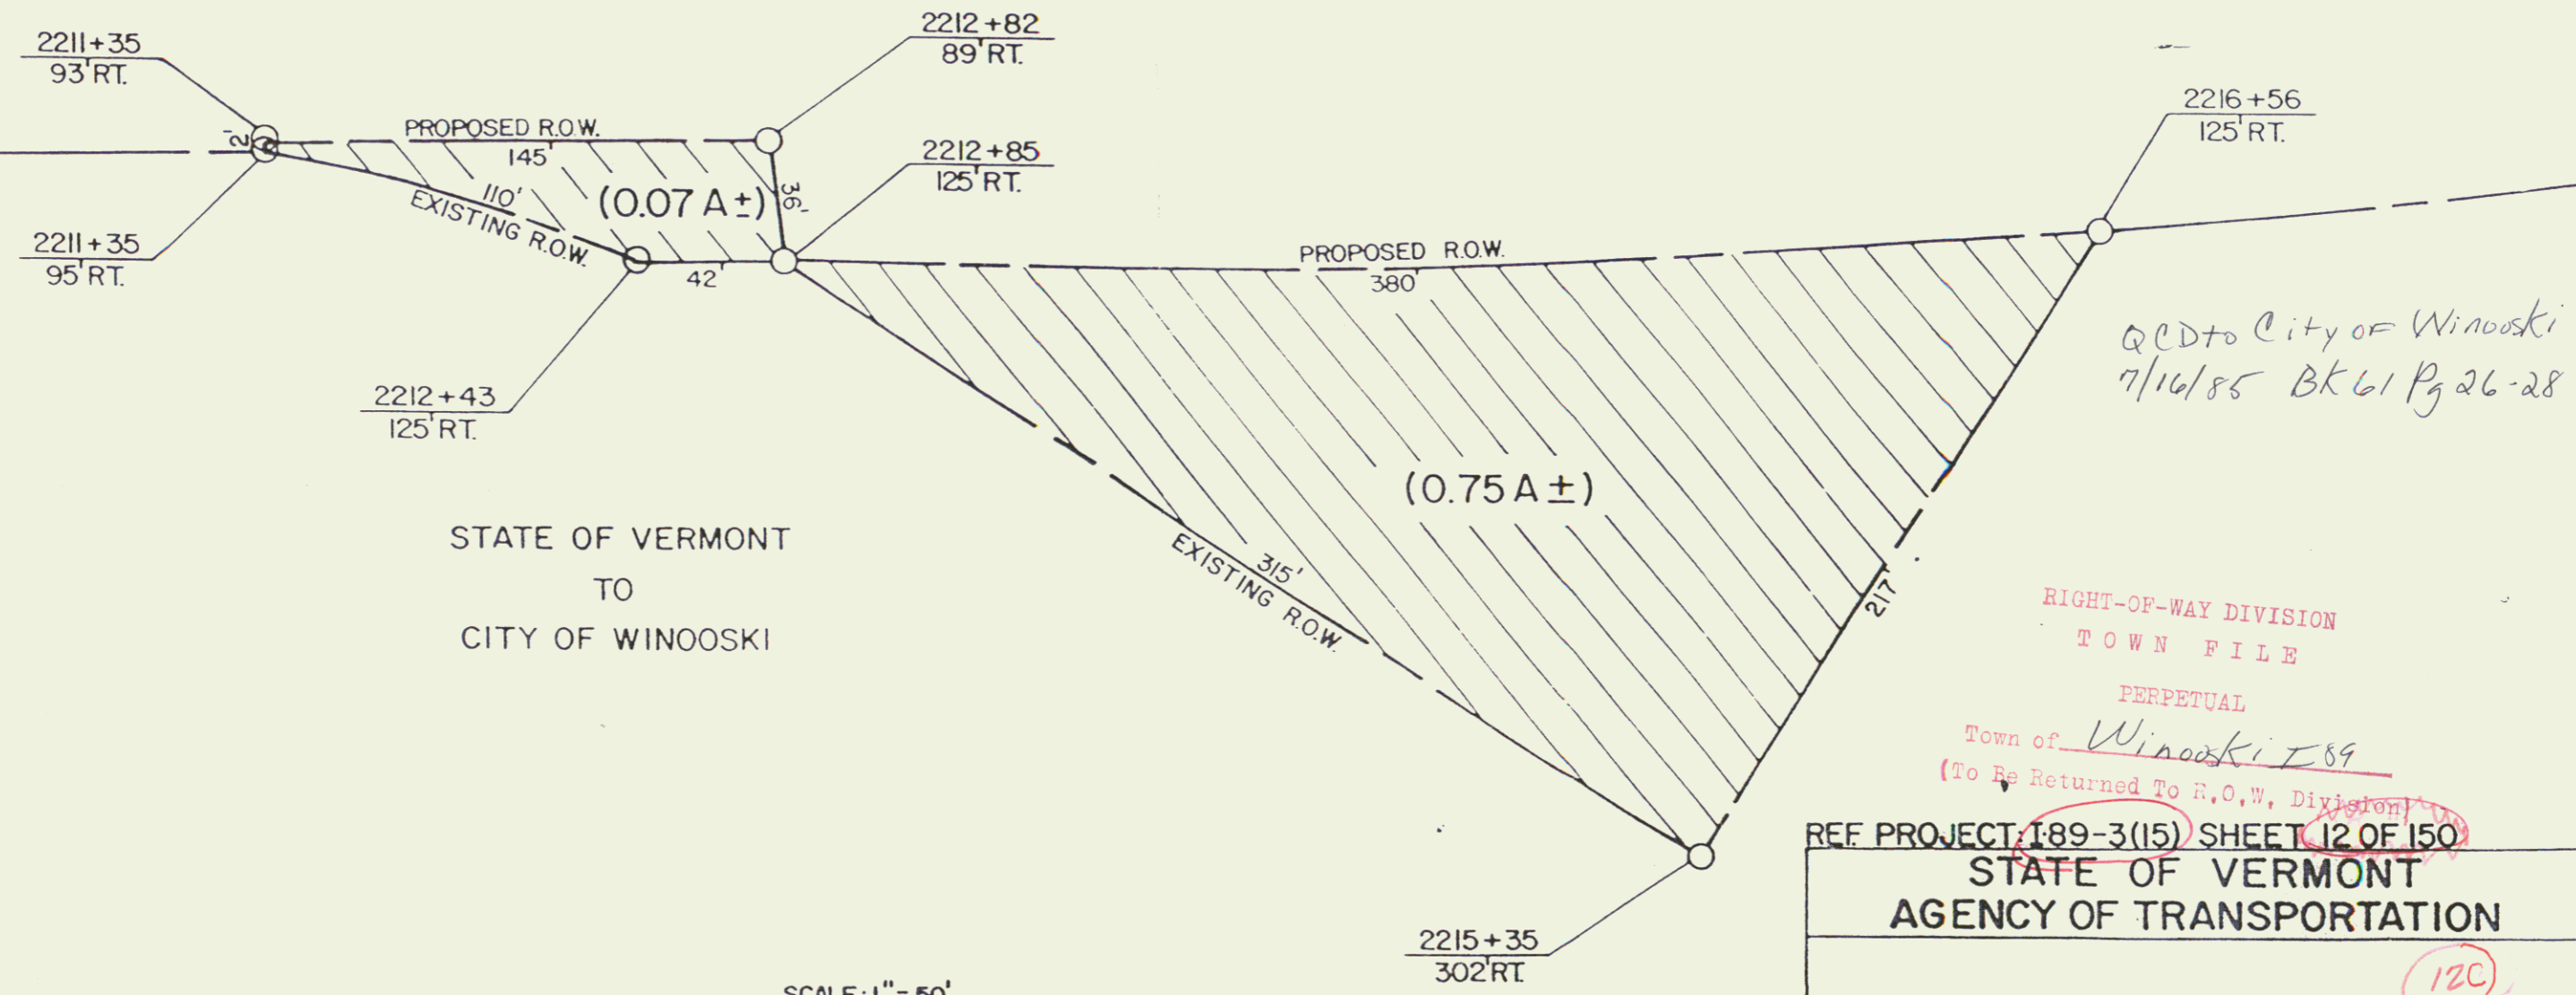
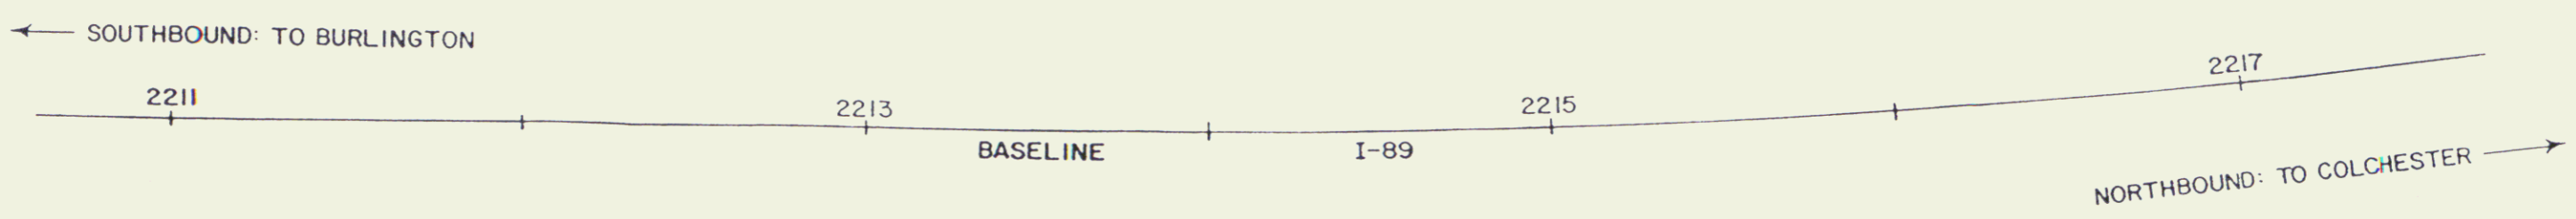


PART OF PARCEL 901 ACQUIRED FROM THE CITY OF WINOOSKI BY COND.  
 REC. AUG. 17, 1961. IN BK. 19, PG. 408  
 PART OF PARCEL 903 ACQUIRED FROM J. ADELARD & MELANE GAMELIN BY COND.  
 REC. MAY 15, 1961. IN BK. 19, PG. 384  
 PART OF PARCEL 904 ACQUIRED FROM WINOOSKI GRADED SCHOOL DIST. BY COND.  
 REC. MAY 15, 1961. IN BK. 19, PG. 384

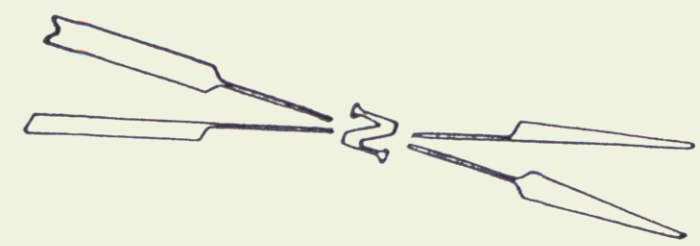


STATE OF VERMONT  
 TO  
 CITY OF WINOOSKI

RIGHT-OF-WAY DIVISION  
 TOWN FILE  
 PERPETUAL  
 Town of Winooski 189  
 (To Be Returned To R.O.W. Division)

REF PROJECT: 189-3(15) SHEET 12 OF 150

STATE OF VERMONT  
 AGENCY OF TRANSPORTATION

CITY OF WINOOSKI

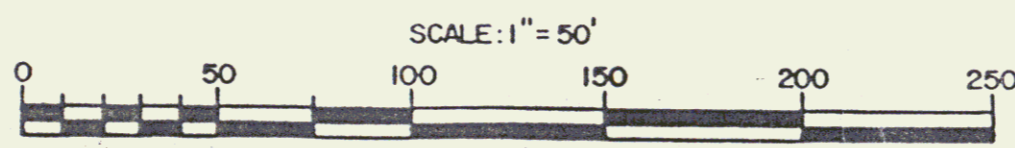

APPROX. SCALE 1" = 50' | DATE 6-3-85 | DRAWN BY DFM

120

5