


REVISED CURVE DATA

N.B. ✓	S.B. ✓
Δ 17° 12' 40" Lt.	Δ 17° 12' 40" Rt.
D 1°	D 1°
L 5729.58'	L 5729.58'
T 847.00'	T 847.00'
E 65.24'	E 65.24'
ZFL 13.07'	ZFL 13.07'
Bank 5/16" / ft.	Bank 5/16" / ft.

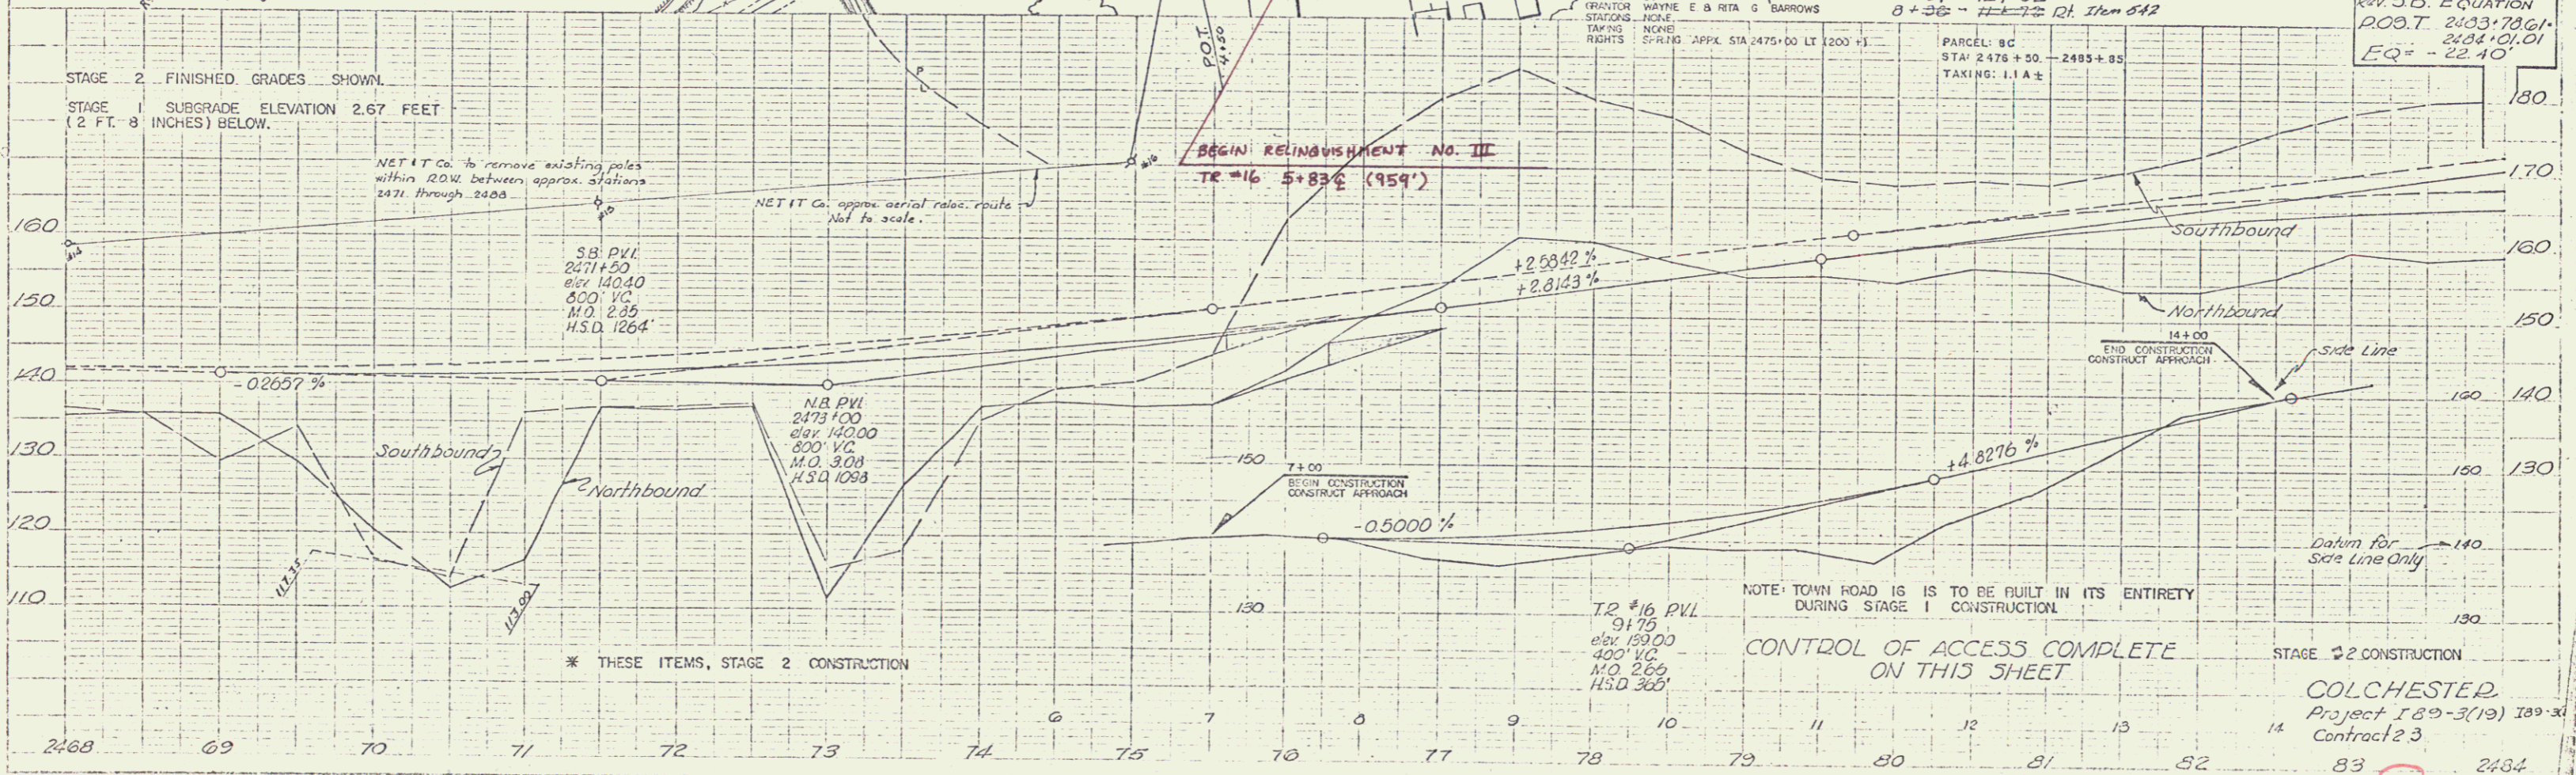

Level
Contours
3-60
4-60
5-60

Contours
1-60
2-60
3-60

COLCHESTER
Project 189-3(19) 189-3
Contract 23
83 2484
Sheet 23 of 236
AUG 7 1974