



PLAN
DATE: 10/26/62
BY: J. W. CUMMINGS
CHECKED: J. W. CUMMINGS

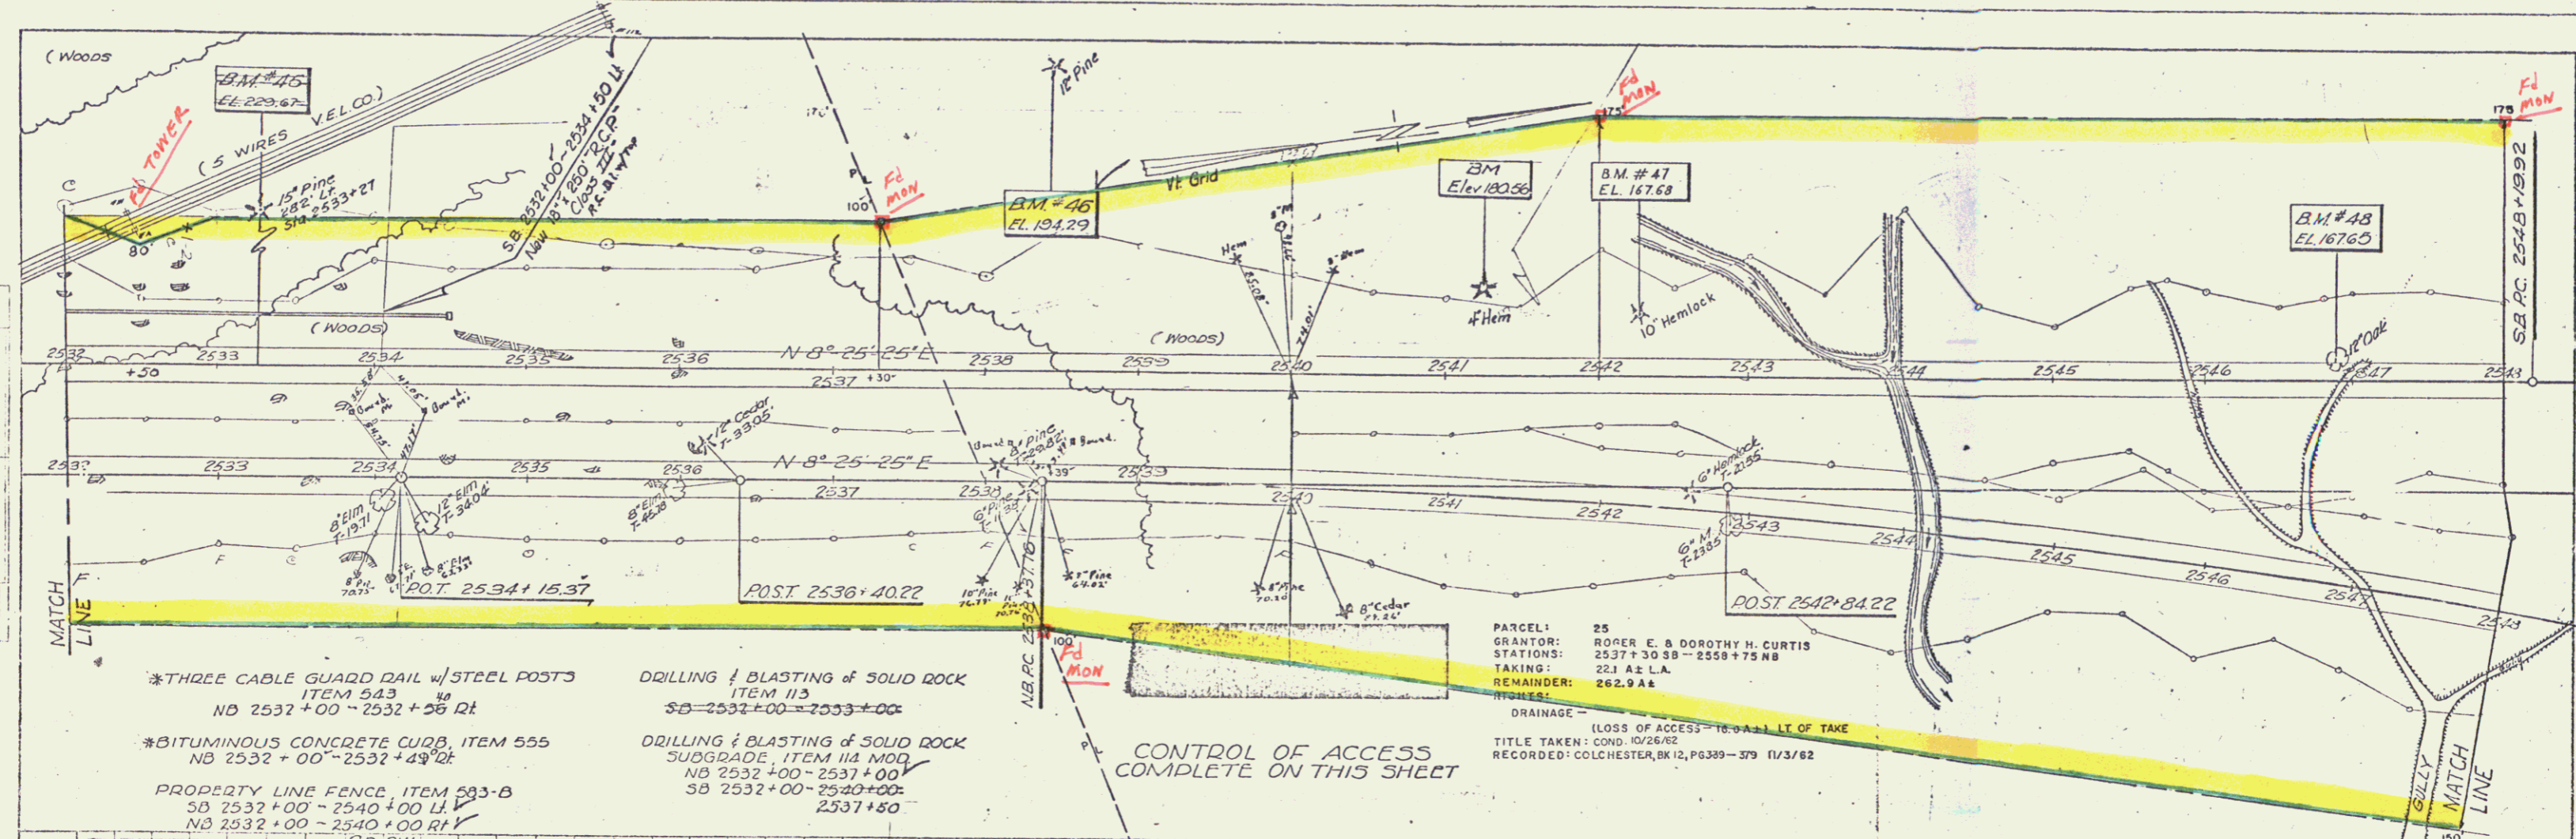

- *THREE CABLE GUARD RAIL w/STEEL POSTS
ITEM 543
NB 2532+00 - 2532+25 Rt
- *BITUMINOUS CONCRETE CURB, ITEM 555
NB 2532+00 - 2532+25 Rt
- PROPERTY LINE FENCE, ITEM 543-B
SB 2532+00 - 2540+00 Lt
NB 2532+00 - 2540+00 Rt
- DRILLING & BLASTING OF SOLID ROCK
ITEM 113
SB 2532+00 - 2533+00
- DRILLING & BLASTING OF SOLID ROCK
SUBGRADE, ITEM 114 MOD
NB 2532+00 - 2537+00
SB 2532+00 - 2540+00
2537+50

PARCEL: 25
GRANTOR: ROGER E. & DOROTHY H. CURTIS
STATIONS: 2537+30 SB - 2559+75 NB
TAKING: 221 A & L.A.
REMAINDER: 262.9 A &
DRAINAGE: LOSS OF ACCESS - 16.5 A & 1 LT. OF TAKE
TITLE TAKEN: COND. 10/26/62
RECORDED: COLCHESTER, BK 12, PG 389-379 11/3/62

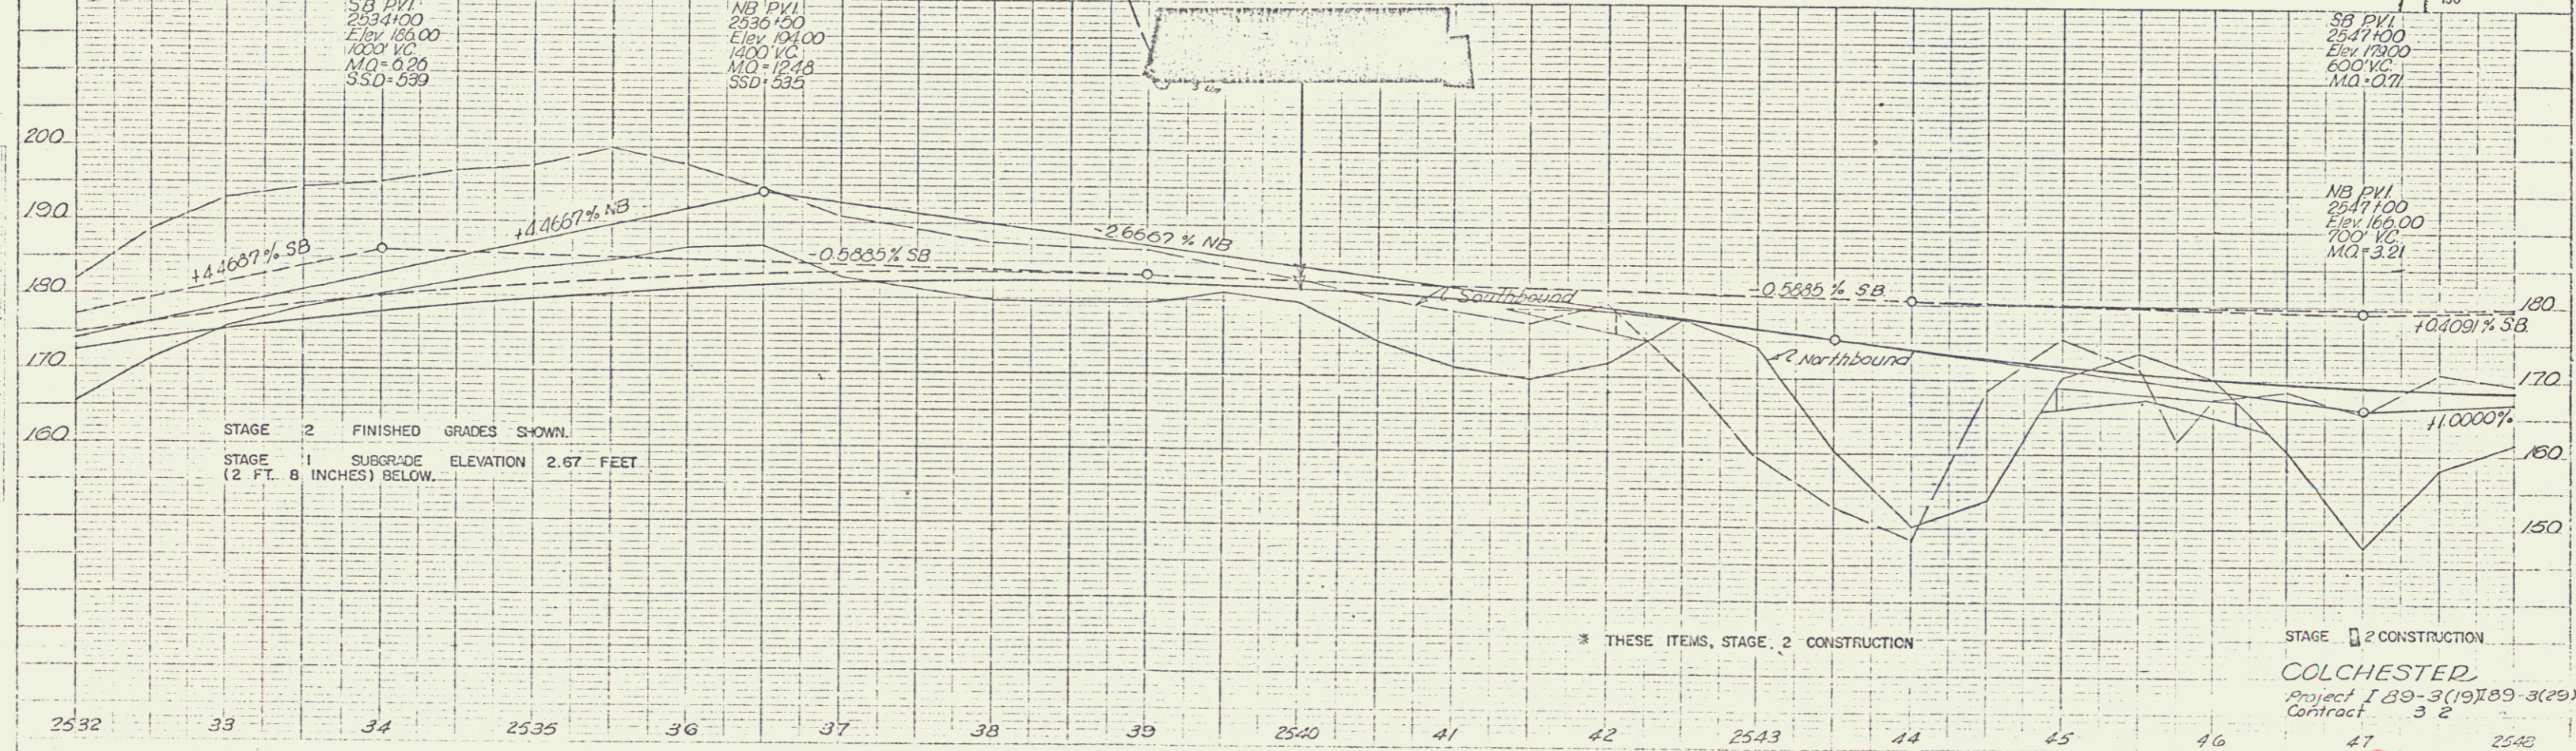

STAGE 2 FINISHED GRADES SHOWN.
STAGE 1 SUBGRADE ELEVATION 2.67 FEET
(2 FT. 8 INCHES) BELOW.

* THESE ITEMS, STAGE 2 CONSTRUCTION

STAGE 2 CONSTRUCTION
COLCHESTER
Project I 89-3(19)189-3(29)
Contract 3 2
Sheet 27 of 236 awc

AUG 7 1974