


PROPERTY LINE FENCE
WITH STEEL POSTS, ITEM 383-II
NB 2377+00-2382+00 RT

GRANITE SLOPE EDGING
ITEM 556-A
NB 2377+36-2378+36 RT
1+57-2+07 LT

CEDAR LOG GUARD RAIL
ITEM 546
4+33-5+71 RT
4+62-5+71 LT

DRILLING AND BLASTING OF SOLID
ROCK SUBGRADE, ITEM 115
4+75-5+71

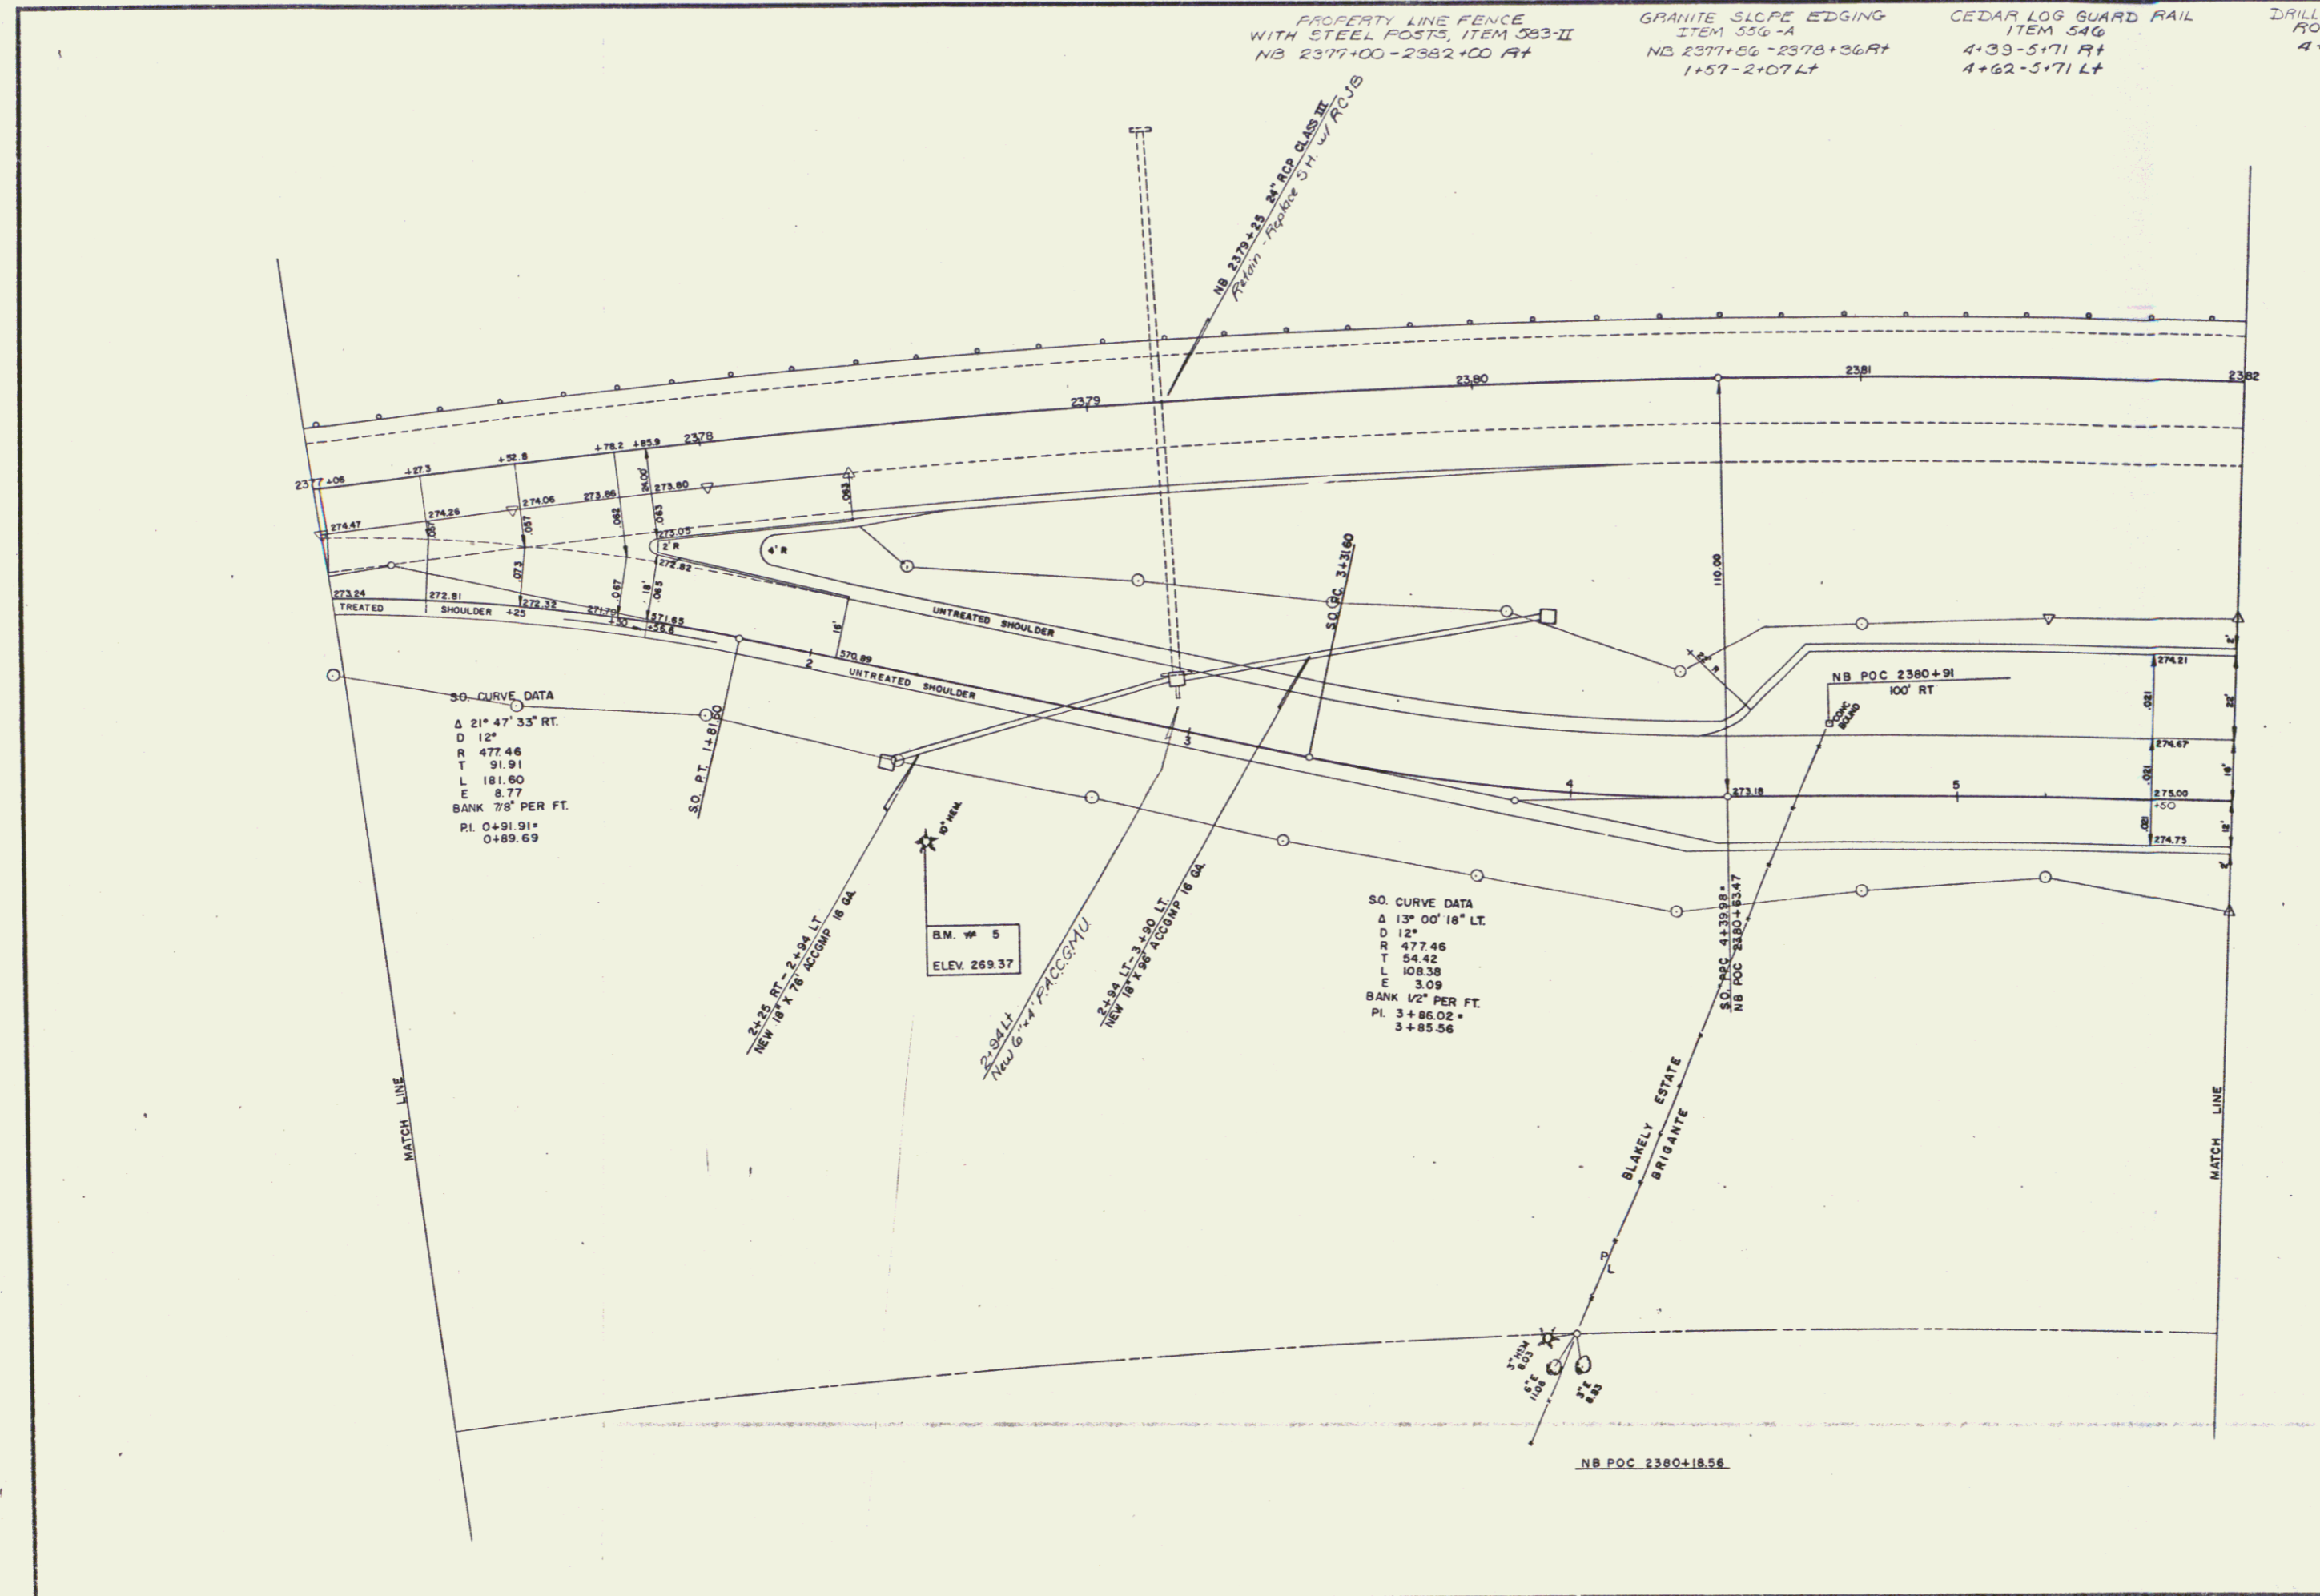

COLCHESTER Construction

SURVEYED BY: F.E. DATE: 5/66
DRAWN BY: F.E. DATE: 5/66
TRACED BY: AJA DATE: 5/66

PROJ. LSI NO. 89-3(2)
SHEET 13 OF 10