


SURVEY  
S.B. POST 2390 + 03.50

THREE CABLE GUARD RAIL  
STEEL POSTS, ITEM 583  
NB 2374 + 50 - 2385 + 25.4  
3 + 25

DRILLING & BLASTING OF SOLID ROCK  
ITEM 11A  
NB 2374 + 50 - 2392 + 00  
NB 2363 + 50 - 2365 + 00

PROPERTY LINE FENCE,  
ITEM 583-B  
SB 2374 + 50 - 2392 + 50.4

DRILLING & BLASTING  
OF SOLID ROCK, CURB GRADE, ITEM 11A MDD  
NB 2373 + 50 - 2377 + 25  
2380 + 00 - 2389 + 00  
SB 2374 + 50 - 2376 + 00  
2389 + 00

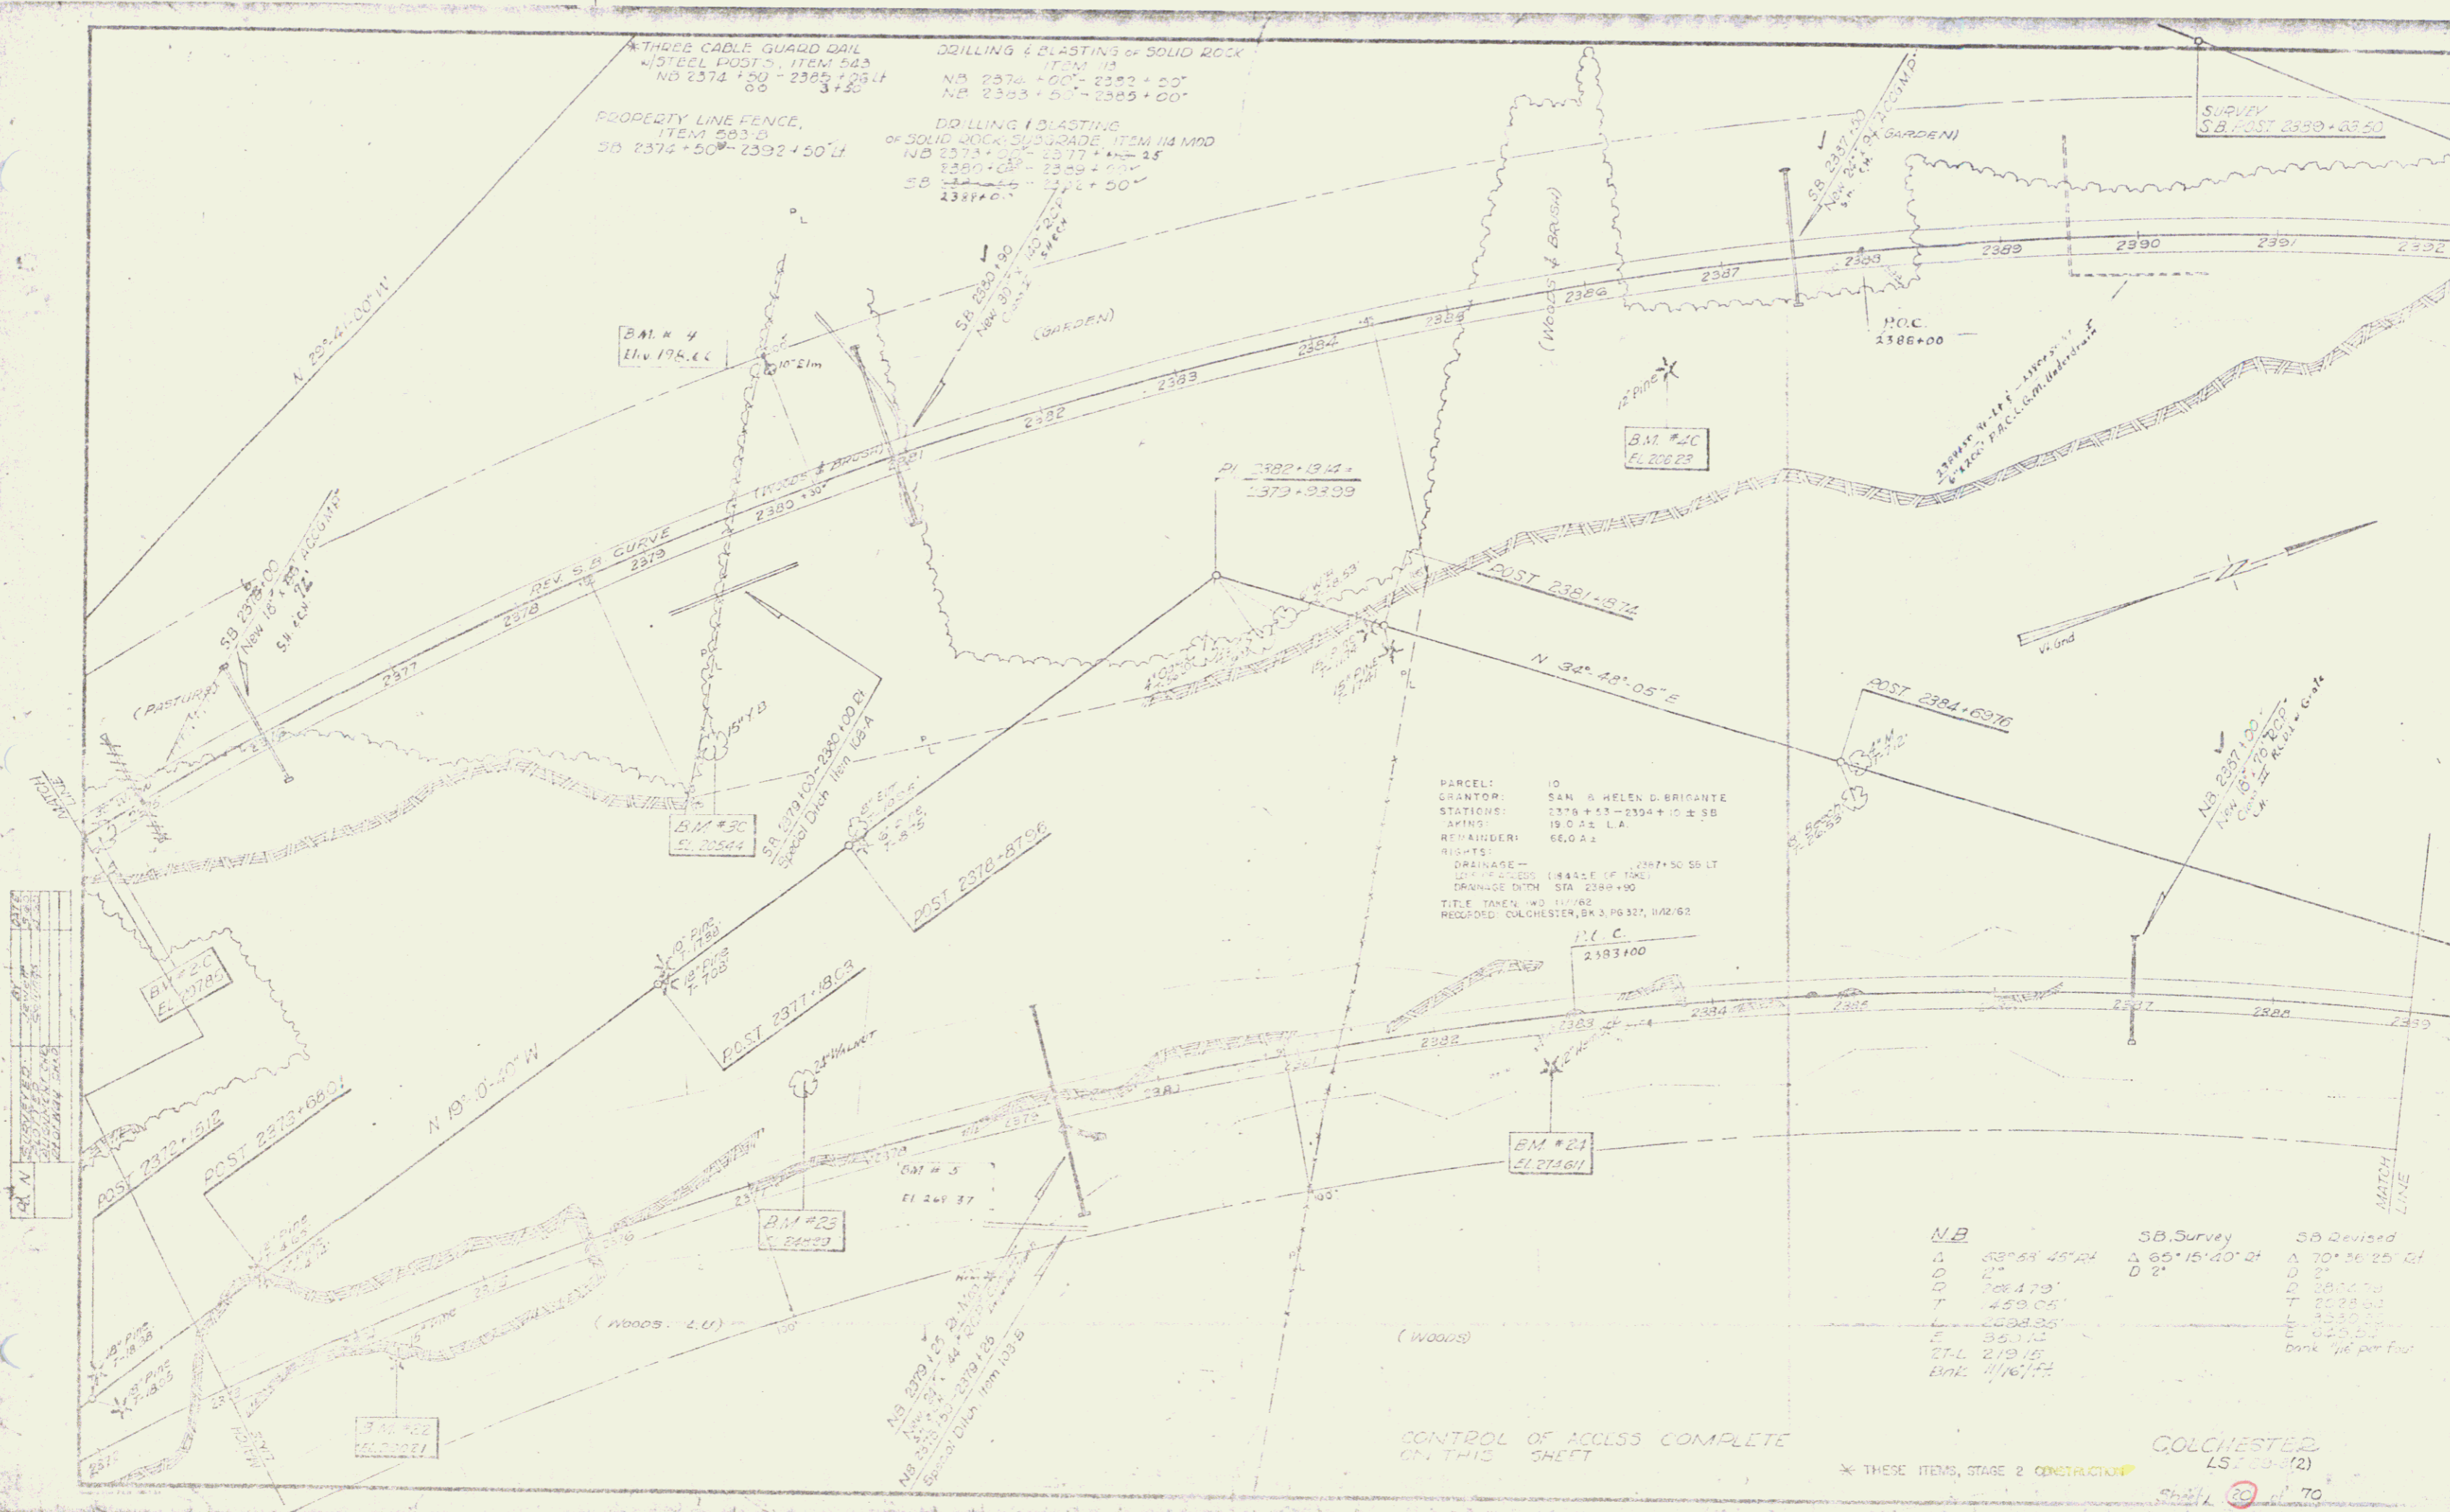

PARCEL: 10  
GRANTOR: SAN & HELEN D. BRIGANTE  
STATIONS: 2376 + 50 - 2394 + 10 ± SB  
AKINS: 19.0 ± L.A.  
REMAINDER: 66.0 ±

RIGHTS:  
DRAINAGE -  
15' ± WIDE (144 ± LF 150)  
DRAINAGE DITCH STA 2394 + 10  
TITLE TAKEN: 11/7/02  
RECORD: COLCHESTER, BK 3, PG 327, 11/2/02

N.B.	S.B. Survey	S.B. Revised
A 33° 54' 45" RT	A 65° 15' 40" RT	A 70° 36' 25" RT
D 12'	D 2'	D 2'
T 264.70'	T 264.70'	T 264.70'
T 459.05'	T 459.05'	T 459.05'
L 264.25'	L 264.25'	L 264.25'
E 350.12'	E 350.12'	E 350.12'
T.T.L. 219.15'		
BRK. 11/16/77		BRK. 11/16/77

CONTROL OF ACCESS COMPLETE  
ON THIS SHEET

\* THESE ITEMS, STAGE 2 CONSTRUCTION

COLCHESTER  
LS 70-12 (2)