


Drilling & Blasting of Solid
Rock Subgrade, No. 100
N.B. 2695+00-2697+50

PLAN	REVISED	BY	DATE
NO. 1	AS SHOWN	W. J. HARRIS	1937
NO. 2	AS SHOWN	W. J. HARRIS	1937
NO. 3	AS SHOWN	W. J. HARRIS	1937
NO. 4	AS SHOWN	W. J. HARRIS	1937

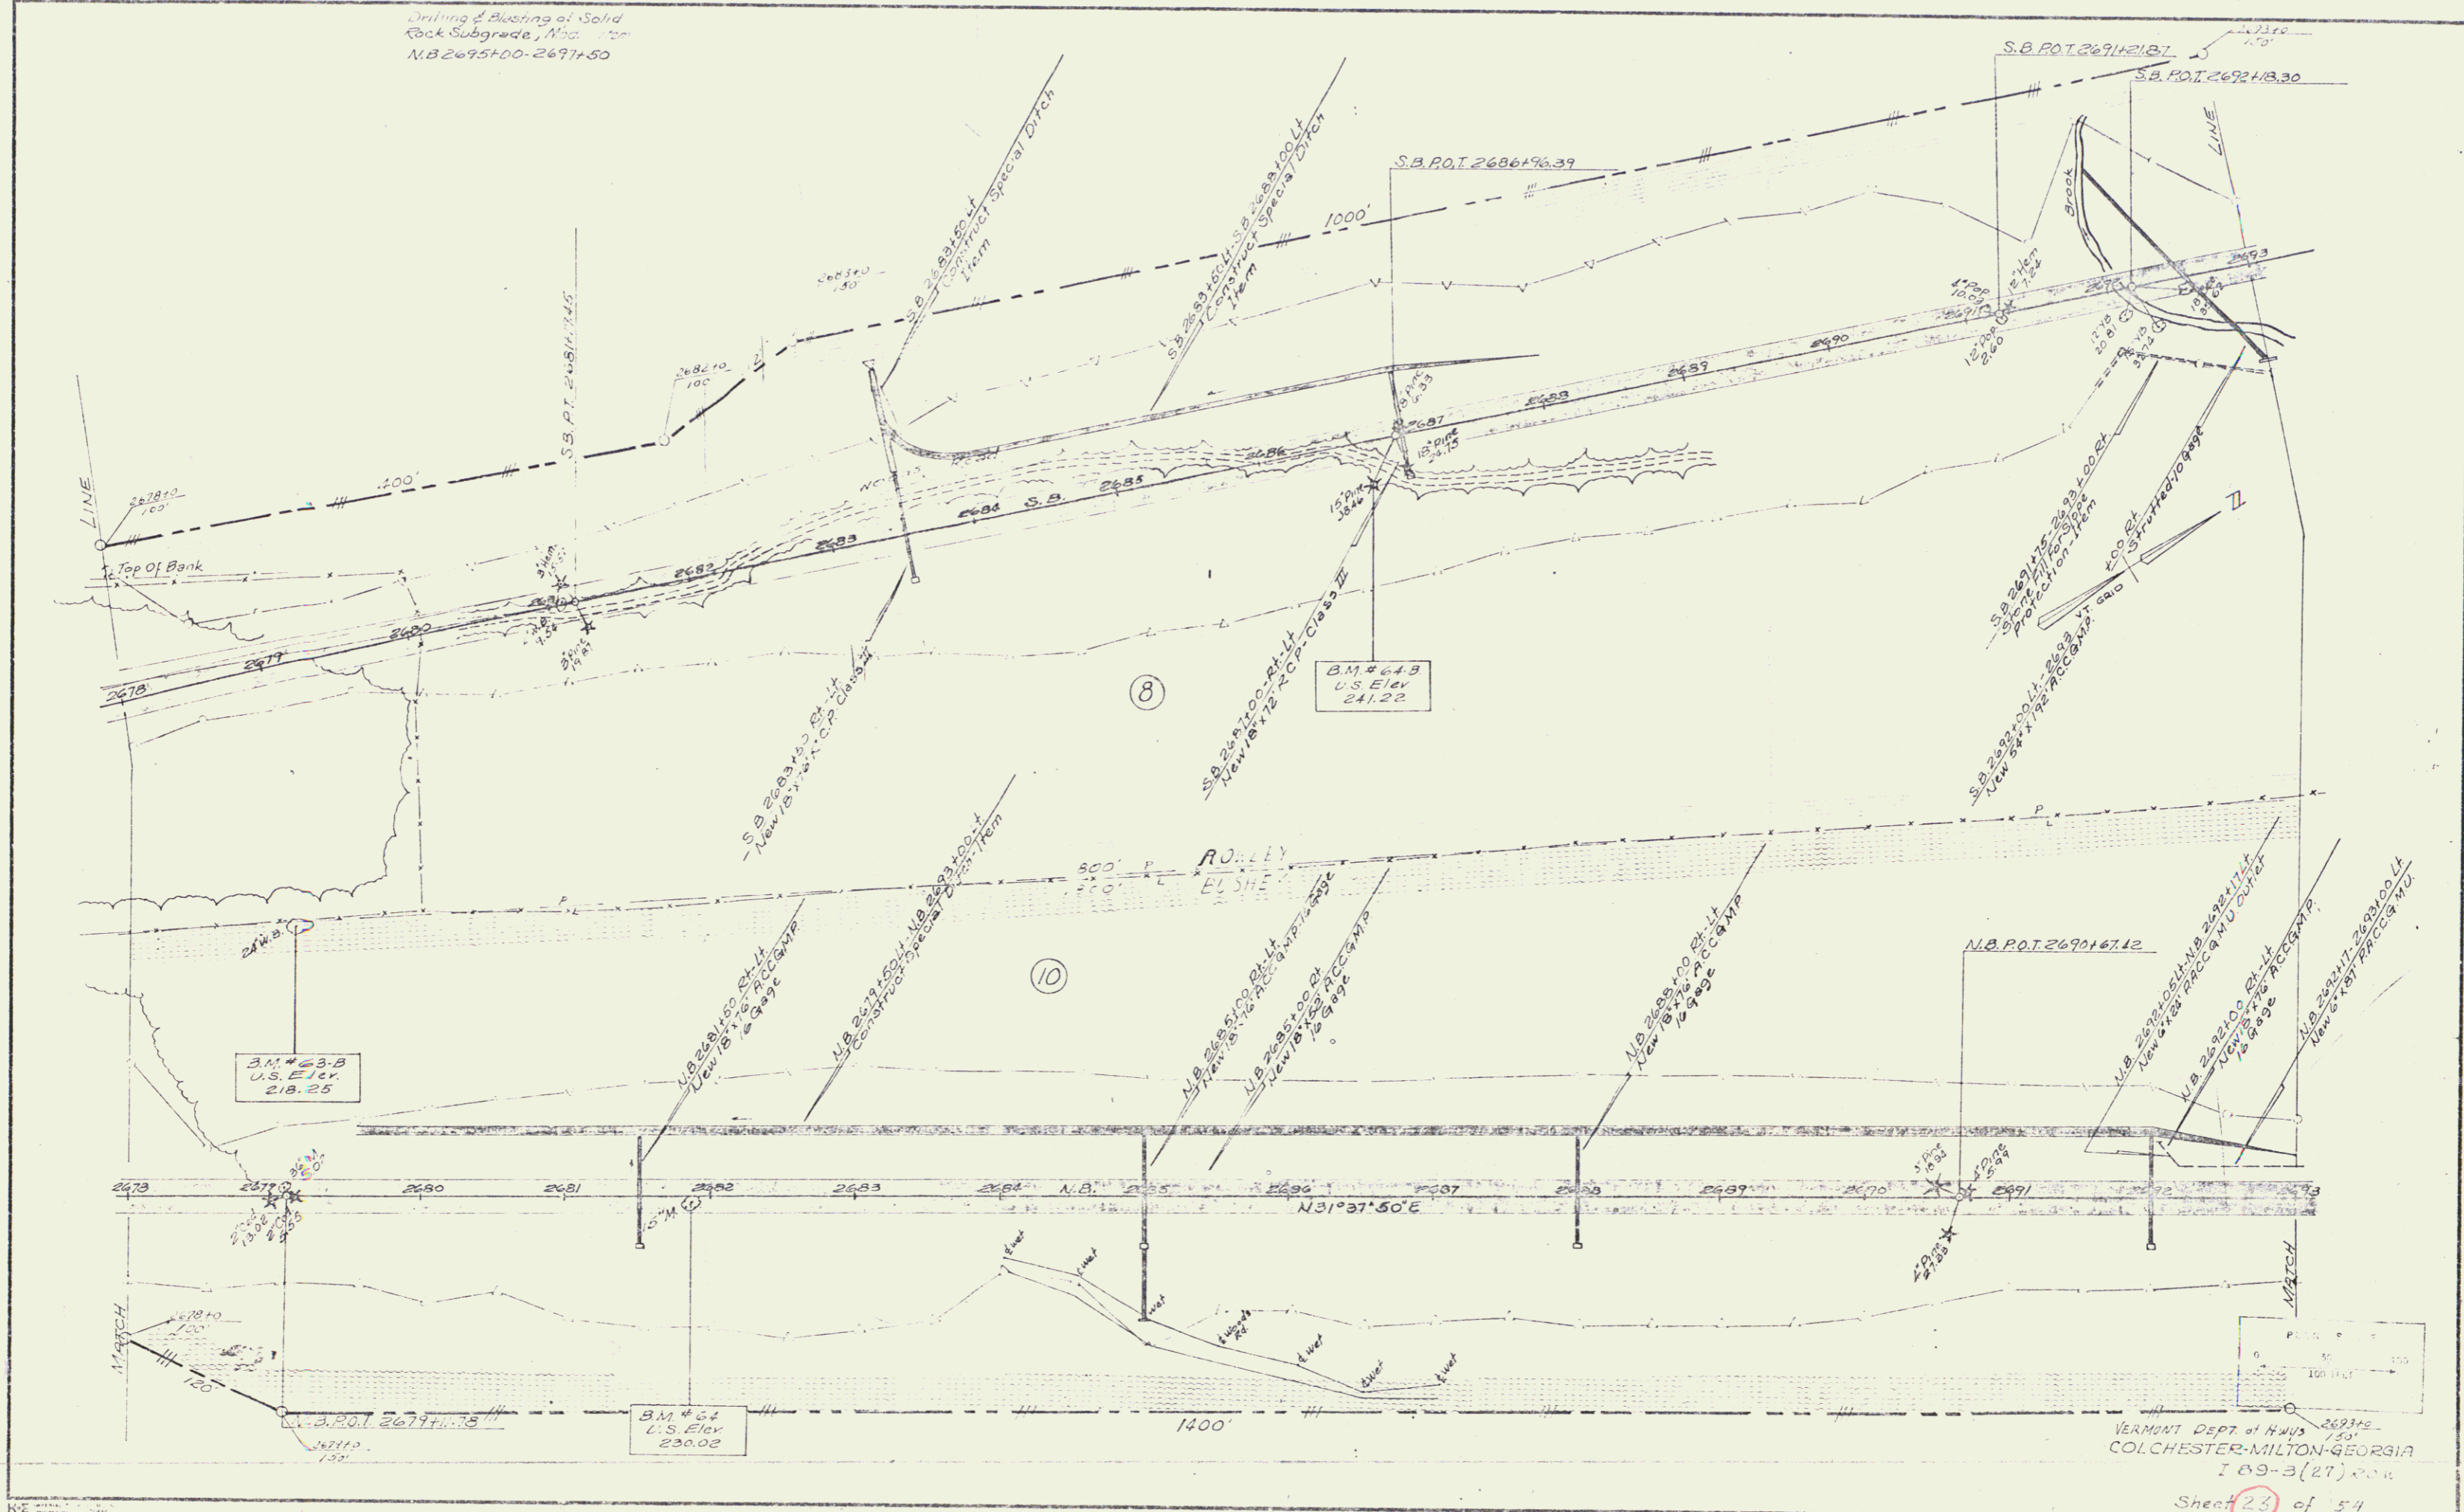

VERMONT DEPT. of HWYS
COLCHESTER-MILTON-GEORGIA
189-3(21) 2011
Sheet 23 of 54