


PLAN	Scale	1" = 40'
DATE	10/15/65	
BY		
CHECKED		
APPROVED		

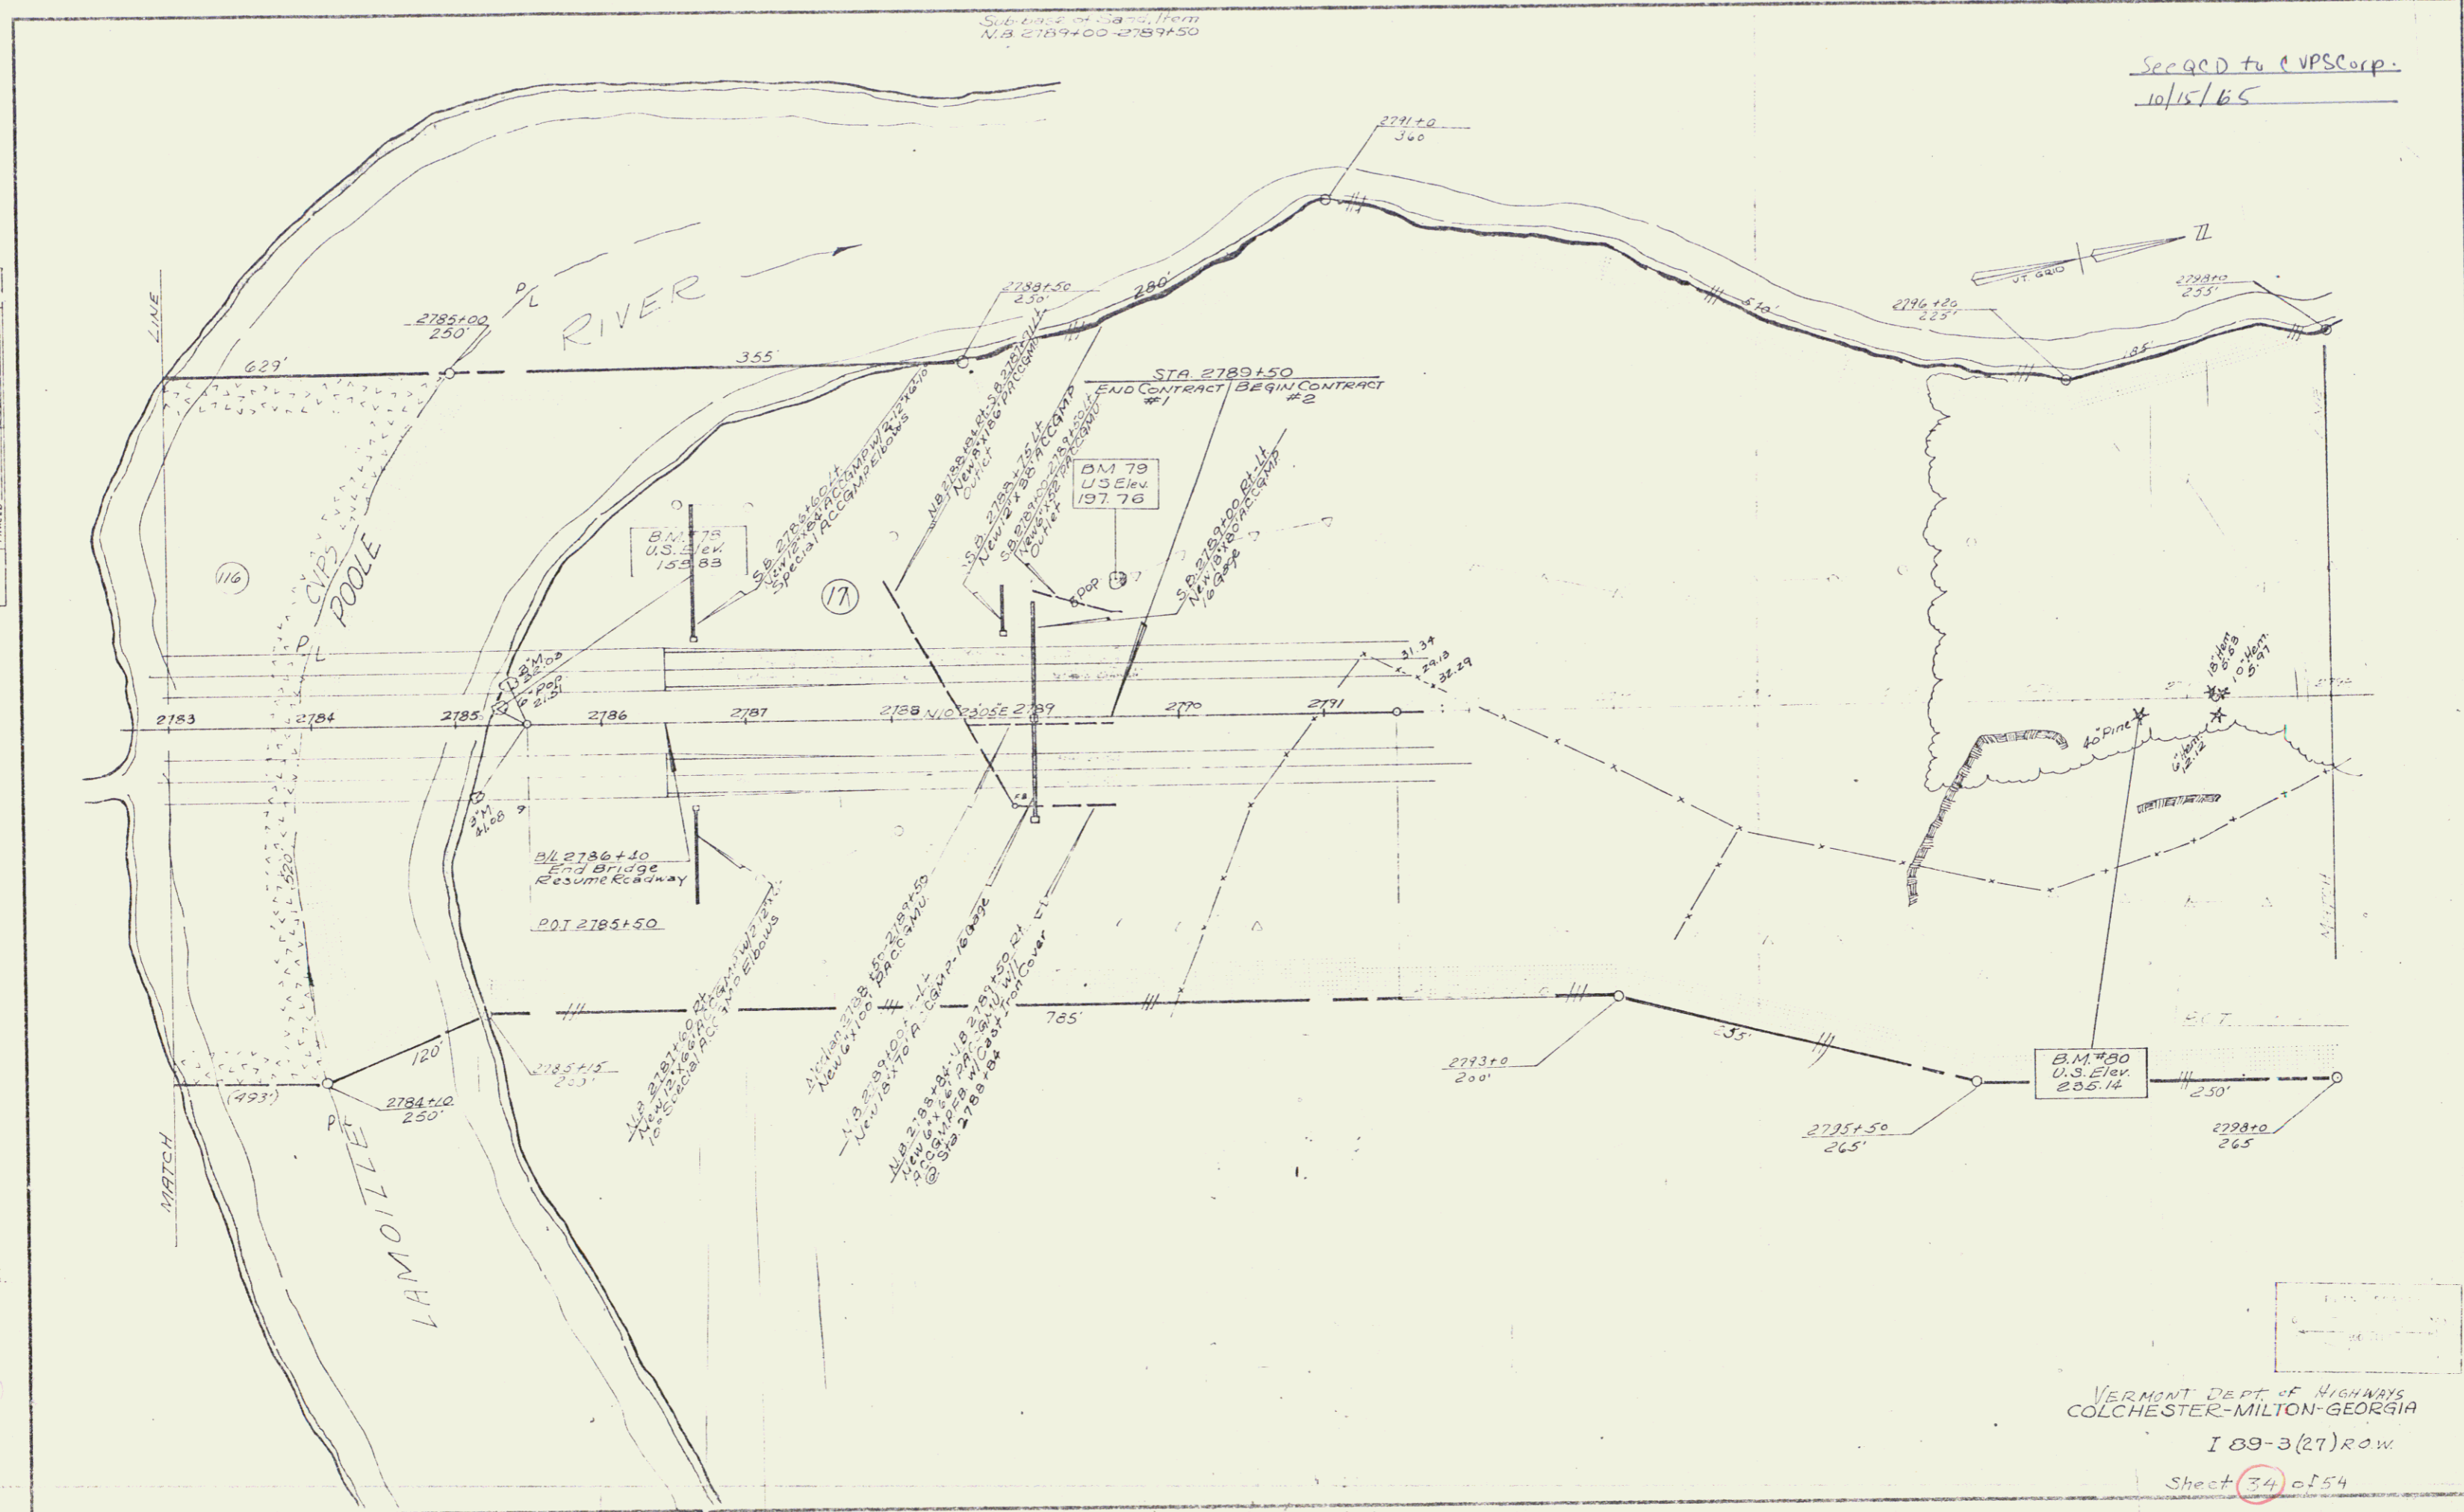

VERMONT DEPT. OF HIGHWAYS  
COLCHESTER-MILTON-GEORGIA  
I 89-3(27)ROW  
Sheet 34 of 54