


PLAN
 27
 28
 29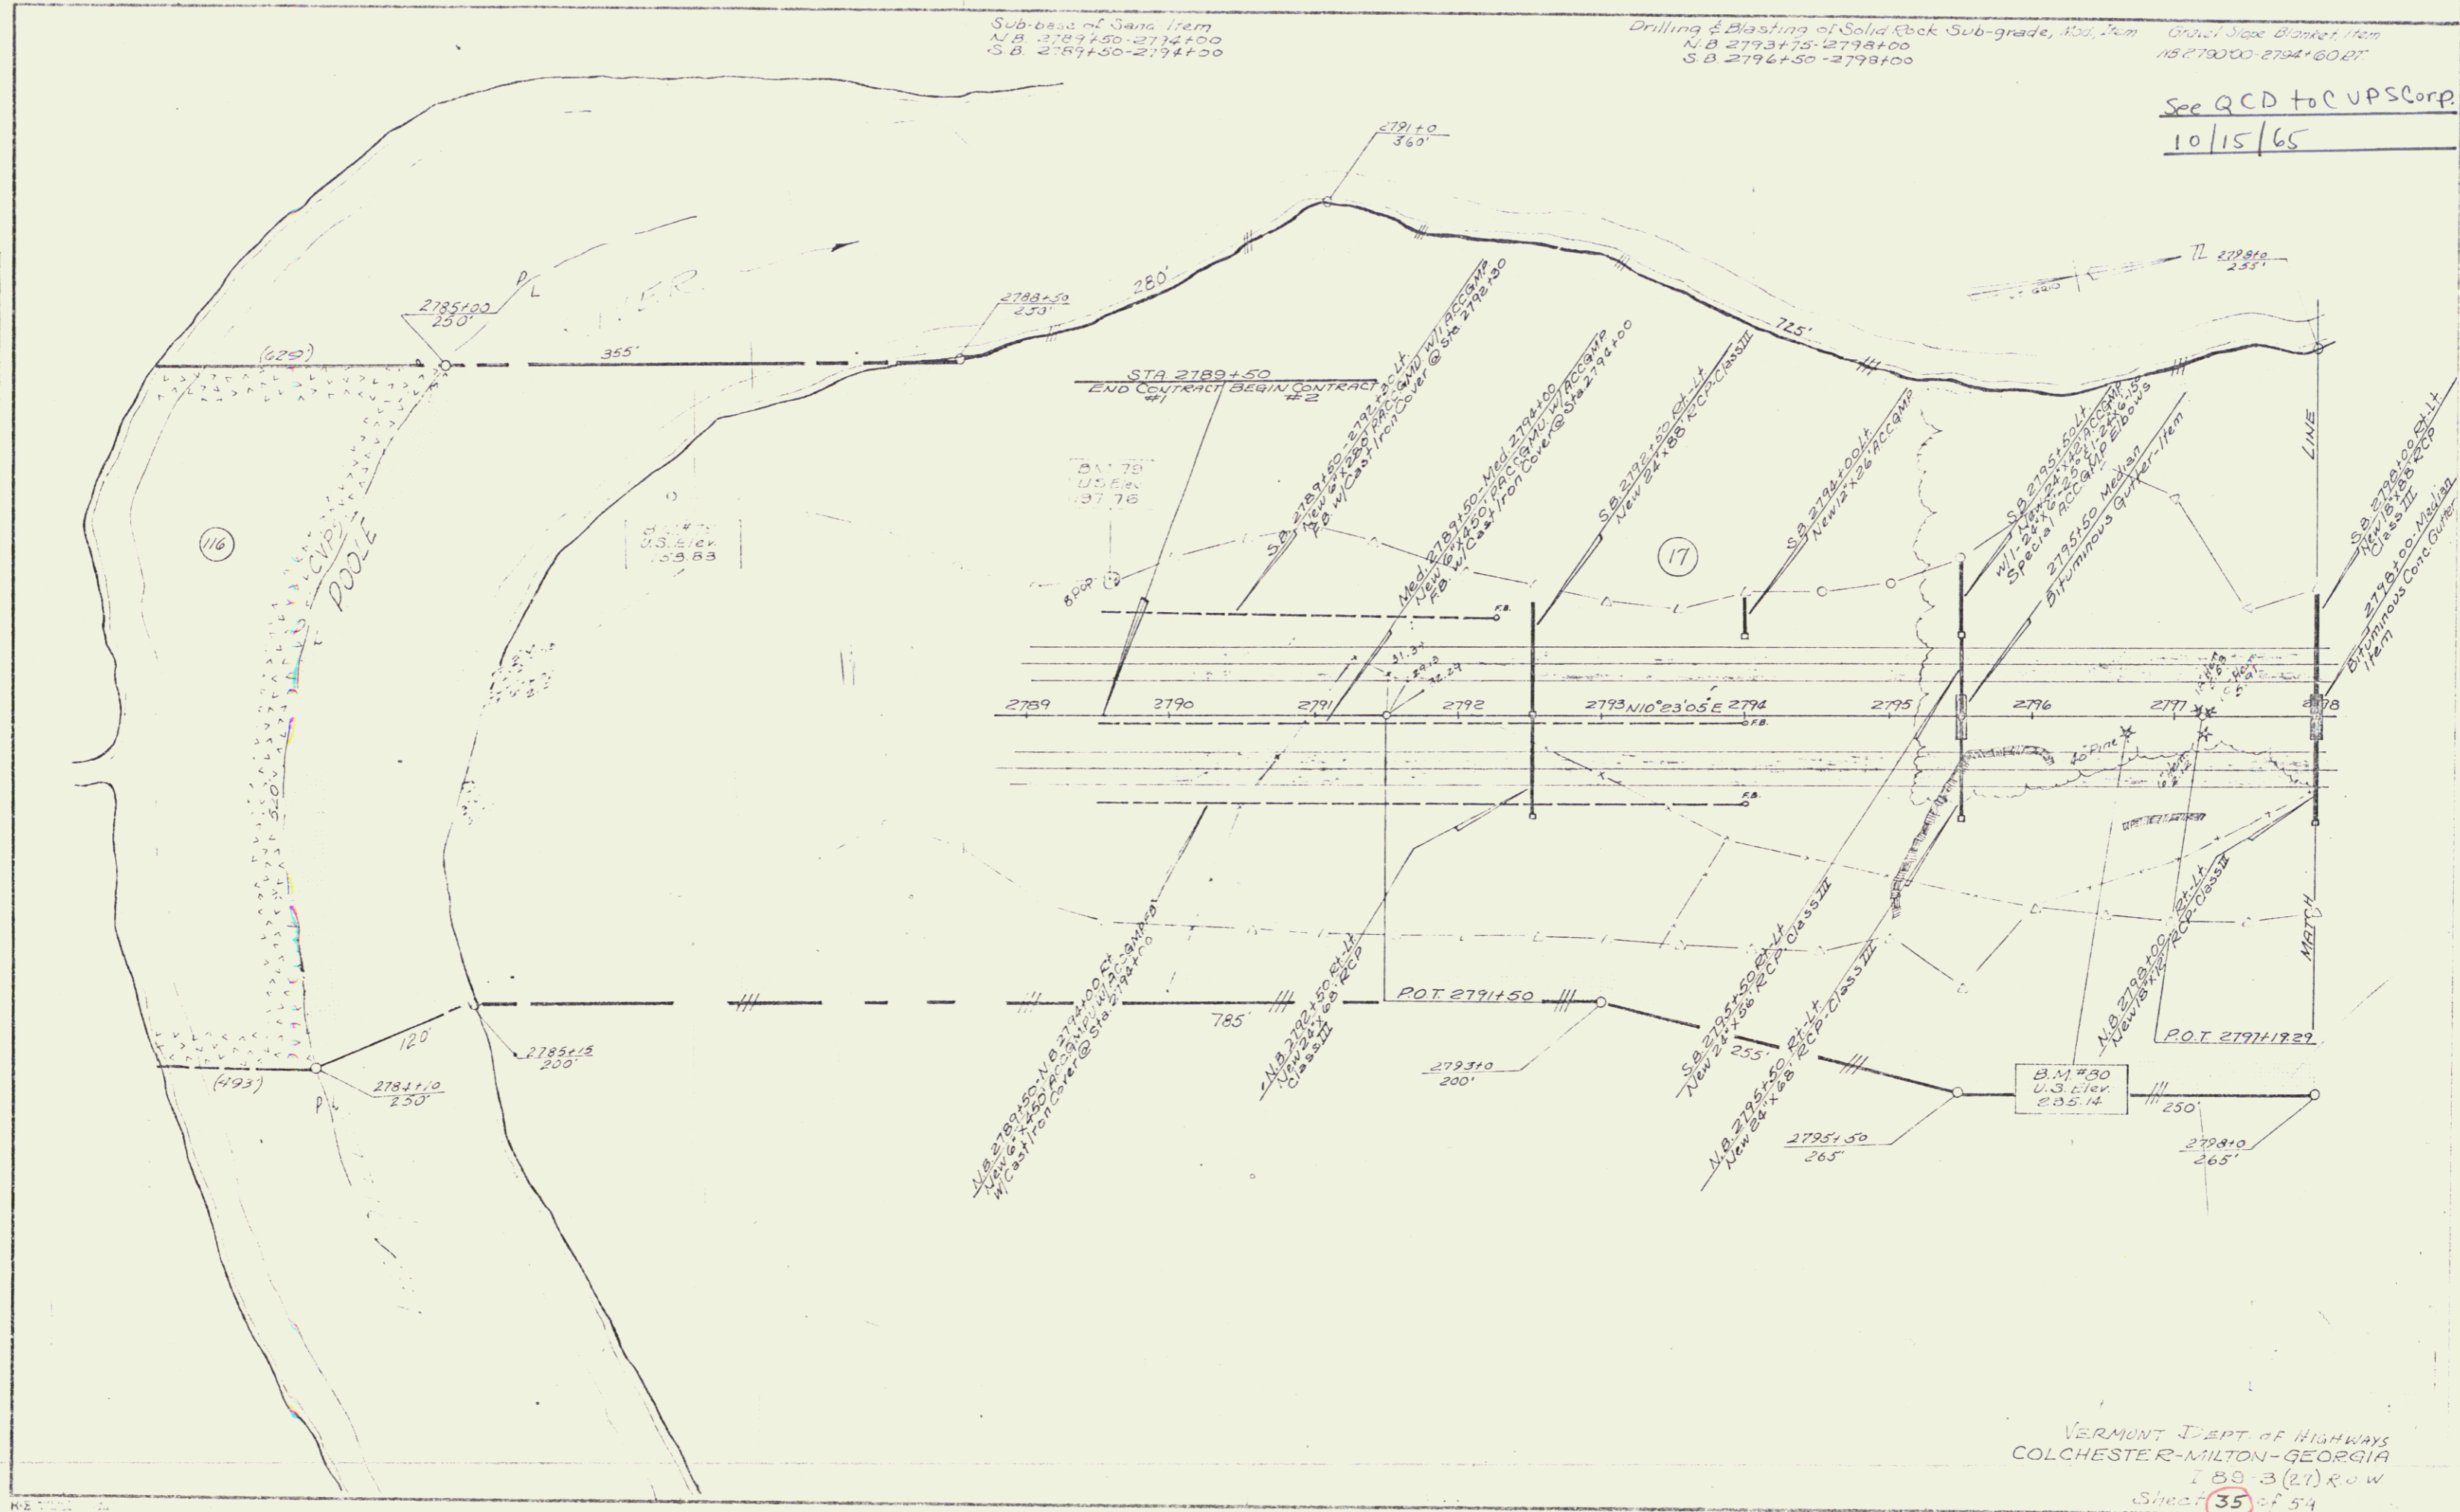
Sub-base of Sand Item
 N.B. 2789+50-2794+00
 S.B. 2789+50-2794+00

Drilling & Blasting of Solid Rock Sub-grade, 100' x 20'
 N.B. 2793+75-2798+00
 S.B. 2796+50-2798+00

Gravel Base Blanket Item
 18' 2790+00-2794+80.00
 See QCD to CVPSCorp
 10/15/65

VERMONT DEPT. OF HIGHWAYS
 COLCHESTER-MILTON-GEORGIA
 I 89-3 (21) R.O.W.
 Sheet 35 of 54