


PLAN
 DATE: 10/27/54
 DRAWN BY: J. W. GIBSON
 CHECKED BY: J. W. GIBSON
 NO. 1012

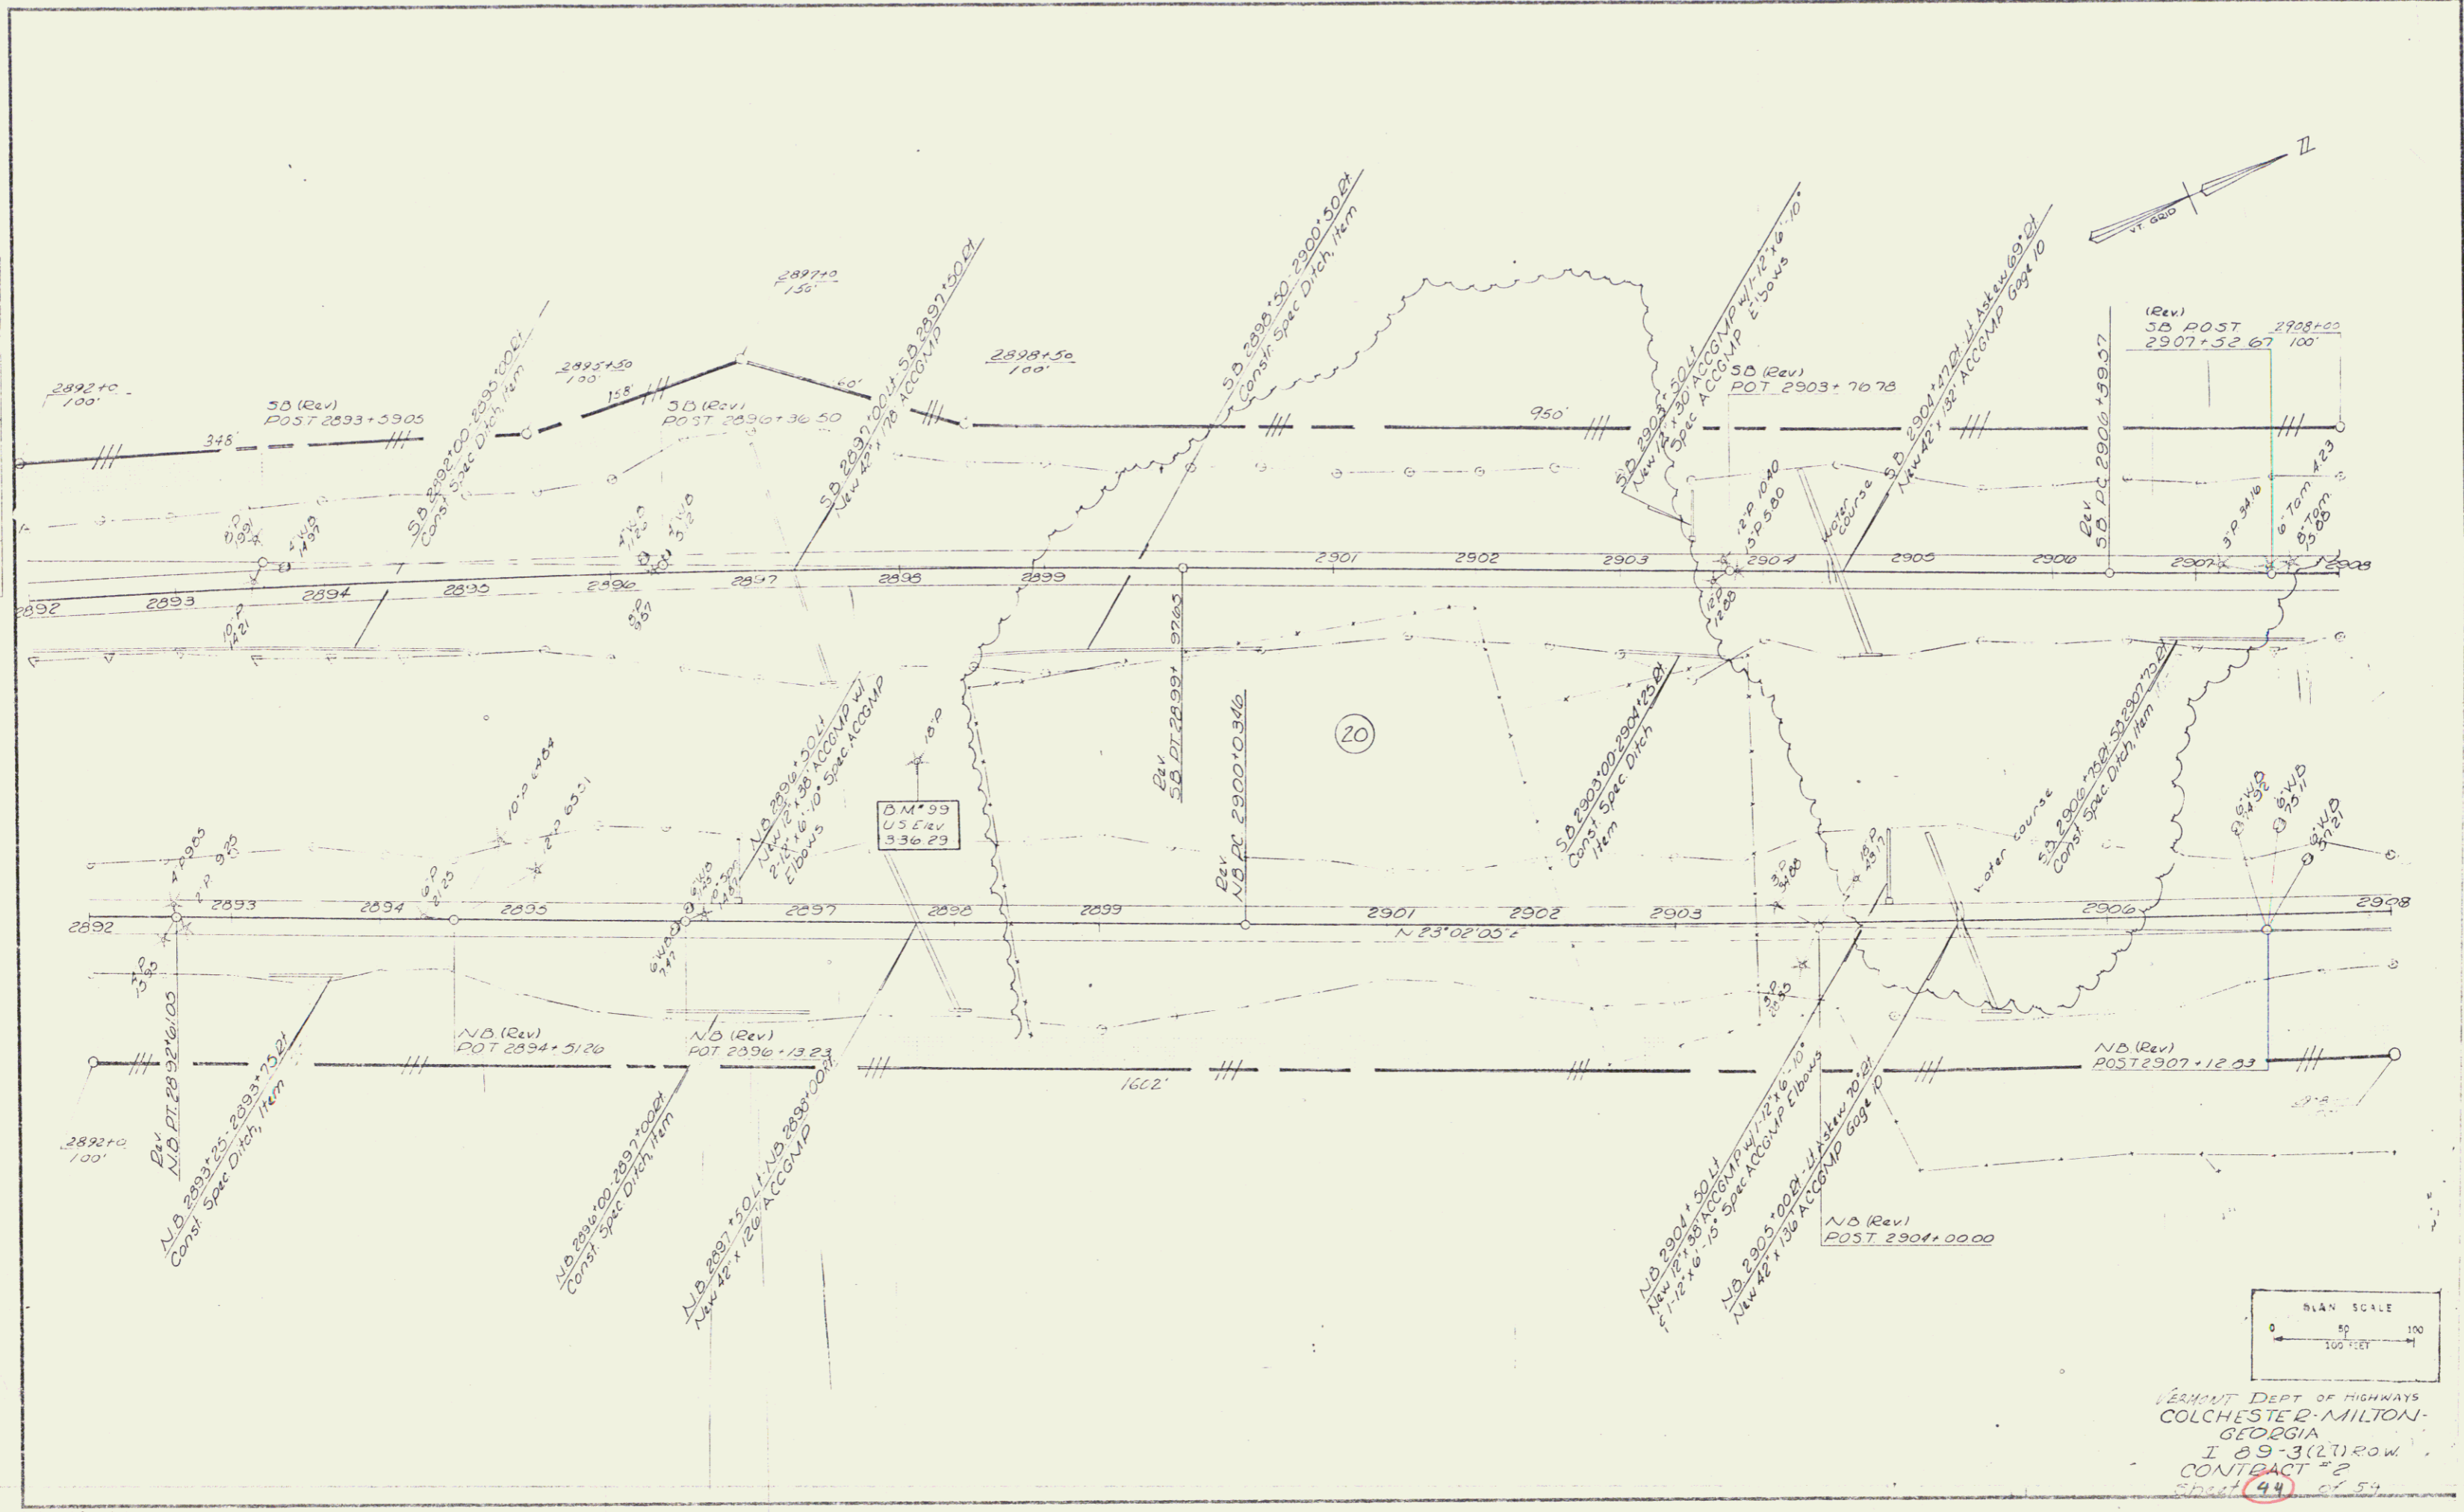

DEPT. OF HIGHWAYS
 COLCHESTER-MILTON
 GEORGIA
 I 89-3(2) ROW
 CONTRACT #2
 SHEET (44) OF 54