


DATE: 11/17/12
NB 2947+00 - 2948+00 (1/4)

PLAN	NO. 37
DATE	11/17/12
BY	...
CHECKED	...
SCALE	AS SHOWN
PROJECT	...
NO.	...

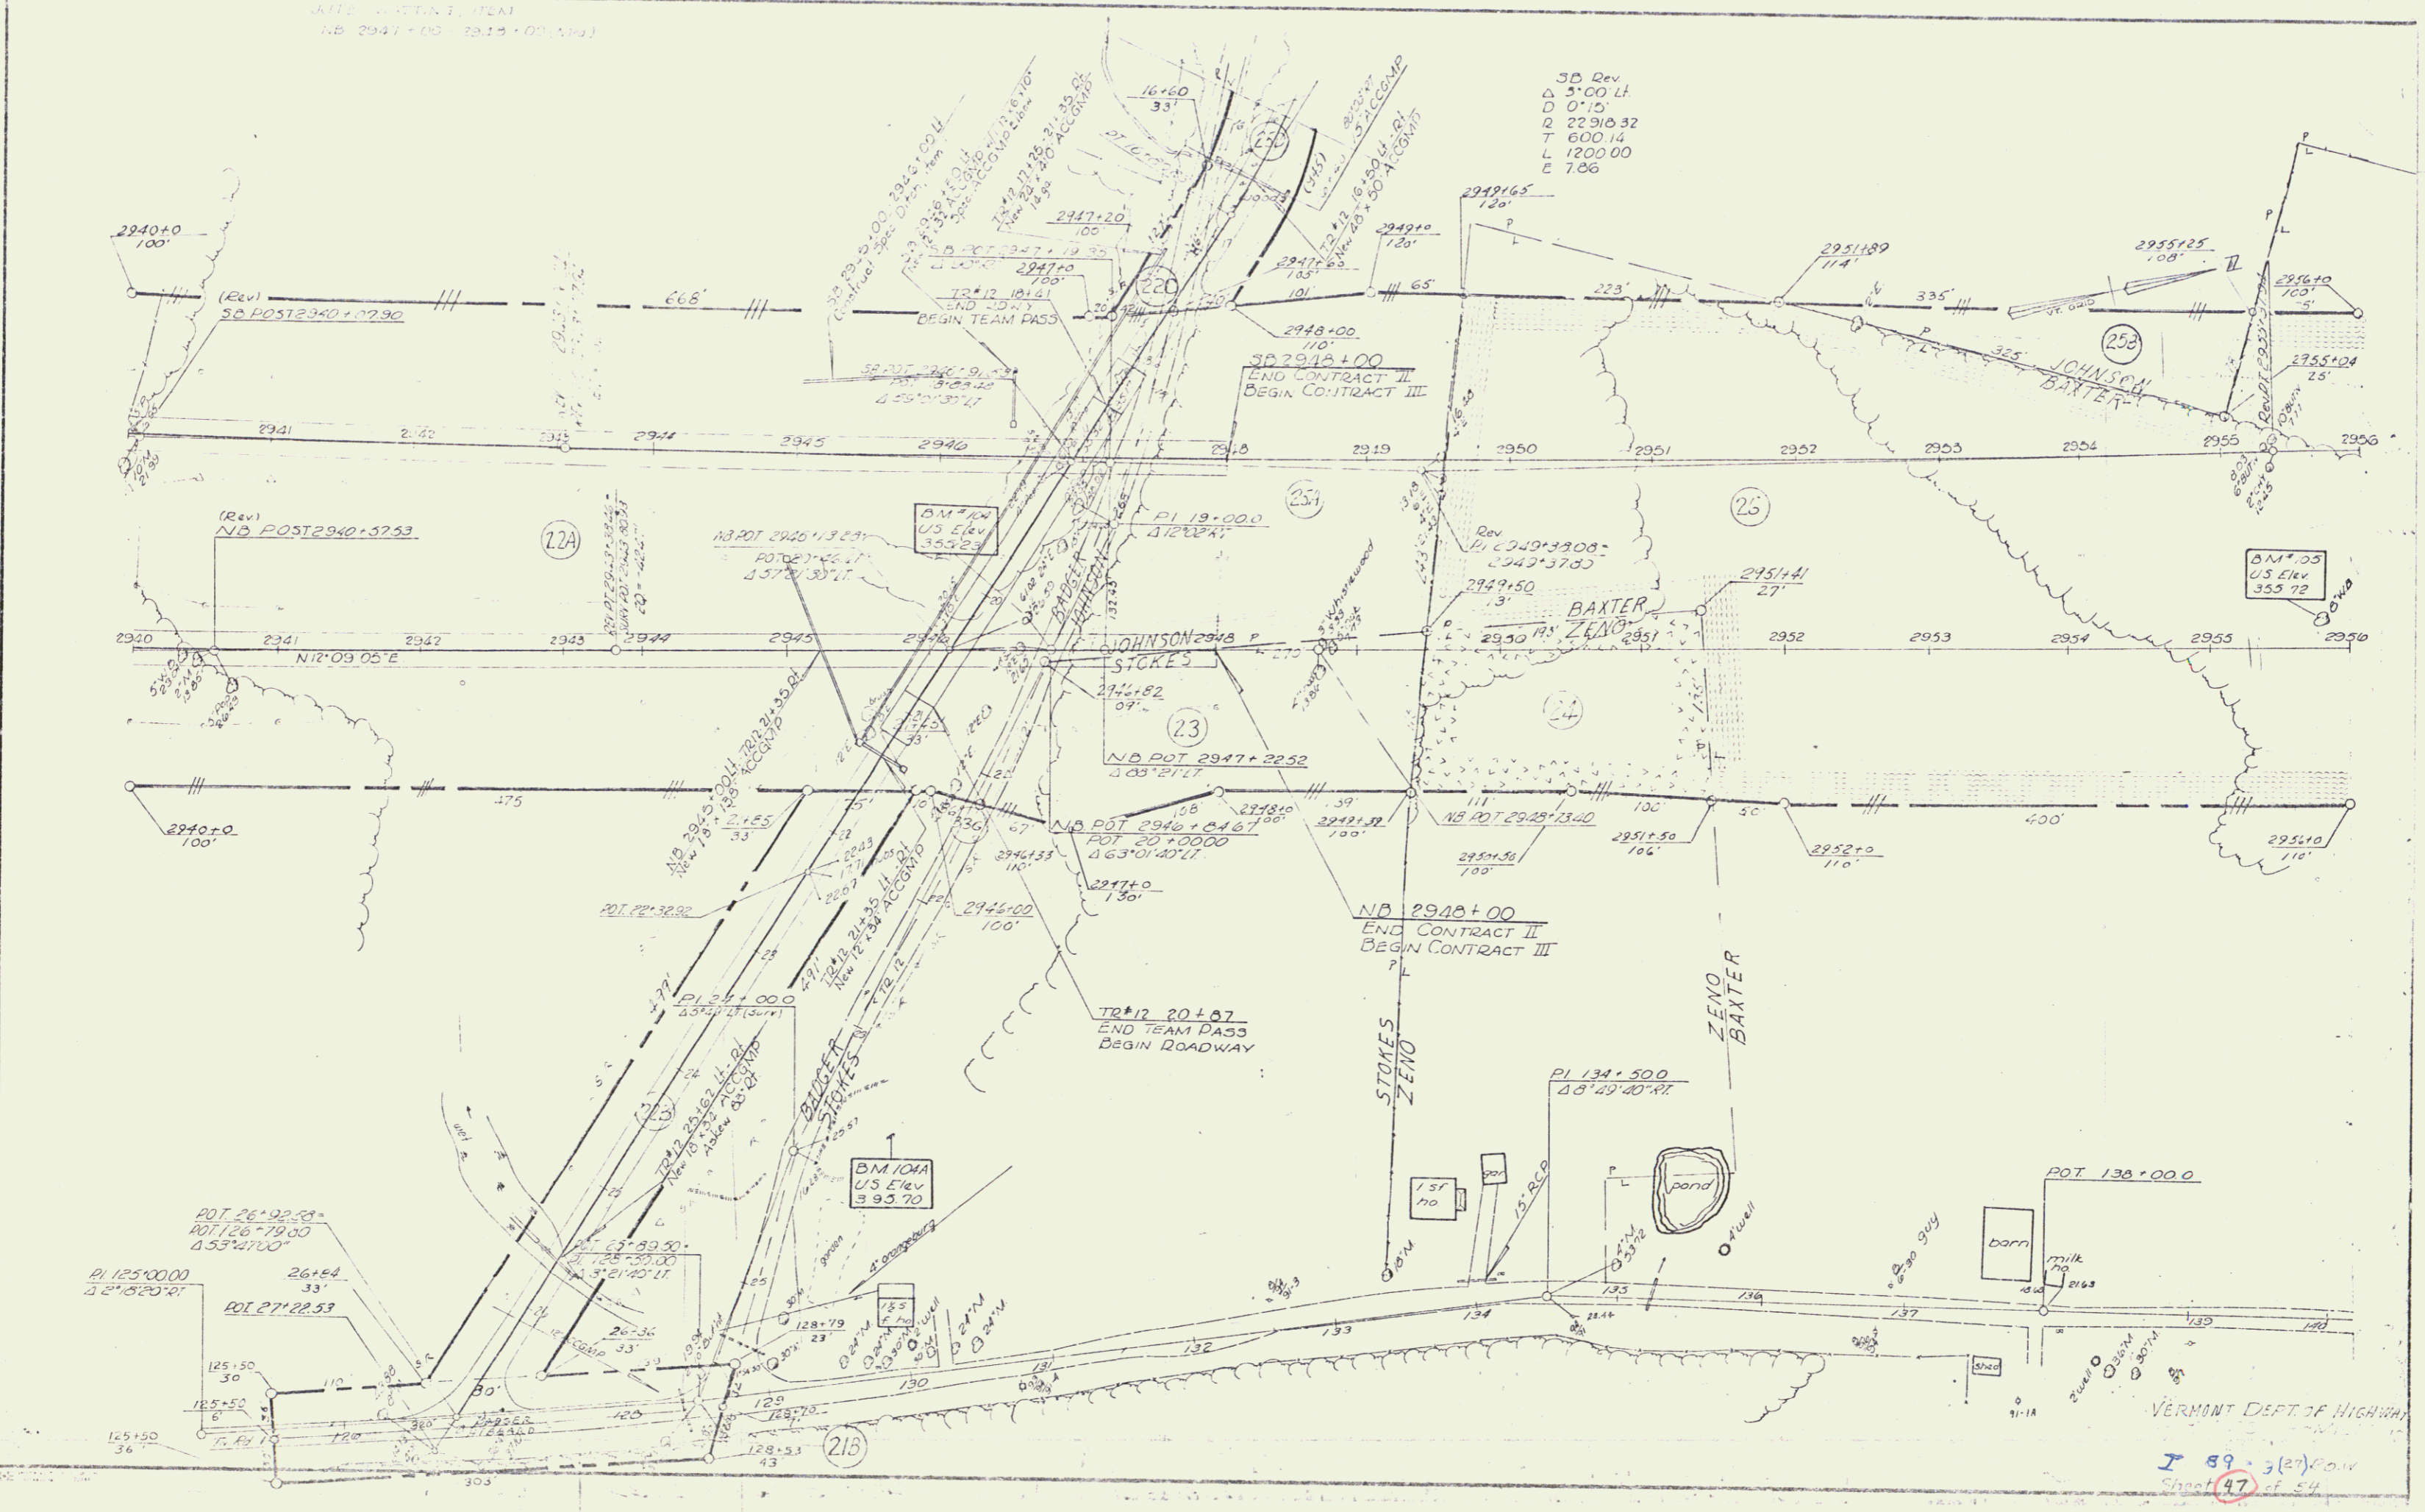

35 Rev
Δ 5'00 Lt
D 0'15'
R 2291032
T 600.14
L 1200.00
E 7.06

VERMONT DEPT OF HIGHWAYS
I 89 3(27) ROW
Sheet 47 of 54