


PLAN	Surveyed	10/15
	more about	
	design	
	check	
	draw	
	print	

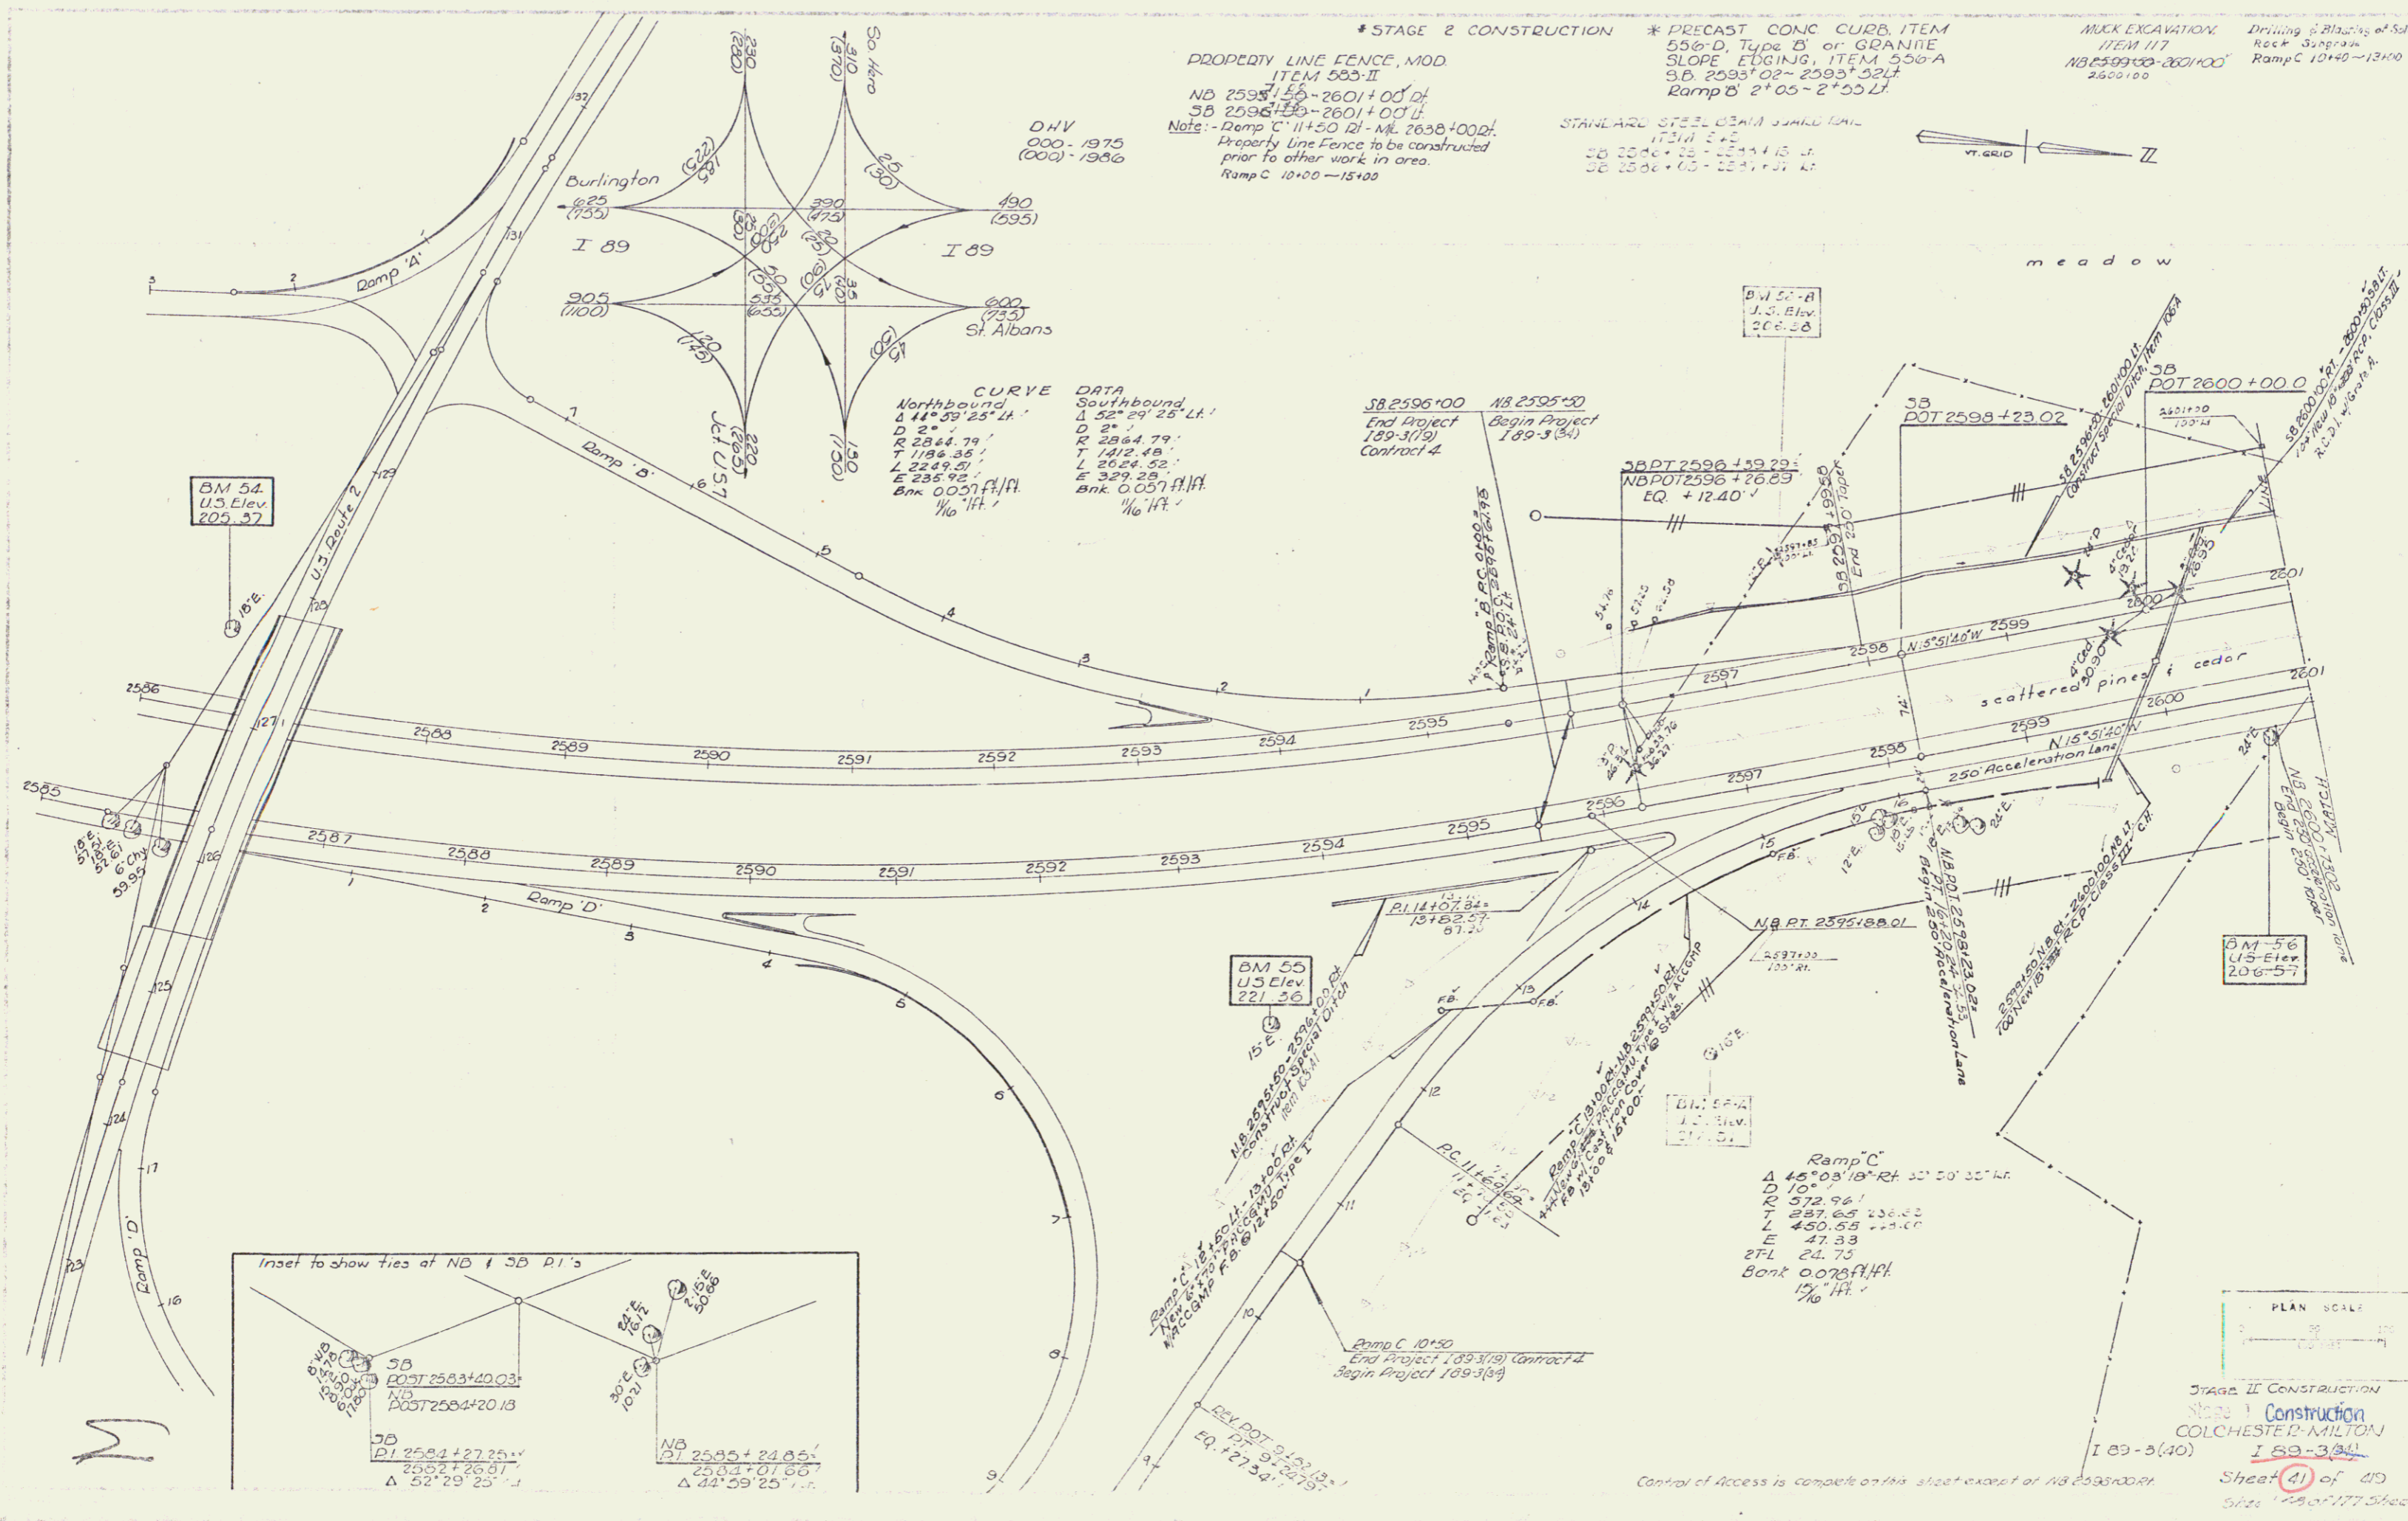

PLAN SCALE  
0 20 40  
1" = 20'

STAGE II CONSTRUCTION  
Stage I Construction  
COLCHESTER-MILTON  
I 89-3(10)  
Sheet 41 of 49  
5/12/12 of 177 Sheets