

PLAN	REV	DATE
REVISION		
BY		
CHECKED		
DATE		


WATER SOURCES
 Type Station Offset
 Dug well SB 2612* 1800' Lt
 Drilled well NB 2601* 900' Rt
 Old dug well NB 2610* 300' Rt

MUCK EXCAVATION
 ITEM 117 1+50
 NB 2601+00-2602+00
 NB 2601+50-2607+79.50

PROPERTY LINE FENCE MOD.
 ITEM 503-II
 NB 2601+00-2617+00 Rt
 SB 2601+00-2617+00 Lt

STANDARD STEEL BEAM
 GUARD RAIL W/STEEL
 POSTS ITEM 545A
 SB 2606+30-2606+70 Lt
 NB 2607+80-2608+20 Rt
 SB 2609+90-2610+98 Lt

STAGE 2 CONSTRUCTION

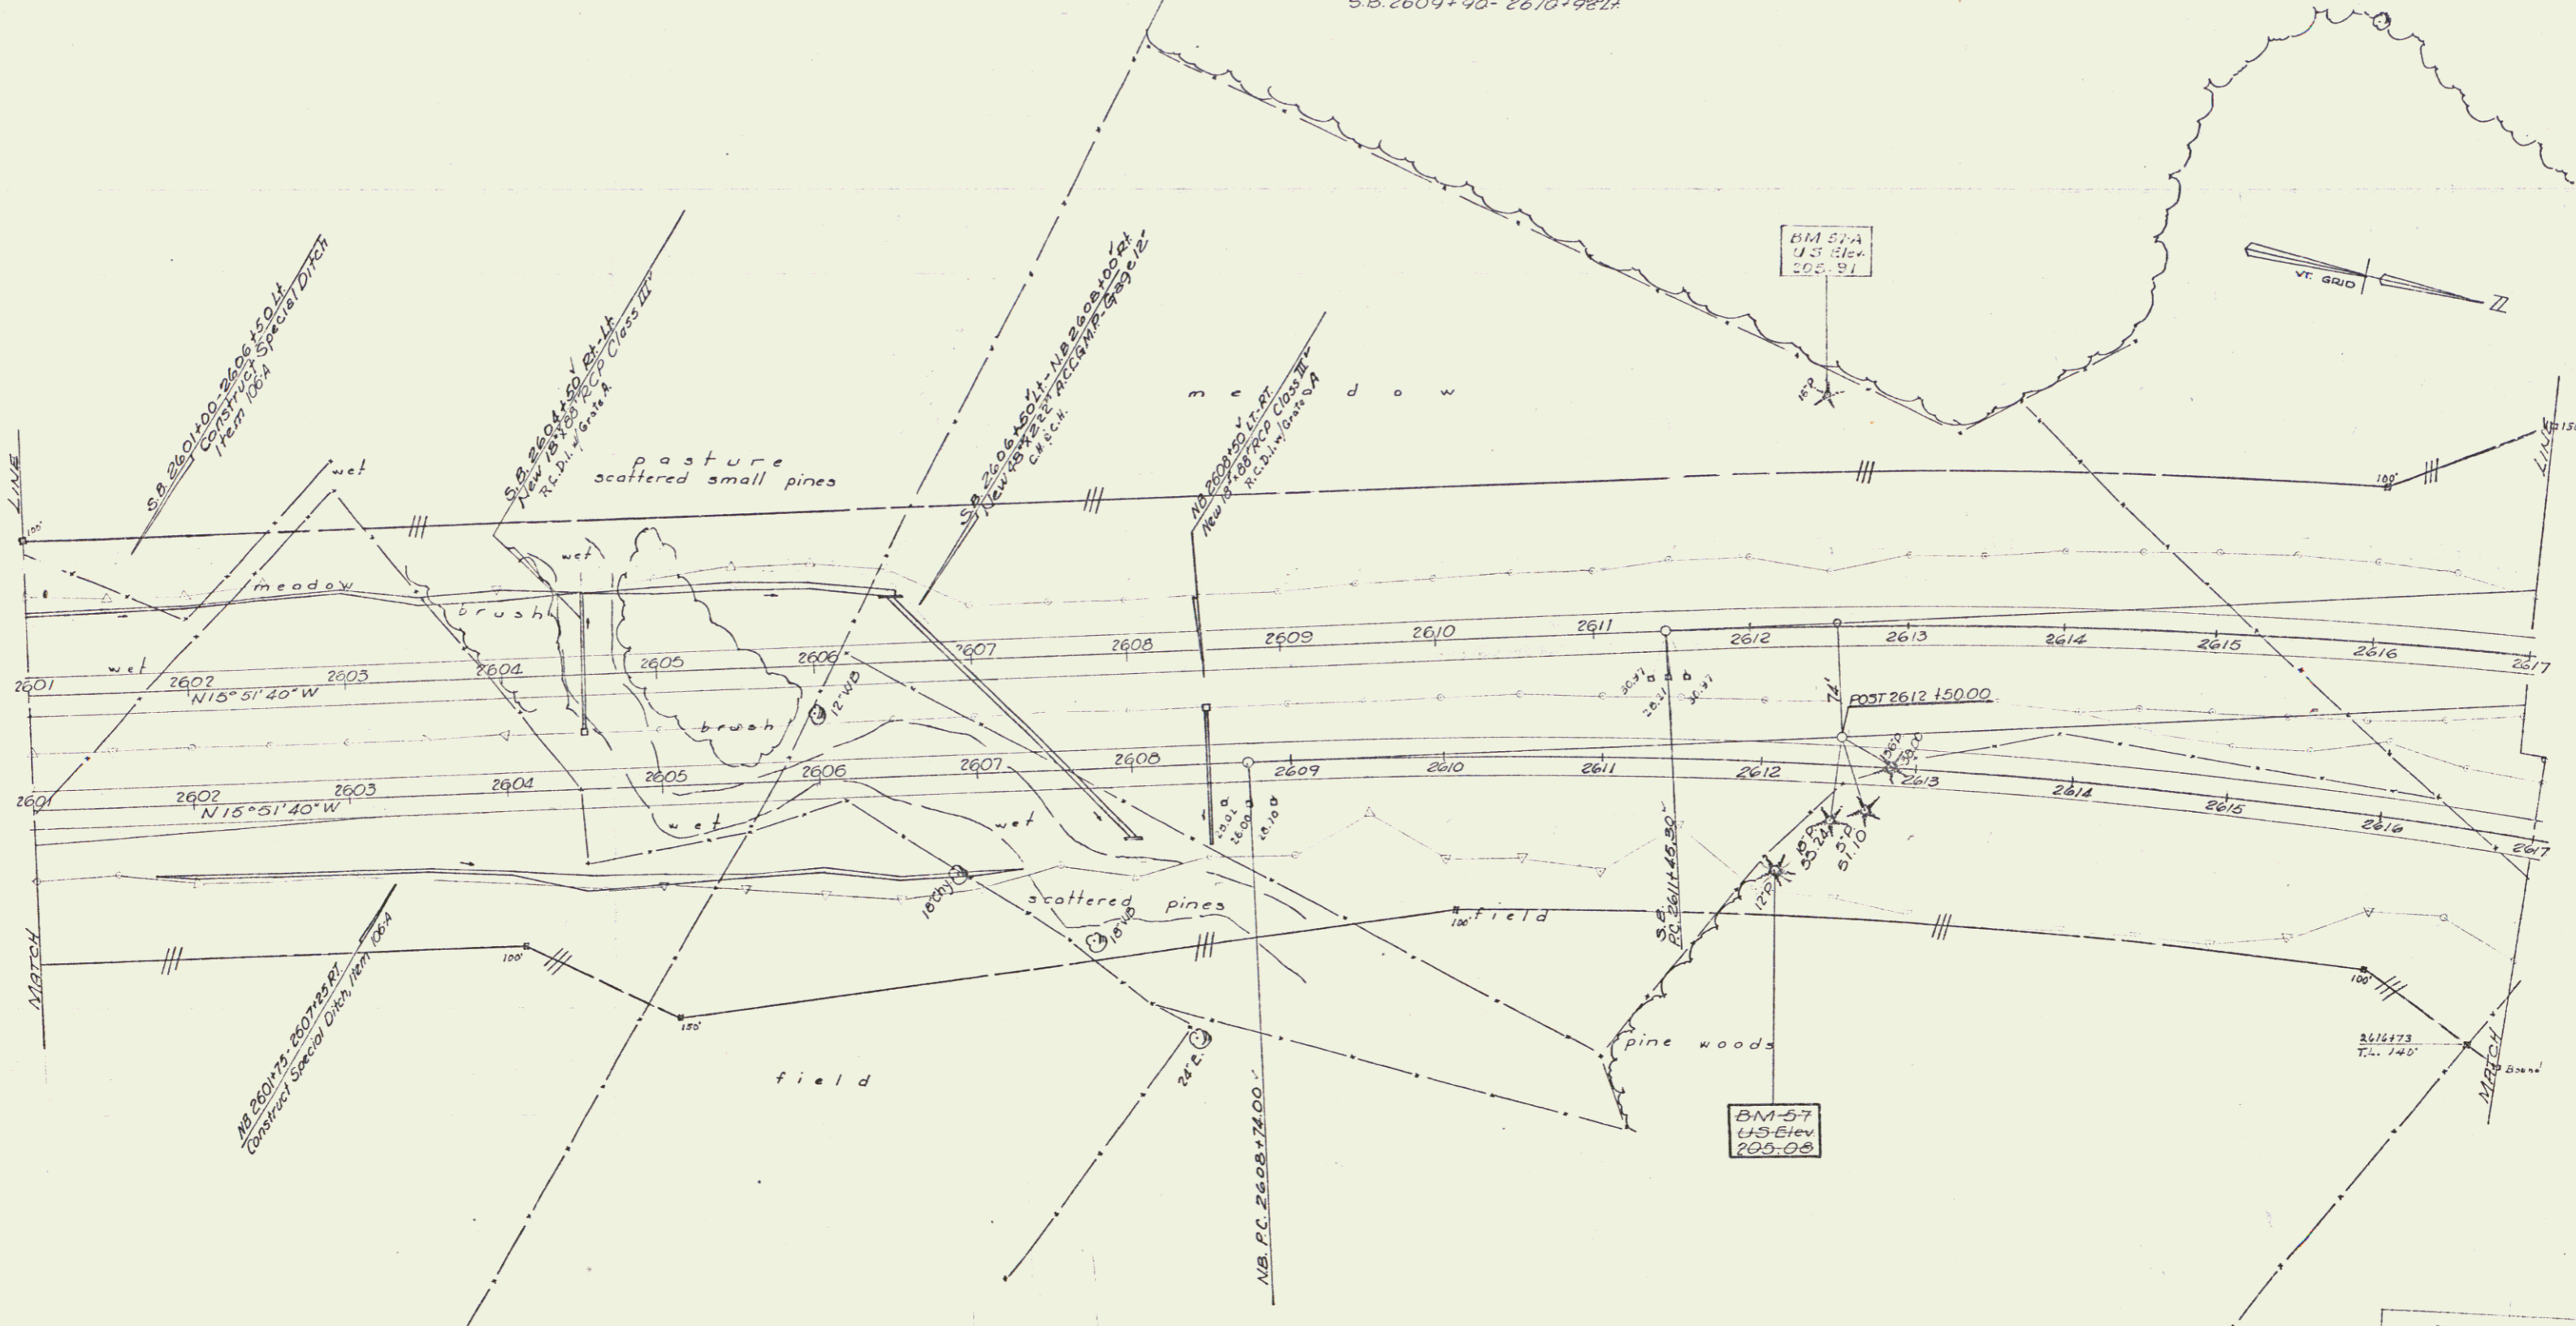

SB 2601+00-2606+30 Lt
 Construct Special Ditch from 100' from 100'

SB 2601+50-2607+79.50 Lt
 Construct Special Ditch from 100'

SB 2606+30-2606+70 Lt
 Construct Special Ditch from 100'

NB 2601+00-2617+00 Rt
 Construct Property Line Fence

NB P.C. 2608+74.00'

Stage I Construction
 COLCHESTER-MILTON
 189-3(34) 100-5(40)
 Sheet 43 of 419
 See 40 of 177 Sheets

Control of Access is complete on this sheet

STAGE II CONSTRUCTION