
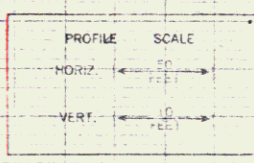
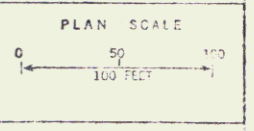


PLAN  
 SHEET NO. 5/63  
 PROJECT Austin  
 DATE 6/63  
 DRAWN W.C.

PROFILE  
 SHEET NO. 5/63  
 PROJECT Austin  
 DATE 6/63  
 DRAWN W.C.

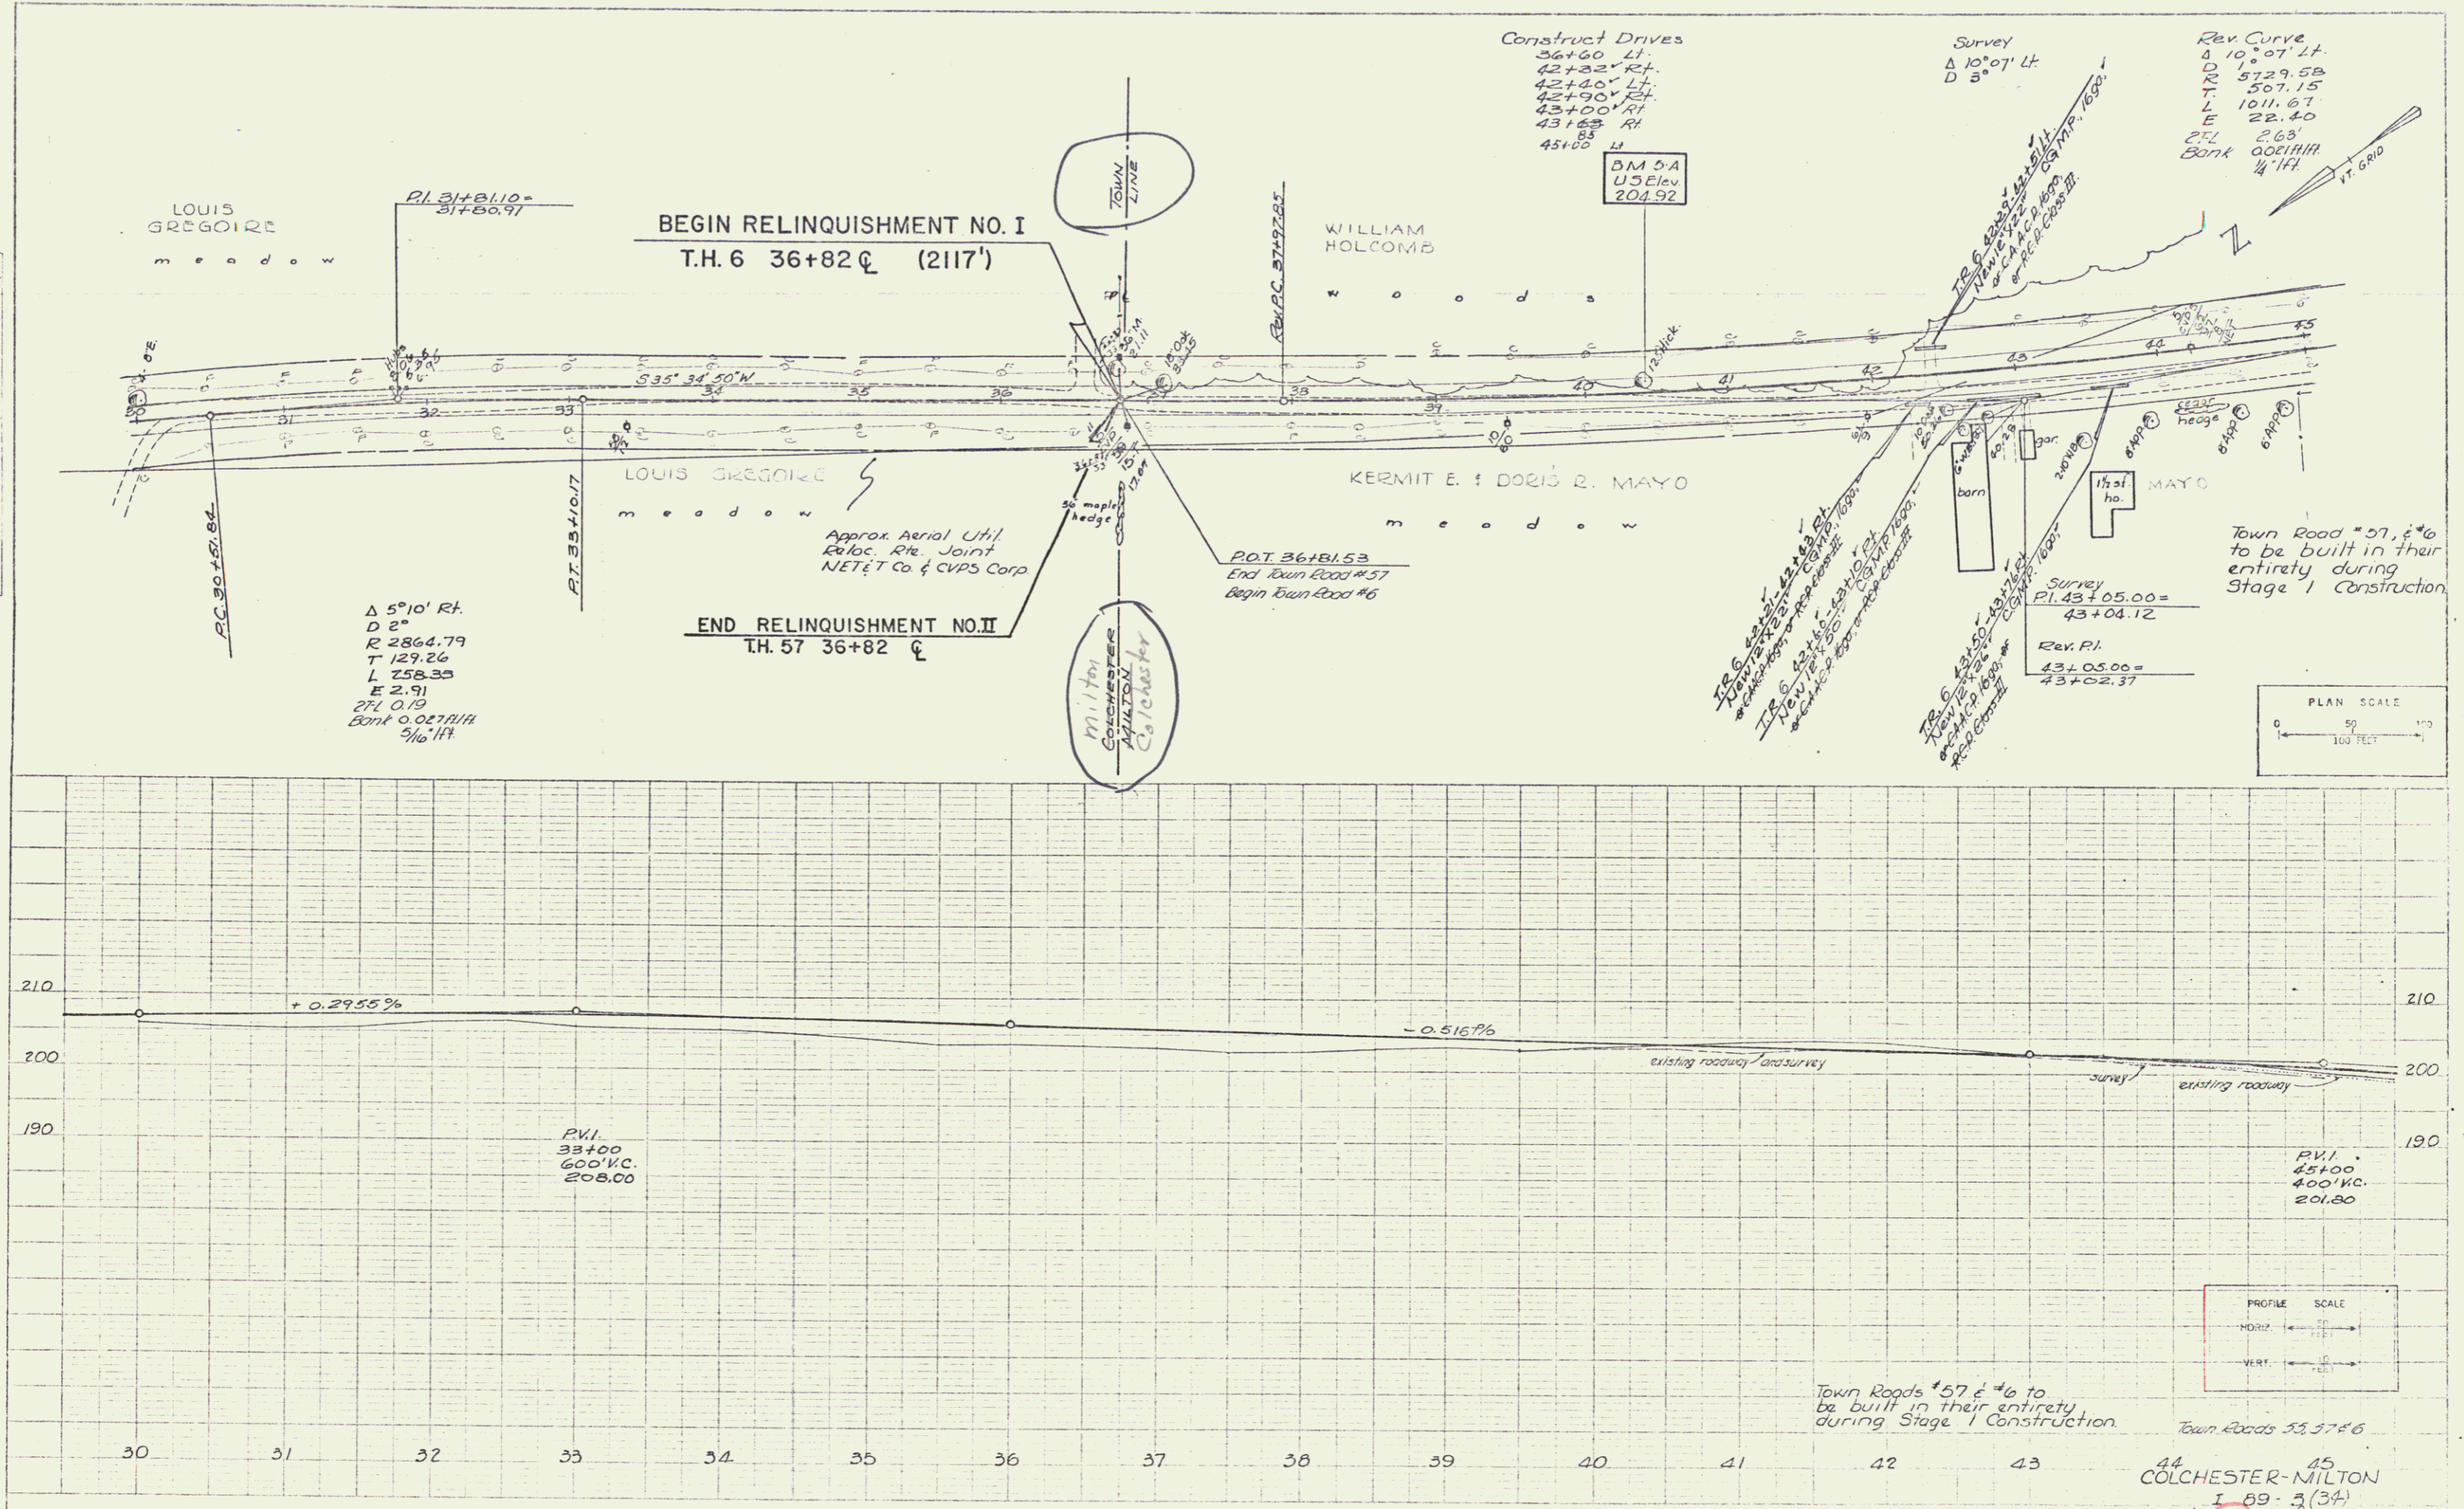

Town Roads #57 & #6 to be built in their entirety during Stage I Construction  
 Town Roads 55, 57 & 6  
 44 COLCHESTER-MILTON  
 1 89-3 (37)  
 Sheet 58 of 49

65