


WATER SOURCES
 Type Station Offset
 Spring SB 2655+50 1800± Lt.
 Spring SB 2656± 1800± Lt.
 Drilled well SB 2662± 2200± Rt.

* THREE CABLE GUARD RAIL
 w/ STEEL POSTS, ITEM 542
 N.D. 2650+04-2654+20 Rt.


* STAGE 2 CONSTRUCTION

PROPERTY LINE FENCE, MOD
 ITEM 555-II
 ND 2648+00-2663+00 Rt.
 SB 2648+00-2663+00 Lt.

PLAN	DATE	BY	CHK
REVISED			
NOT FOR CONSTRUCTION			
NO. 10210			
DATE			
BY			
CHK			

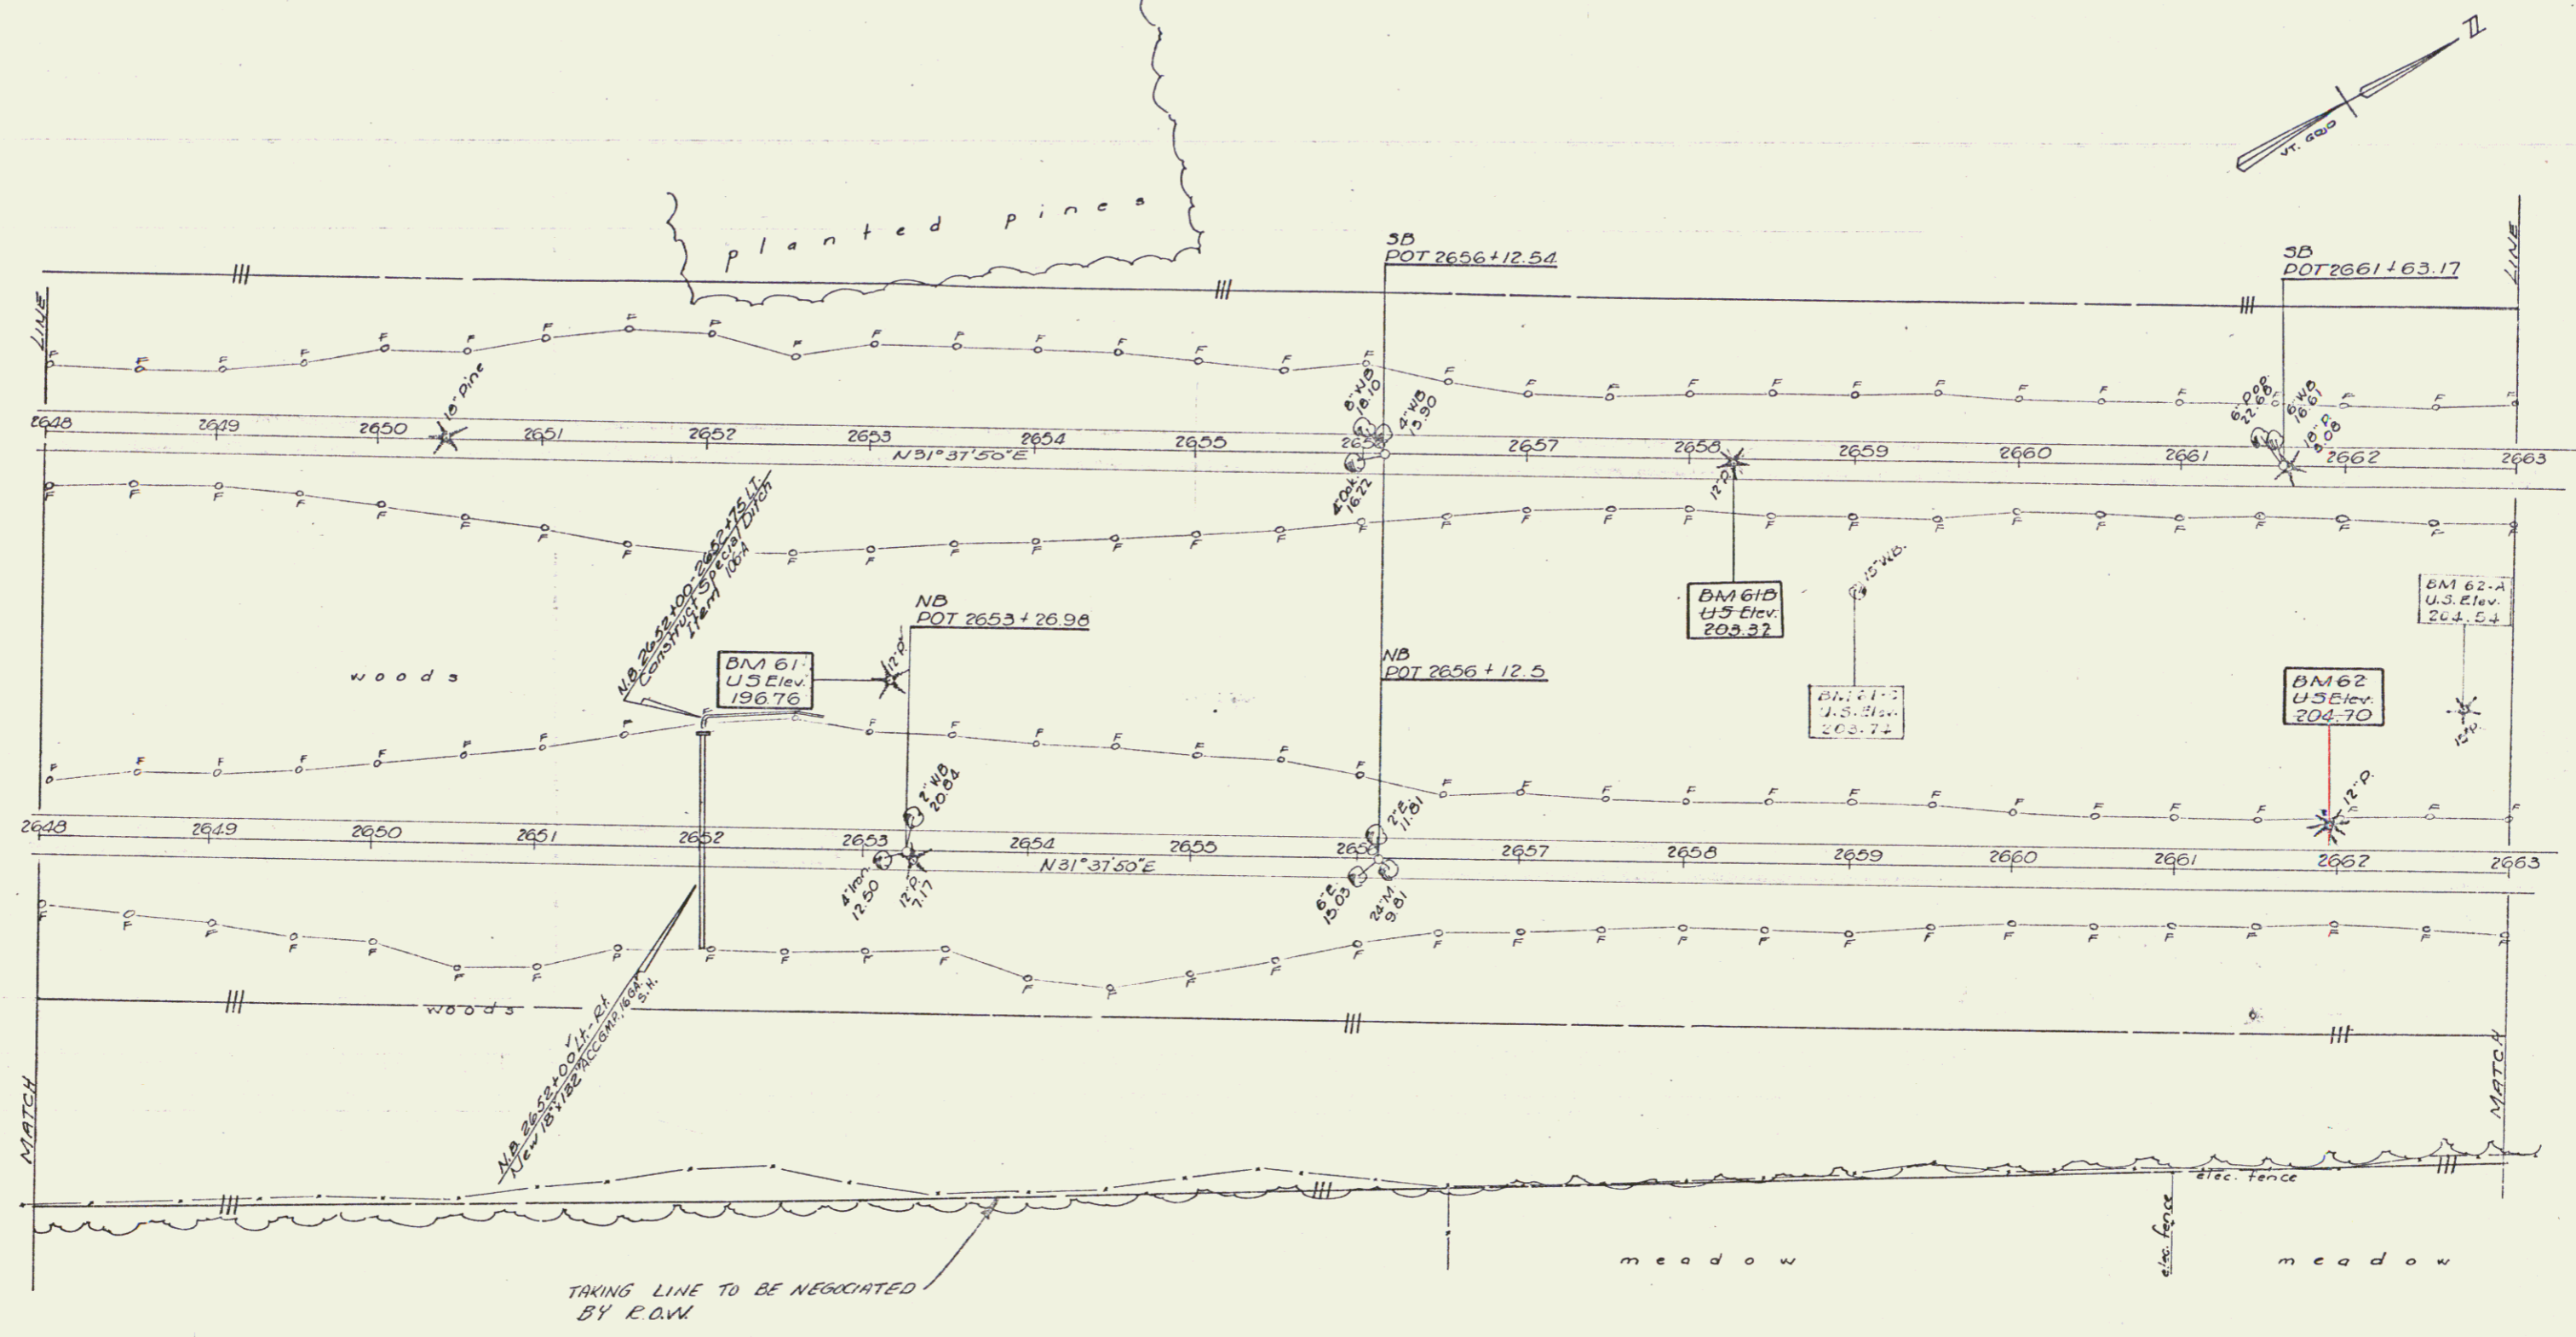

TAKING LINE TO BE NEGOTIATED
 BY R.O.W.

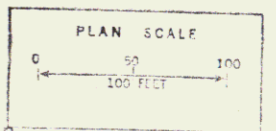

Stage 1 Construction
 COLCHESTER MILTON
 I 89-3(34) I 89-3(40)
 STAGE II CONSTRUCTION
 Control of Access is complete on this sheet
 Sheet 50 of 177 Sheets