

WATER SOURCES
 Type Station Offset
 Springs NB 2722+28 Rt & Lt
 and brook NB 2722+28 Rt & Lt

* THREE CABLE GUARD RAIL
 w/ STEEL POSTS, ITEM 542
 2709+00 - 2710+74 N.B. RT
 2721+68 - 2724+00 N.D. CH
 2728+80 - 2729+00 N.B. LT



* BITUMINOUS CONCRETE CURB
 ITEM 555
 2709+00 - 2710+74 N.B. RT

* STAGE 2 CONSTRUCTION
 Property Line Fence w/ Steel Posts, Mod.
 2709+00 - 2724+00 Rt.

MUCK EXCAV. ITEM 117
 NB 2722+00 - 2724+00

SUB-BASE OF SAND, ITEM 202
 SB 2720+75 - 2722+75

PLAN	REVISED	BY	DATE
1	1	1	1
2	2	2	2
3	3	3	3
4	4	4	4
5	5	5	5
6	6	6	6
7	7	7	7
8	8	8	8
9	9	9	9
10	10	10	10

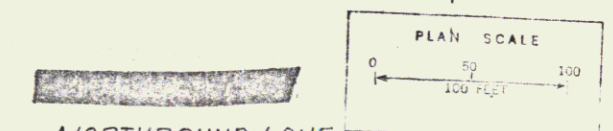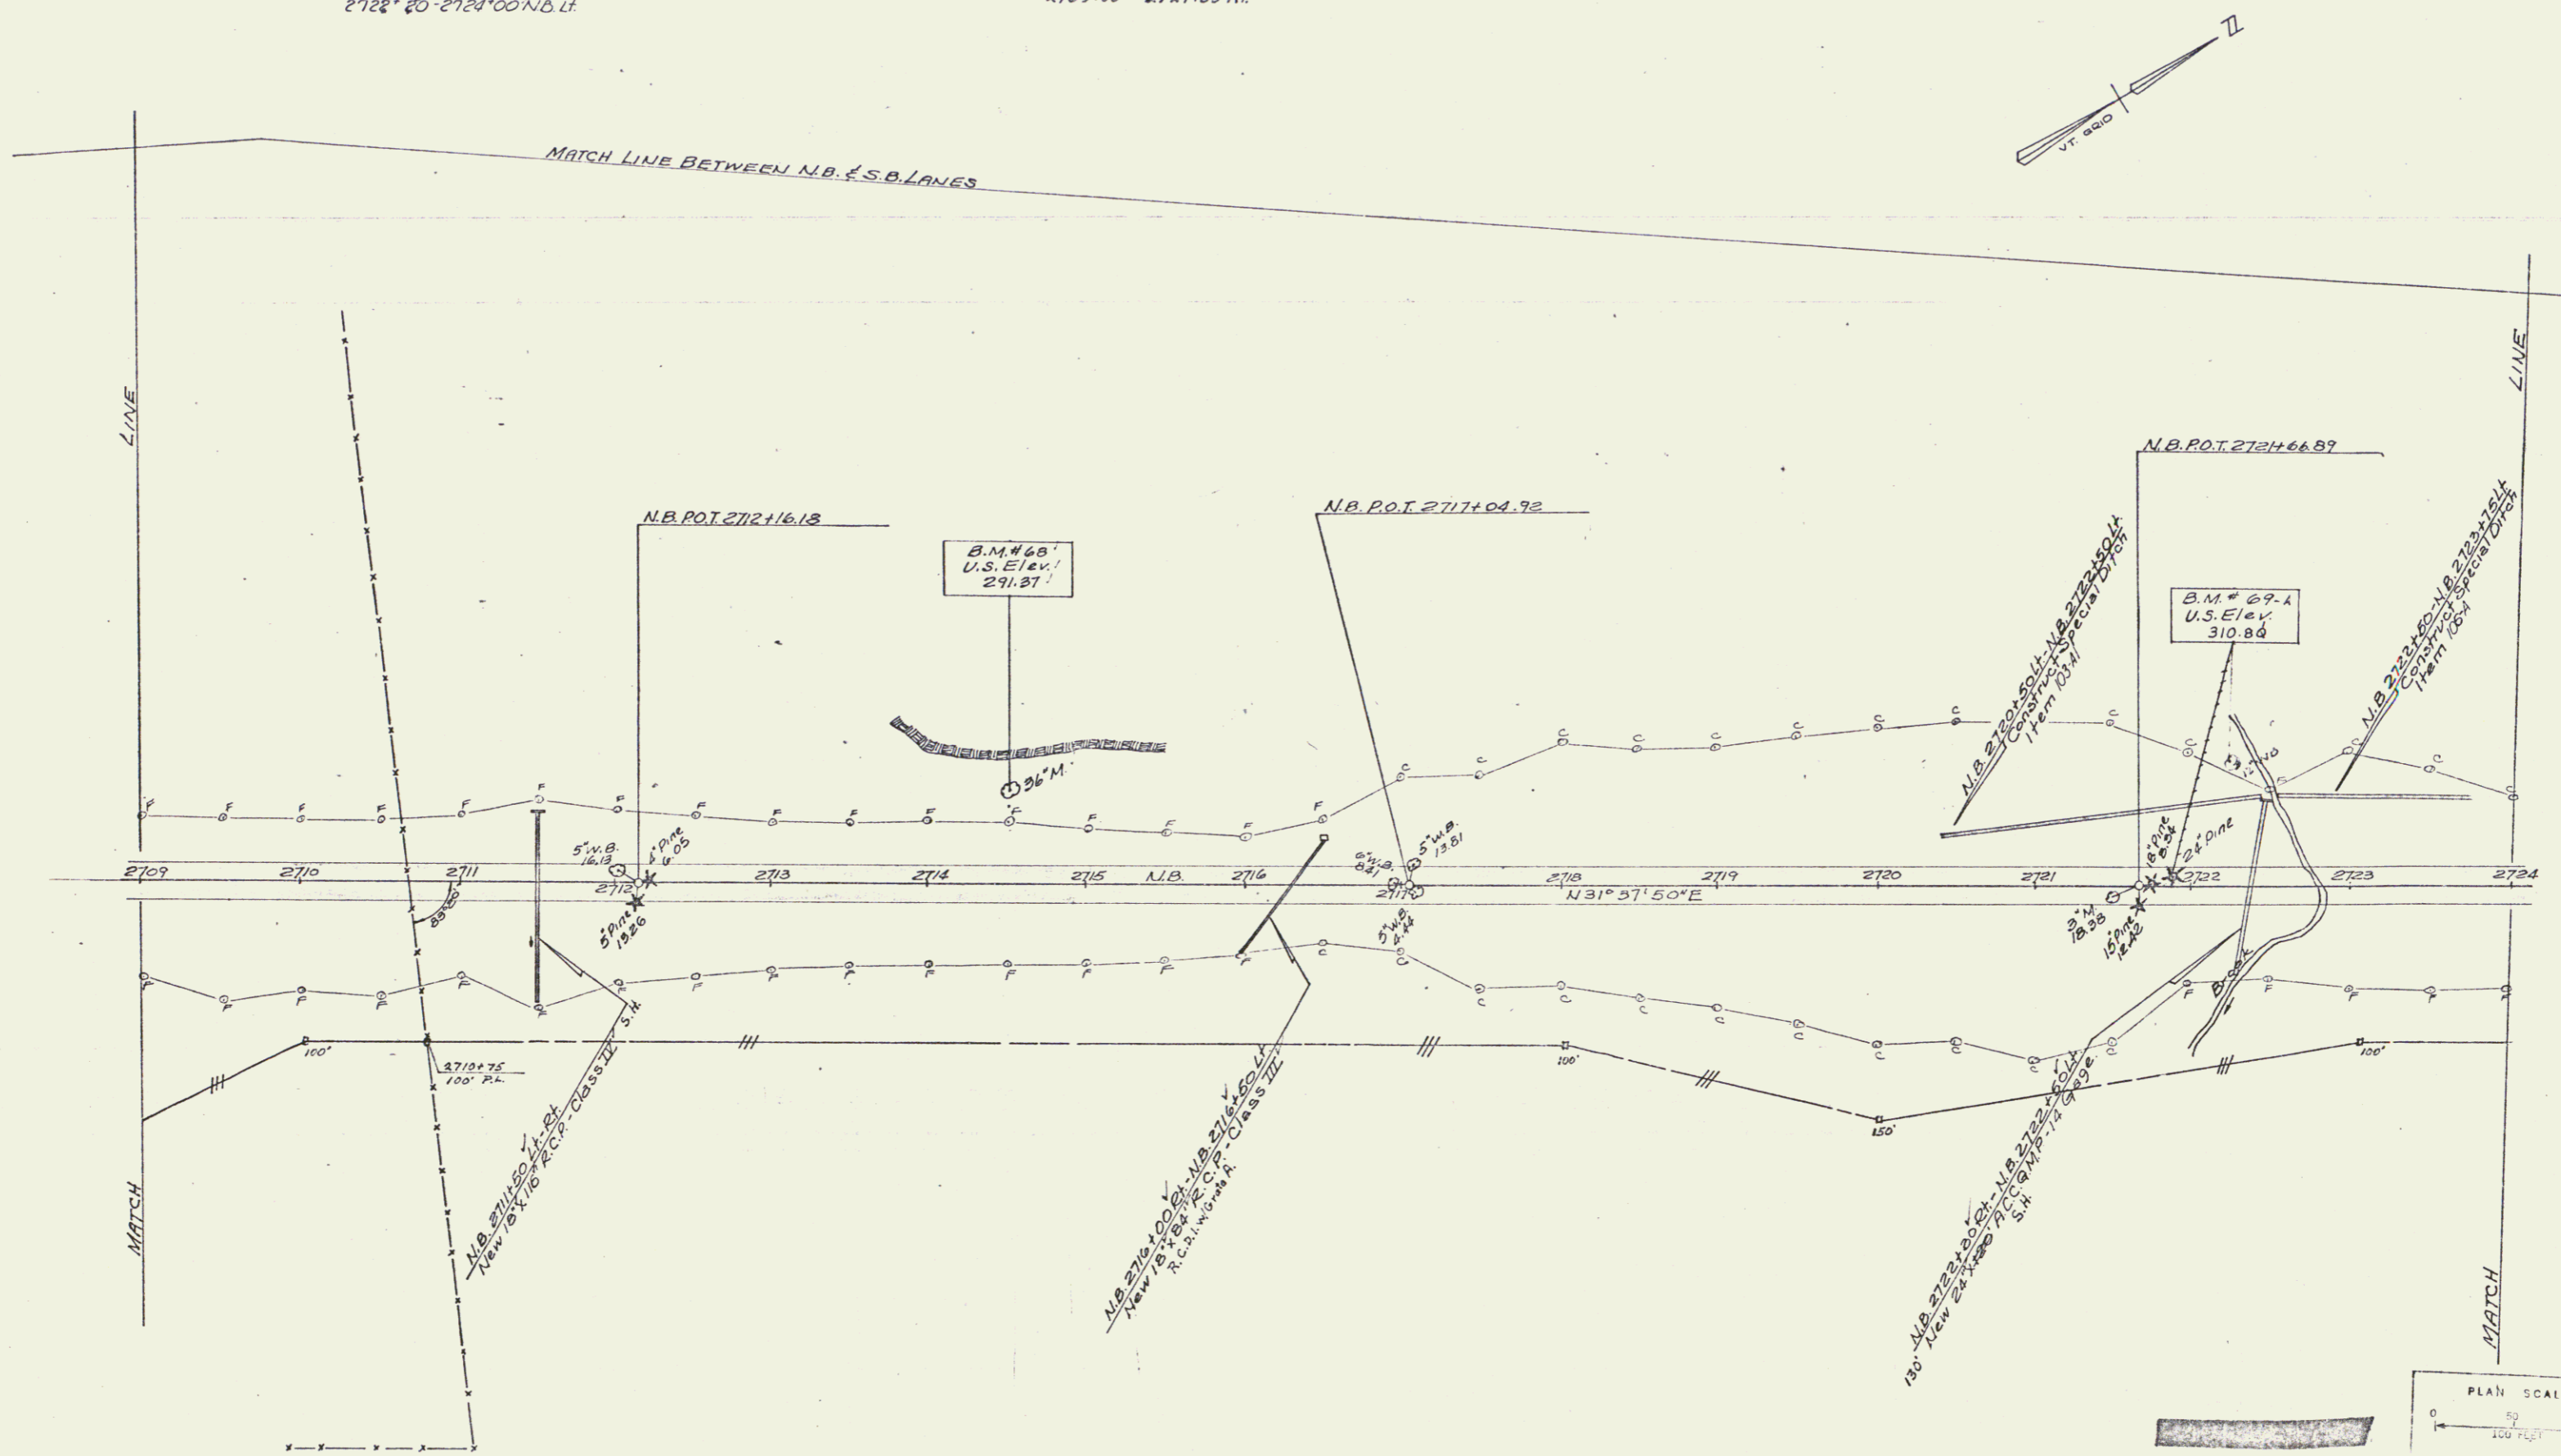

NORTHBOUND LANE
 COLCHESTER - MILTON
 STAGE II CONSTRUCTION
 I 89-3 (34) I 89-3 (40)
 Sheet 64 of 419
 sheet 65 of 177 sheets