


* STAGE 2 CONSTRUCTION

* THREE CABLE GUARD RAIL
w/ STEEL POSTS, ITEM 542
SB 2734'00 - 2739'00 LT

PROPERTY LINE FENCE, MOD.
ITEM 503, B
SB 2728'00 - 2739'00 LT

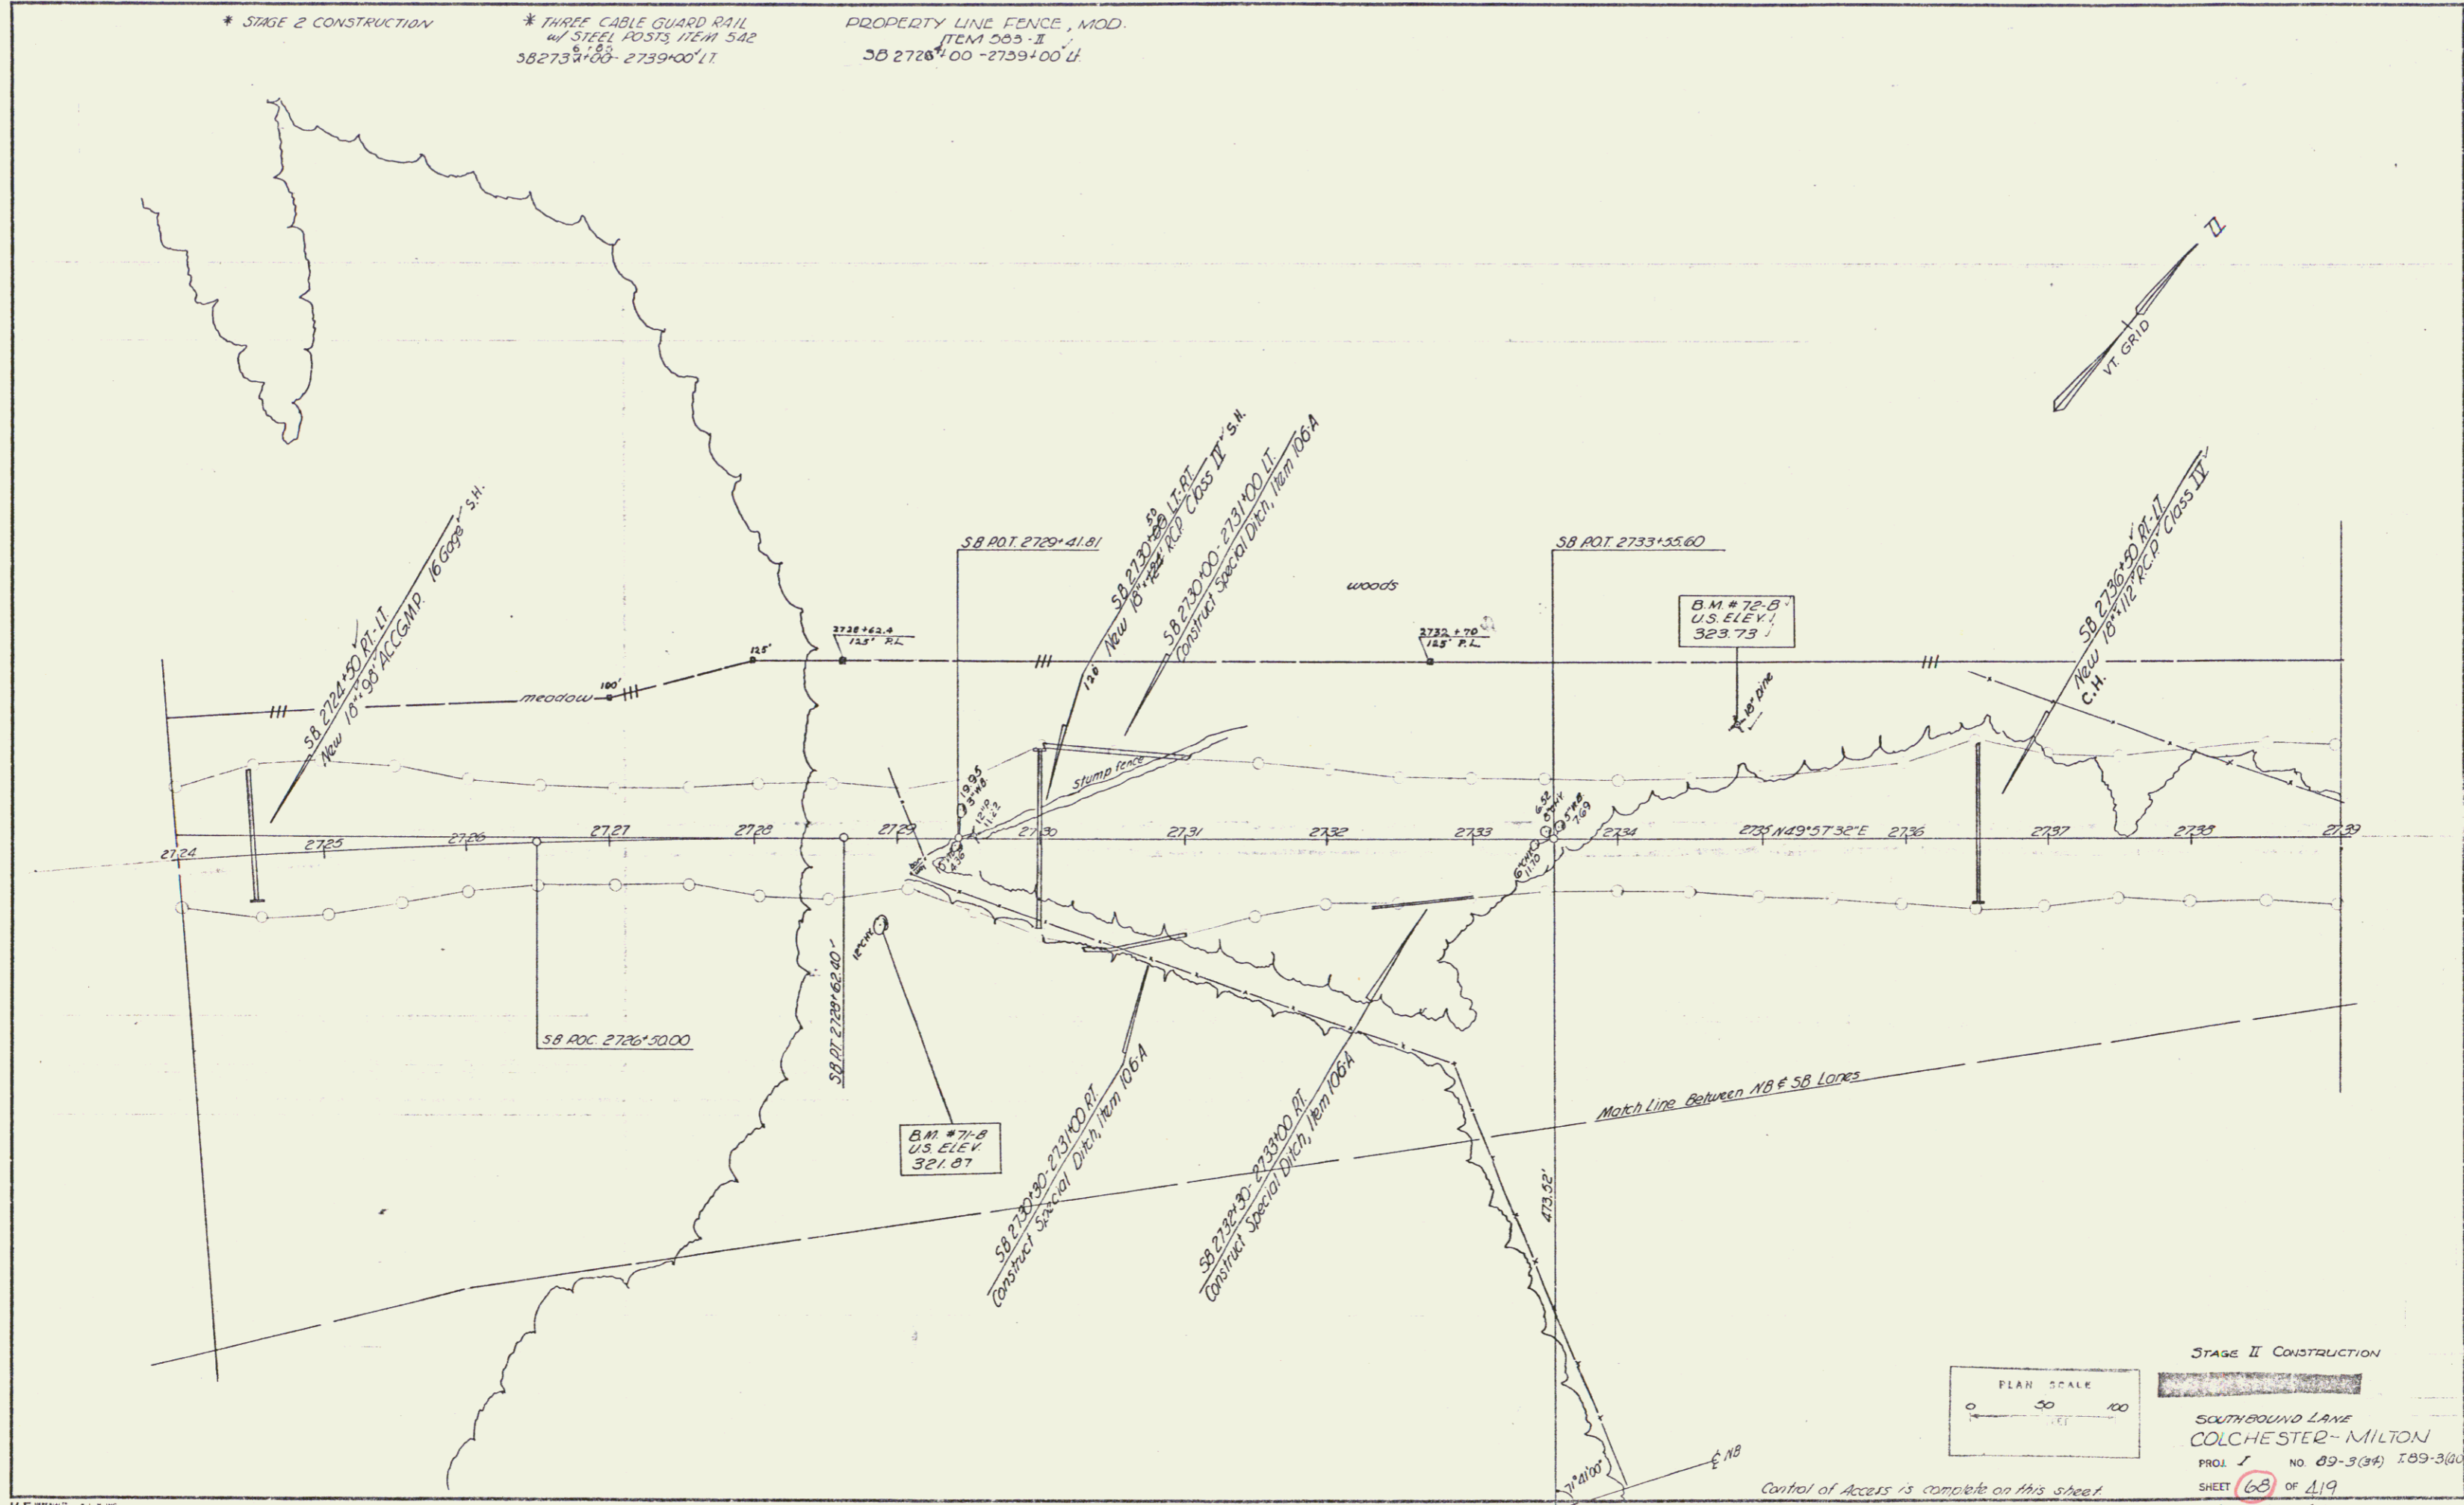

Stage II Construction

SOUTHBOUND LANE
COLCHESTER-MILTON
PROJ. NO. 89-3(34) 189-3(00)
SHEET 68 OF 119
Sheet 69 of 177 Sheets

76