


PLAN	DATE
REVISED	
BY	
CHECKED	
APPROVED	
DATE	

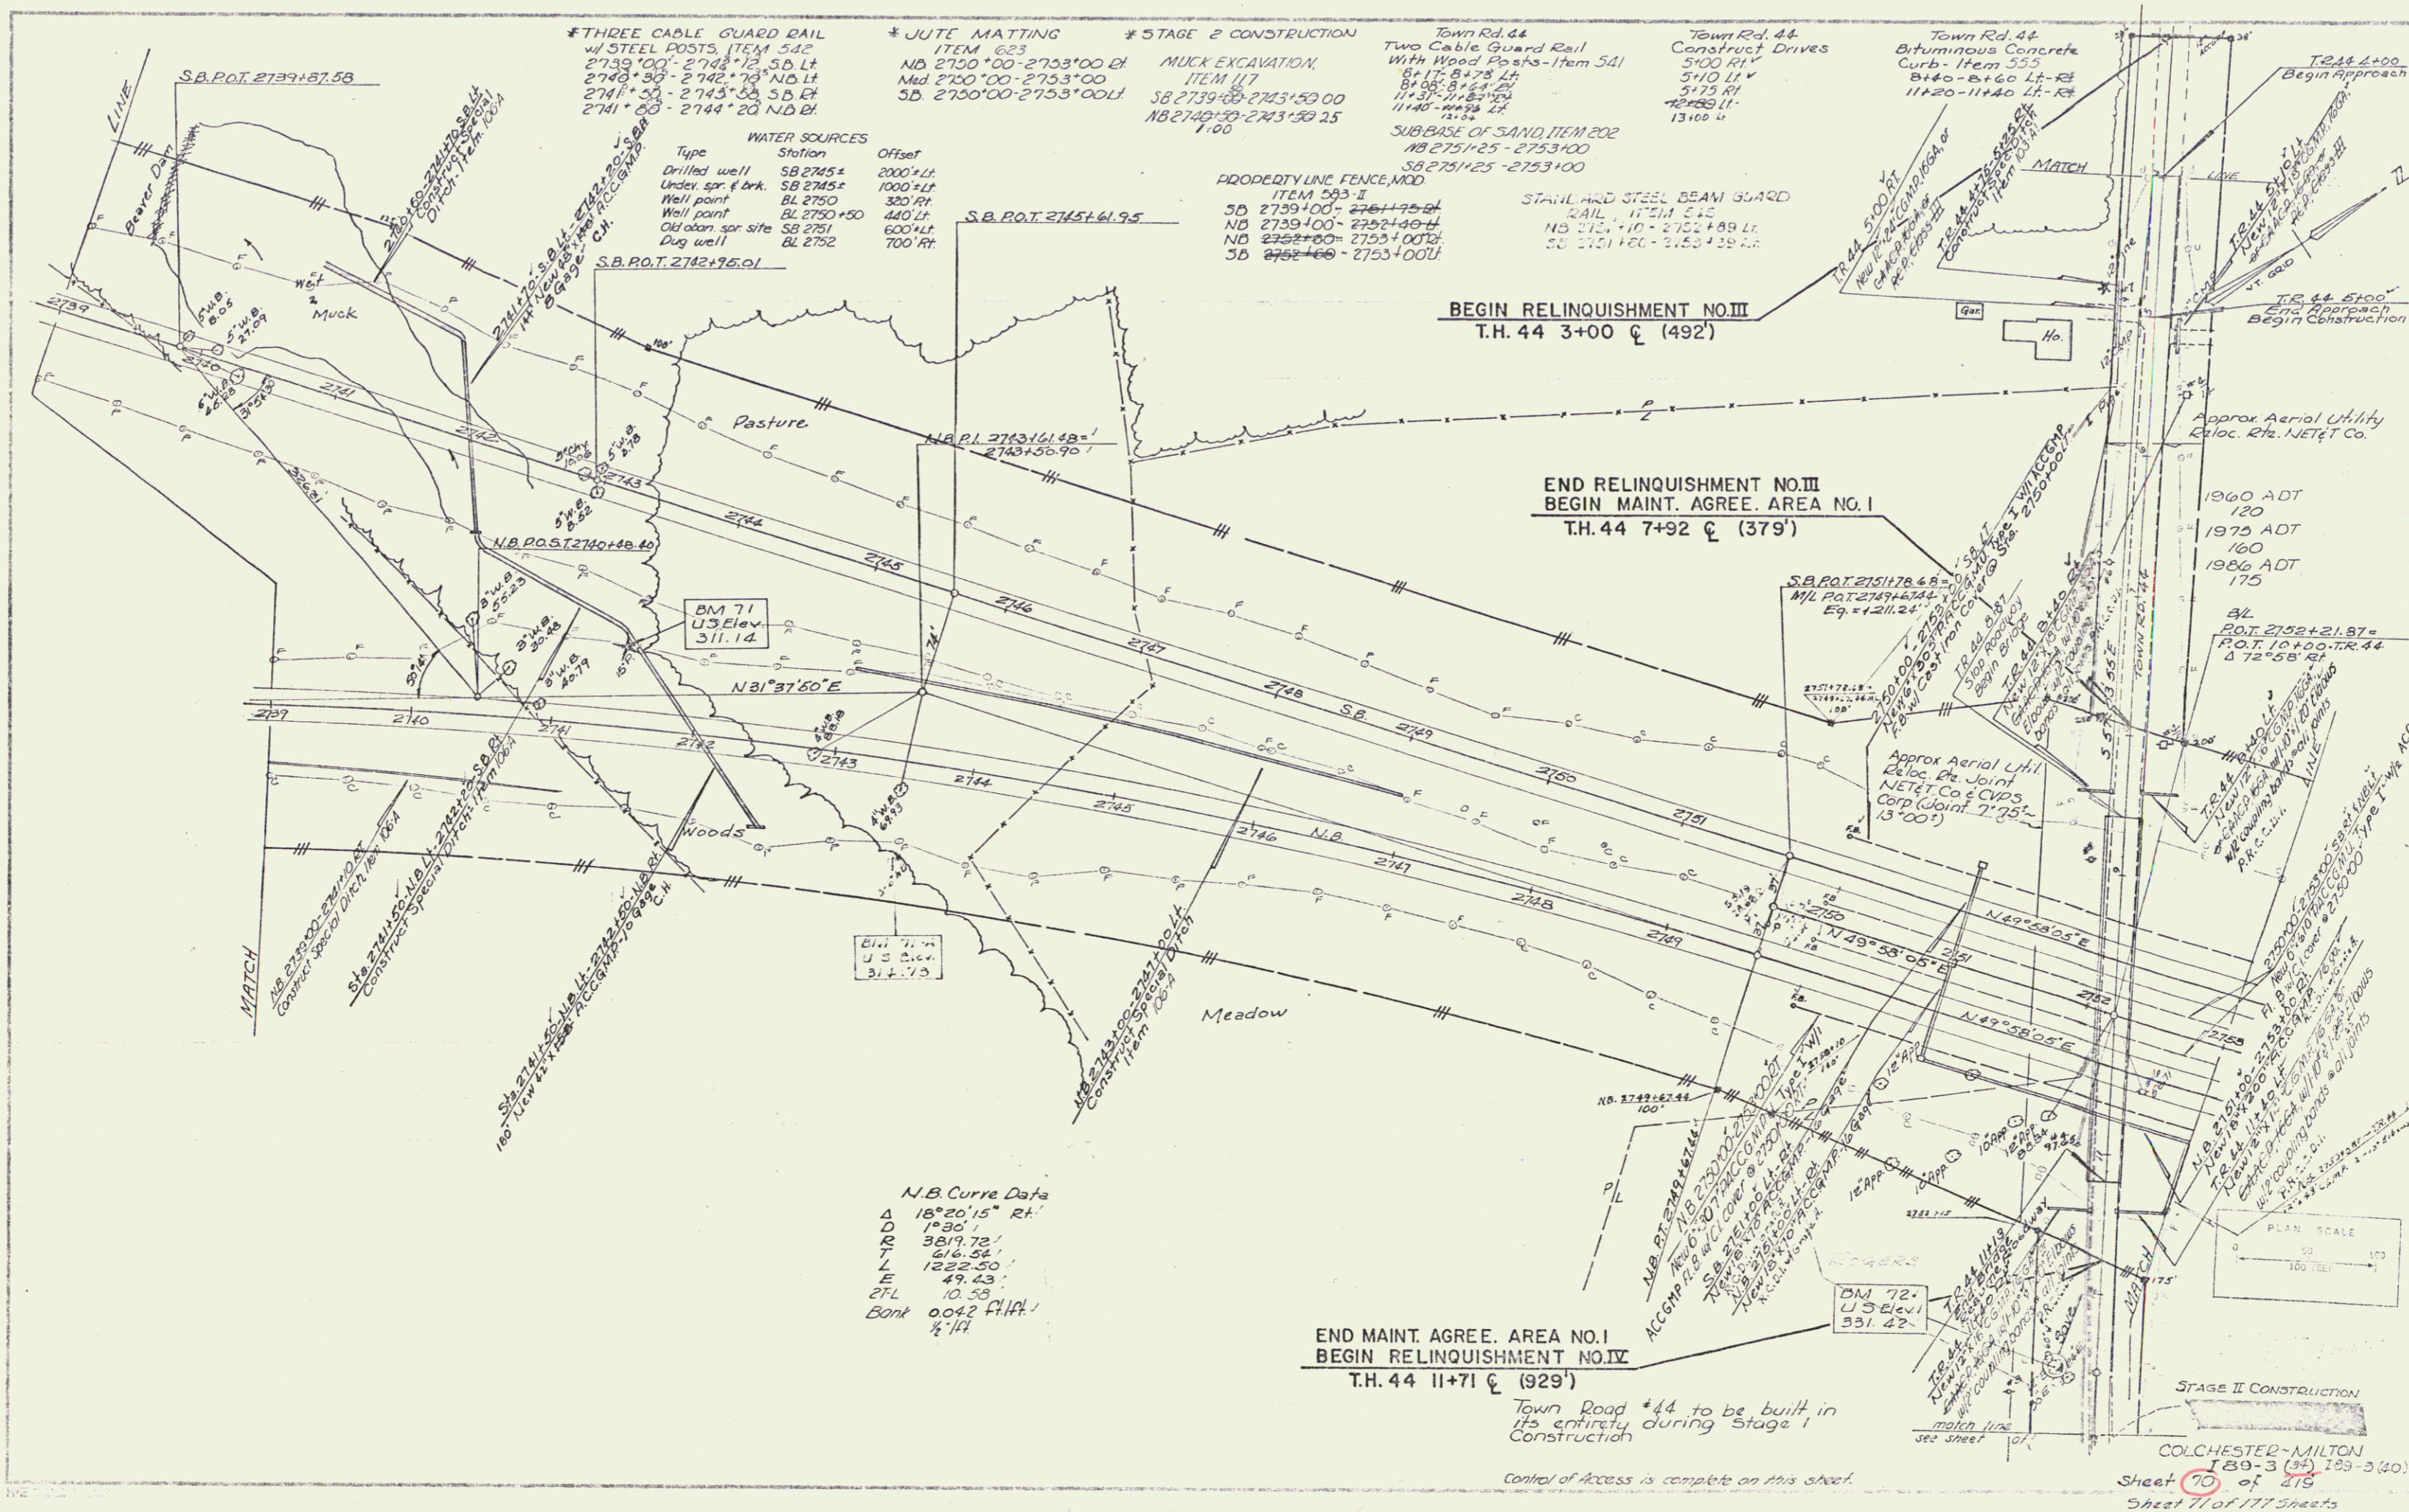

N.B. Curve Data
 Δ 15°20'15" Rt.
 D 1930'
 R 3819.72'
 T 616.54'
 L 1222.50'
 E 49.43'
 PFL 10.53'
 Bank 0042 ft. Ht.
 1/4 MI.