

PLAN	DATE
REVISION	BY
NO. 1	DATE
NO. 2	DATE
NO. 3	DATE
NO. 4	DATE
NO. 5	DATE
NO. 6	DATE
NO. 7	DATE
NO. 8	DATE
NO. 9	DATE
NO. 10	DATE

PROPERTY LINE FENCE, MOD
ITEM 203-II
NB 2753+00-2760+00 ft.
SD 2753+00-2760+00 ft.
Note: - 2752+72 ft - 2762+00 ft
Drop L Fence to be constructed
prior to other work in area.


* JULIE MATTING, ITEM 623
SB 2753+00-2760+25 ft
NB 2753+00-2762+75 ft
Med 2753+00-2760+00

* THREE CABLE GUARD RAIL
w/ STEEL POSTS, ITEM 542
2760+00 ft - 2760+00 N.D.P.
+ 25'

* STAGE 2 CONSTRUCTION

SUB BASE OF SAND, ITEM 202
SB 2753+00-2763+75
NB 2753+00-2764+75
SB 2764+75-2768+00

Type	Station	Offset
Old dug well	BL 2753+50	630' ± Rt.
Drilled well	BL 2754+10	360' Rt.
Dug well	BL 2754+50	1100' ± Rt.
Dry well cistern	BL 2755 ±	600' ± Rt.
Well point	BL 2756 ±	1200' ± Rt.
Dug well	BL 2758+50	800' Rt.
Dug spring	BL 2759 ±	700' ± Rt.

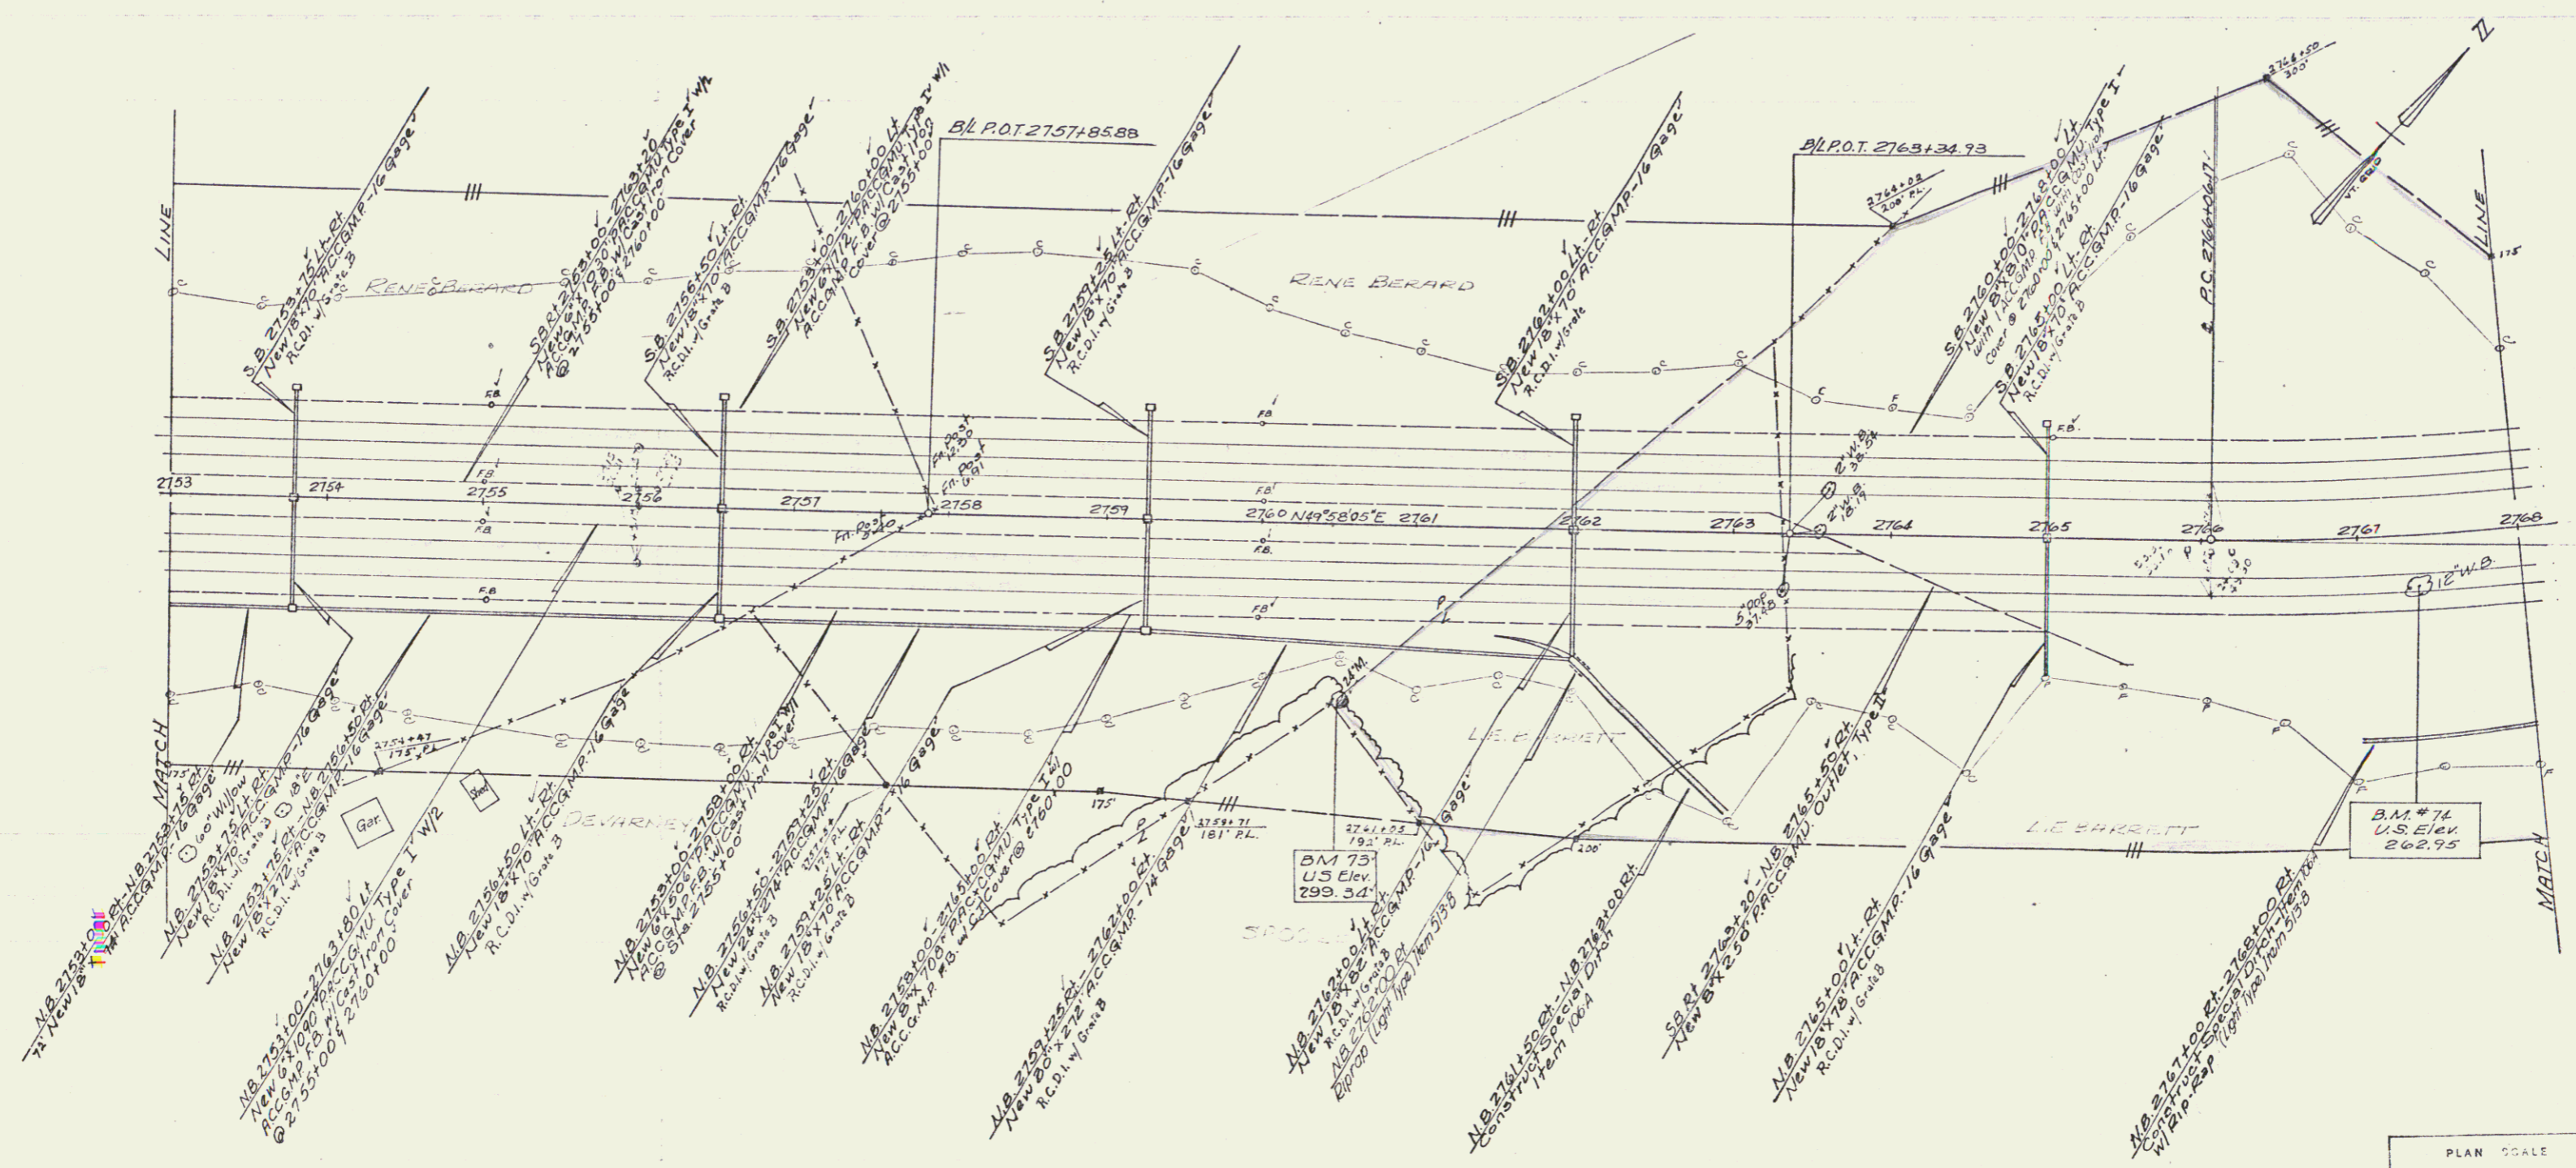

Control of Access is complete on this sheet

STAGE II CONSTRUCTION
COLCHESTER-MILTON
180-3 (34) 109-3 (40)

Sheet 73 of 419
Sheet 73 of 177 sheets

79