

SUB-BASE OF SAND ITEM 202
 SB 3004+00 - 3007+00
 60
 SB 3020+50 - 3021+00



PROPERTY LINE FENCE w/ ✓
 STEEL POSTS, MOD., ITEM 583-II
 NB 3004+00 - 3020+00 ✓
 SB 3004+00 - 3021+00 ✓
 Note: SB 3004+00 - 3021+00 Prop. L.
 Fence to be constructed prior
 to other work in area.

WATER SOURCES		
Type	Station	Offset
Spring	NB 3005 ±	2000' Rt
Old dug well	SB 3005 ±	1100' Lt
Dug well	SB 3006 ±	900' Lt
Dug well	SB 3007 ±	500' Lt
Dug well	SB 3007 ±	900' Lt

Standard Steel Beam
 Guard-Rail, w/ Steel Posts, Item 545-A
 N.B. 3014+00 - 3015+10 ft
 S-B-3017+00 - 3018+10 ft

THREE CABLE GUARD RAIL, ITEM 512
 NB 3001+00 - 3004+21 ft

PLAN	DATE	BY
11/28/89	11/28/89	W. G. GIBSON
11/28/89	11/28/89	W. G. GIBSON
11/28/89	11/28/89	W. G. GIBSON
11/28/89	11/28/89	W. G. GIBSON

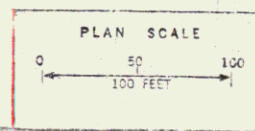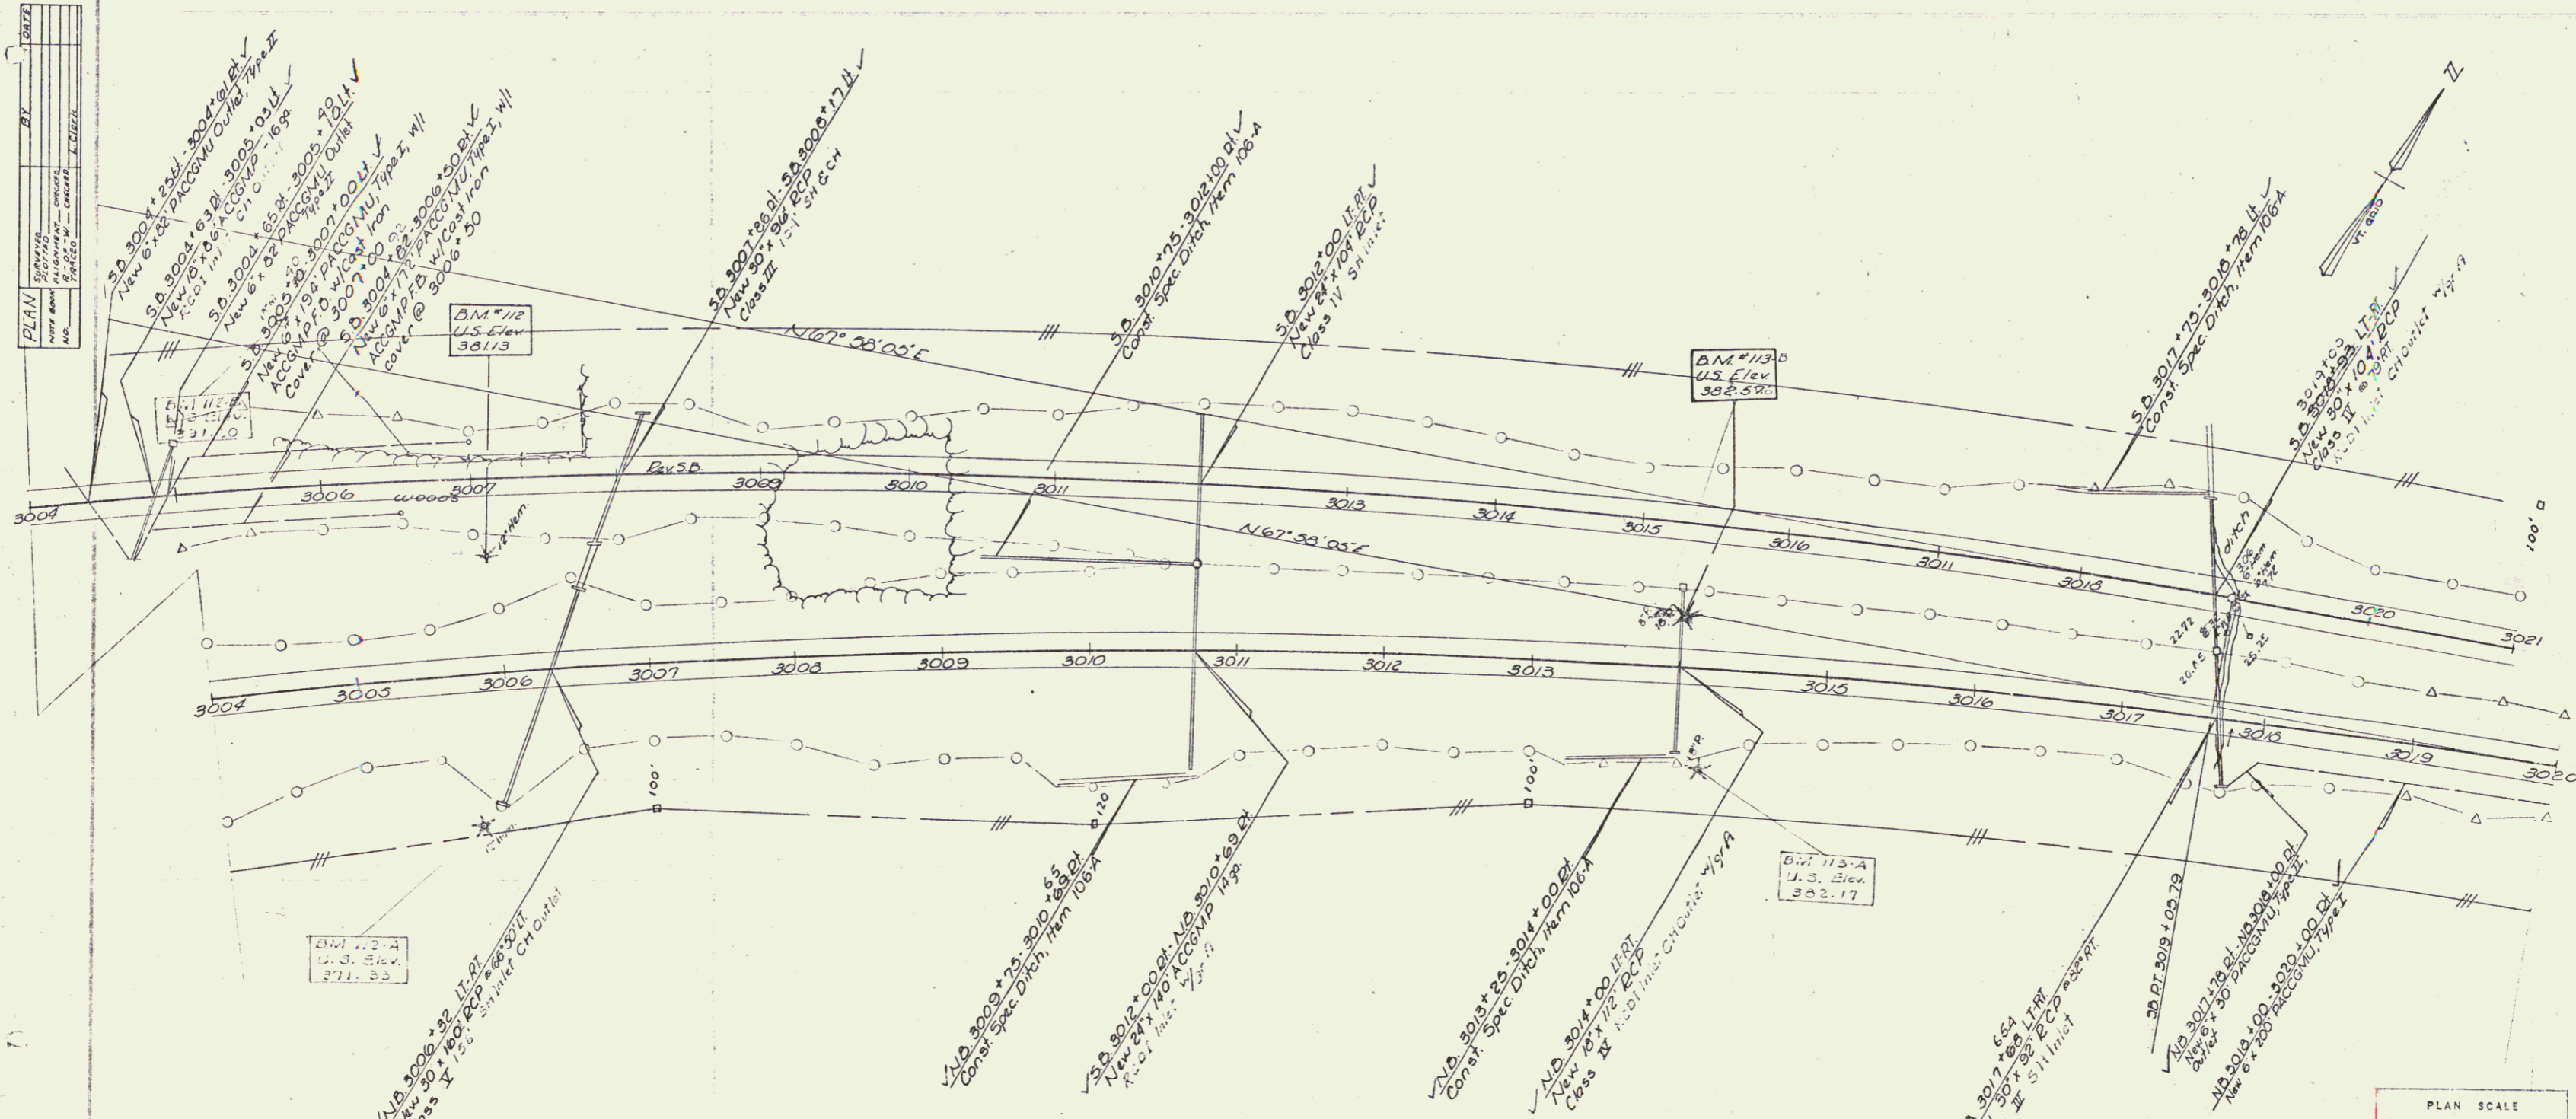

MILTON-GEORGIA I 89-3(40)
 STAGE II CONSTRUCTION

Control of Access is complete on this sheet I 89-3(37)

Sheet 100 of 113 sheets