

WATER SOURCES

Type	Station	Offset
Dug well	BL 3023*	2100*RT
Spring	BL 3025*	1500*RT
Dug well	BL 3023*	2400*RT
Drilled well	BL 3031*	2000*RT
Old dug well	BL 3031+50	2000*RT
Dug well	BL 3036*	1500*RT



DRILLING & BLASTING OF SOLID ROCK
 SUBGRADE, ITEM 115
 SB 3026+150 - 3032+00

MUCK EXCAVATION, ITEM 117
 NB 3019+25 - 3022+25

* **Slope Easement, Item 536**
 Ramp A 7+34.19 - 1134.1927

PROPERTY LINE FENCE w/ STEEL POSTS, MOD. ITEM 583-II
 NB 3020+00 - 3033+51.38 Rt.
 SB 3021+00 - 3036+00 Lt.
 Ramp A 0+00 - 2+00 Rt.
 Note: BL 3028+96 Rt. - US #7 93+27 Lt. / Prop. Line Fence to be constructed prior to other work in area.

STAGE 2 CONSTRUCTION

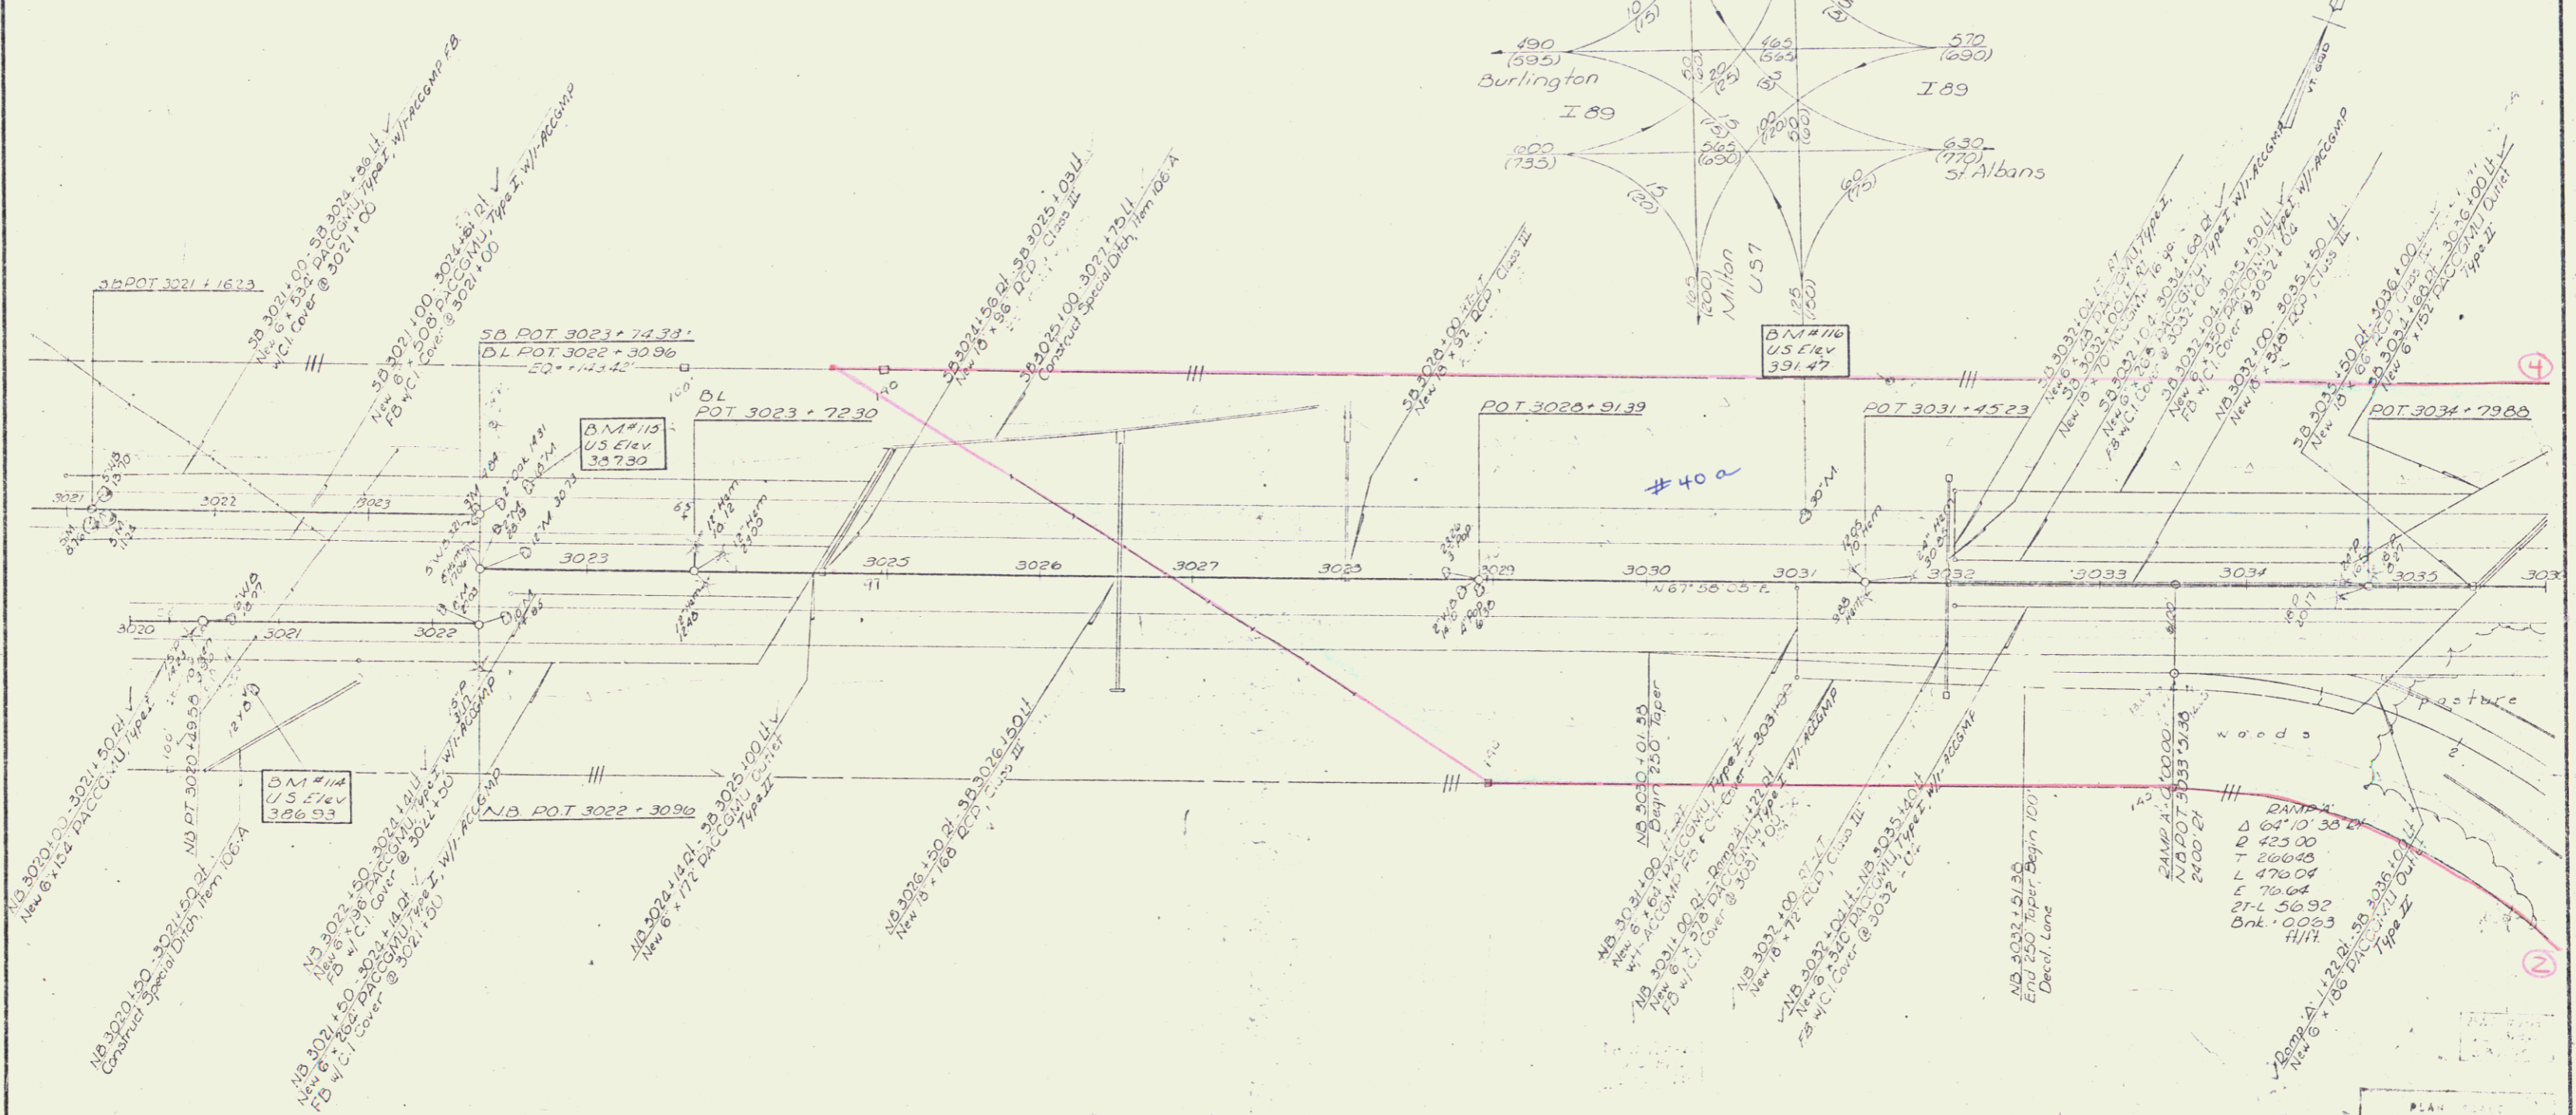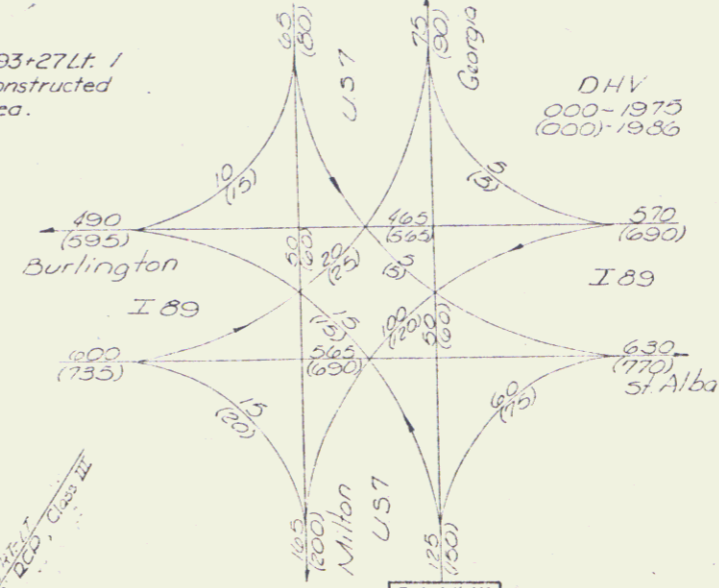

RAMP A
 Δ 64' 10" 30.01
 D 425.00
 T 266.48
 L 476.04
 E 76.04
 21-L 56.92
 Bnk. 0.053
 H/11

PLAN
 STAGE I CONSTRUCTION
 MILTON-GEORGIA 109-R(10)
 I 89 - 3(25)
 39A of 329