

THREE CABLE GUARD RAIL
w/ STEEL POSTS, ITEM 542
92' 4.8" DI - TR. 31 0' 47' LT
Ramp C 0' 75.8" - 115' 100' 59' LT

WATER SOURCES
Type Station Offset
Dug well 90+15 110' LT
Dug well 90+90 17' RT

* Slope Edging Item 556
Ramp A 4' 31' 23.7" - 3' 430' 7' LT
Ramp B 0' 30.7" - 0' 74' 7' LT
Ramp C 0' 196.04" - 115' 100' 59' LT
Ramp B 1' 21' 04" - 7' 00' 99' RT

* Stage 2 Construction

TREATED TIMBER CURB
ITEM 553
US Rt. 7 93' 00" - 97' 50" RT ✓
US Rt. 7 0' 71.81" - US 7 100' 59" LT ✓
CONSTRUCT DRIVE
91' 15' RT - 92' 127' - 93' 127' LT

PROPERTY LINE FENCE w/
STEEL POSTS, MOD, ITEM 583-II
Ramp A 2' 00" FT - US 7 90' 00" LT ✓
US 7 90' 00" FT - 97' 47' RT ✓
Note: US 7 93' 17' RT - 97' 47' RT
Prop. L Fence to be constructed
prior to other work in area.

Bituminous Concrete Gutter Item 554
US 7 31a 90' 125" - 91' 400' RT & 2A

Granite Slope Edging Item 556-A (for traffic island)
91a 95' 110" - 97' 400" ✓


RAMP A
Δ 64' 10' 38" RT
R 425.00
T 266.43
L 476.04
E 78.04
Bank 0.063 F/H
3/4" H.

RAMP A
Δ 28' 23' 32" LT
R 300.00
T 76.60
L 150.00
E 9.03
Bank 0.042 F/H


RAMP B
Δ 144' 28' 20" RT
R 230.00
T 717.92
L 579.95
E 323.66
Bank 0.023 F/H
3/4" H.

RAMP B
Δ 0' 09' 57" RT
R 307.50
T 95' 50' 00" RT
L 385' 51' 20" LT

RAMP B
Δ 0' 00' 00" RT
US 7 R OC 95' 50' 00"

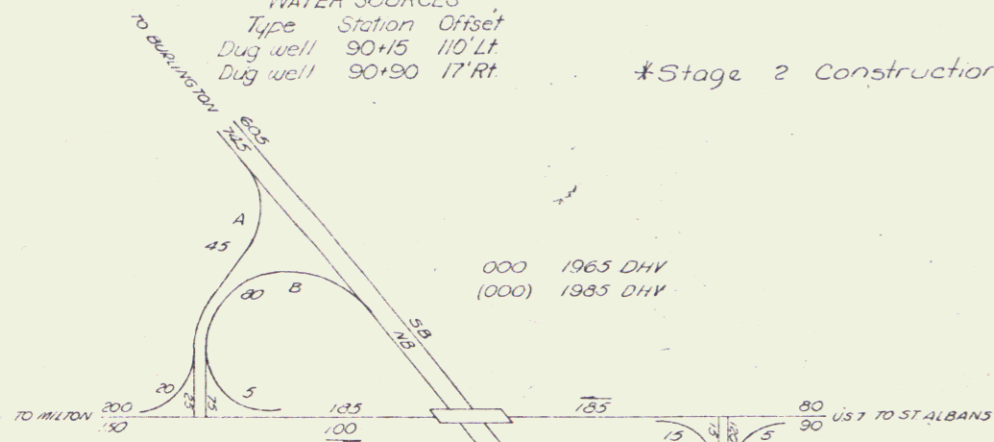

AVERAGE DAILY TRAFFIC
0000 1965
(0000) 1965

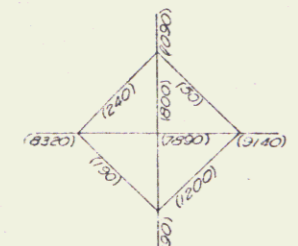

2.417	10/15/65	10/15/65	10/15/65
10/15/65	10/15/65	10/15/65	10/15/65
10/15/65	10/15/65	10/15/65	10/15/65
10/15/65	10/15/65	10/15/65	10/15/65

Approx Aerial UHI Relec Pk.
CVID's Corp. Erect Line Pole
#125-136 to be taken down
and constructed off project
limits. To be replaced by the
Line TR #6

Stone Fill For Slope Protection
Item 512
US 7 110' 25" - 12' 21' 2100' RT

Stage 1 Construction
MILTON-GEORGIA I-89-3120
I 69-3120
US Rt. 7 Ramp A & Ramp B
Sheet 108 of 273