
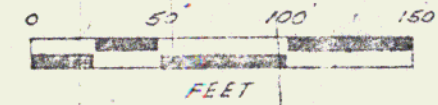


DRILLING & BLASTING OF SOLID  
ROCK SUBGRADE ITEM 1.1  
NB 3065+00-3071+00  
SB 3065+50-3072+00

THREE CABLE GUARD RAIL  
W/ STEEL POSTS ITEM 1.4  
NB 3073+10-3073+82 Rt  
SB 3073+61-3074+25 Lt

DATE: 7.2.82  
DRAWN BY: [Name]  
CHECKED BY: [Name]  
SCALE: 1" = 40'

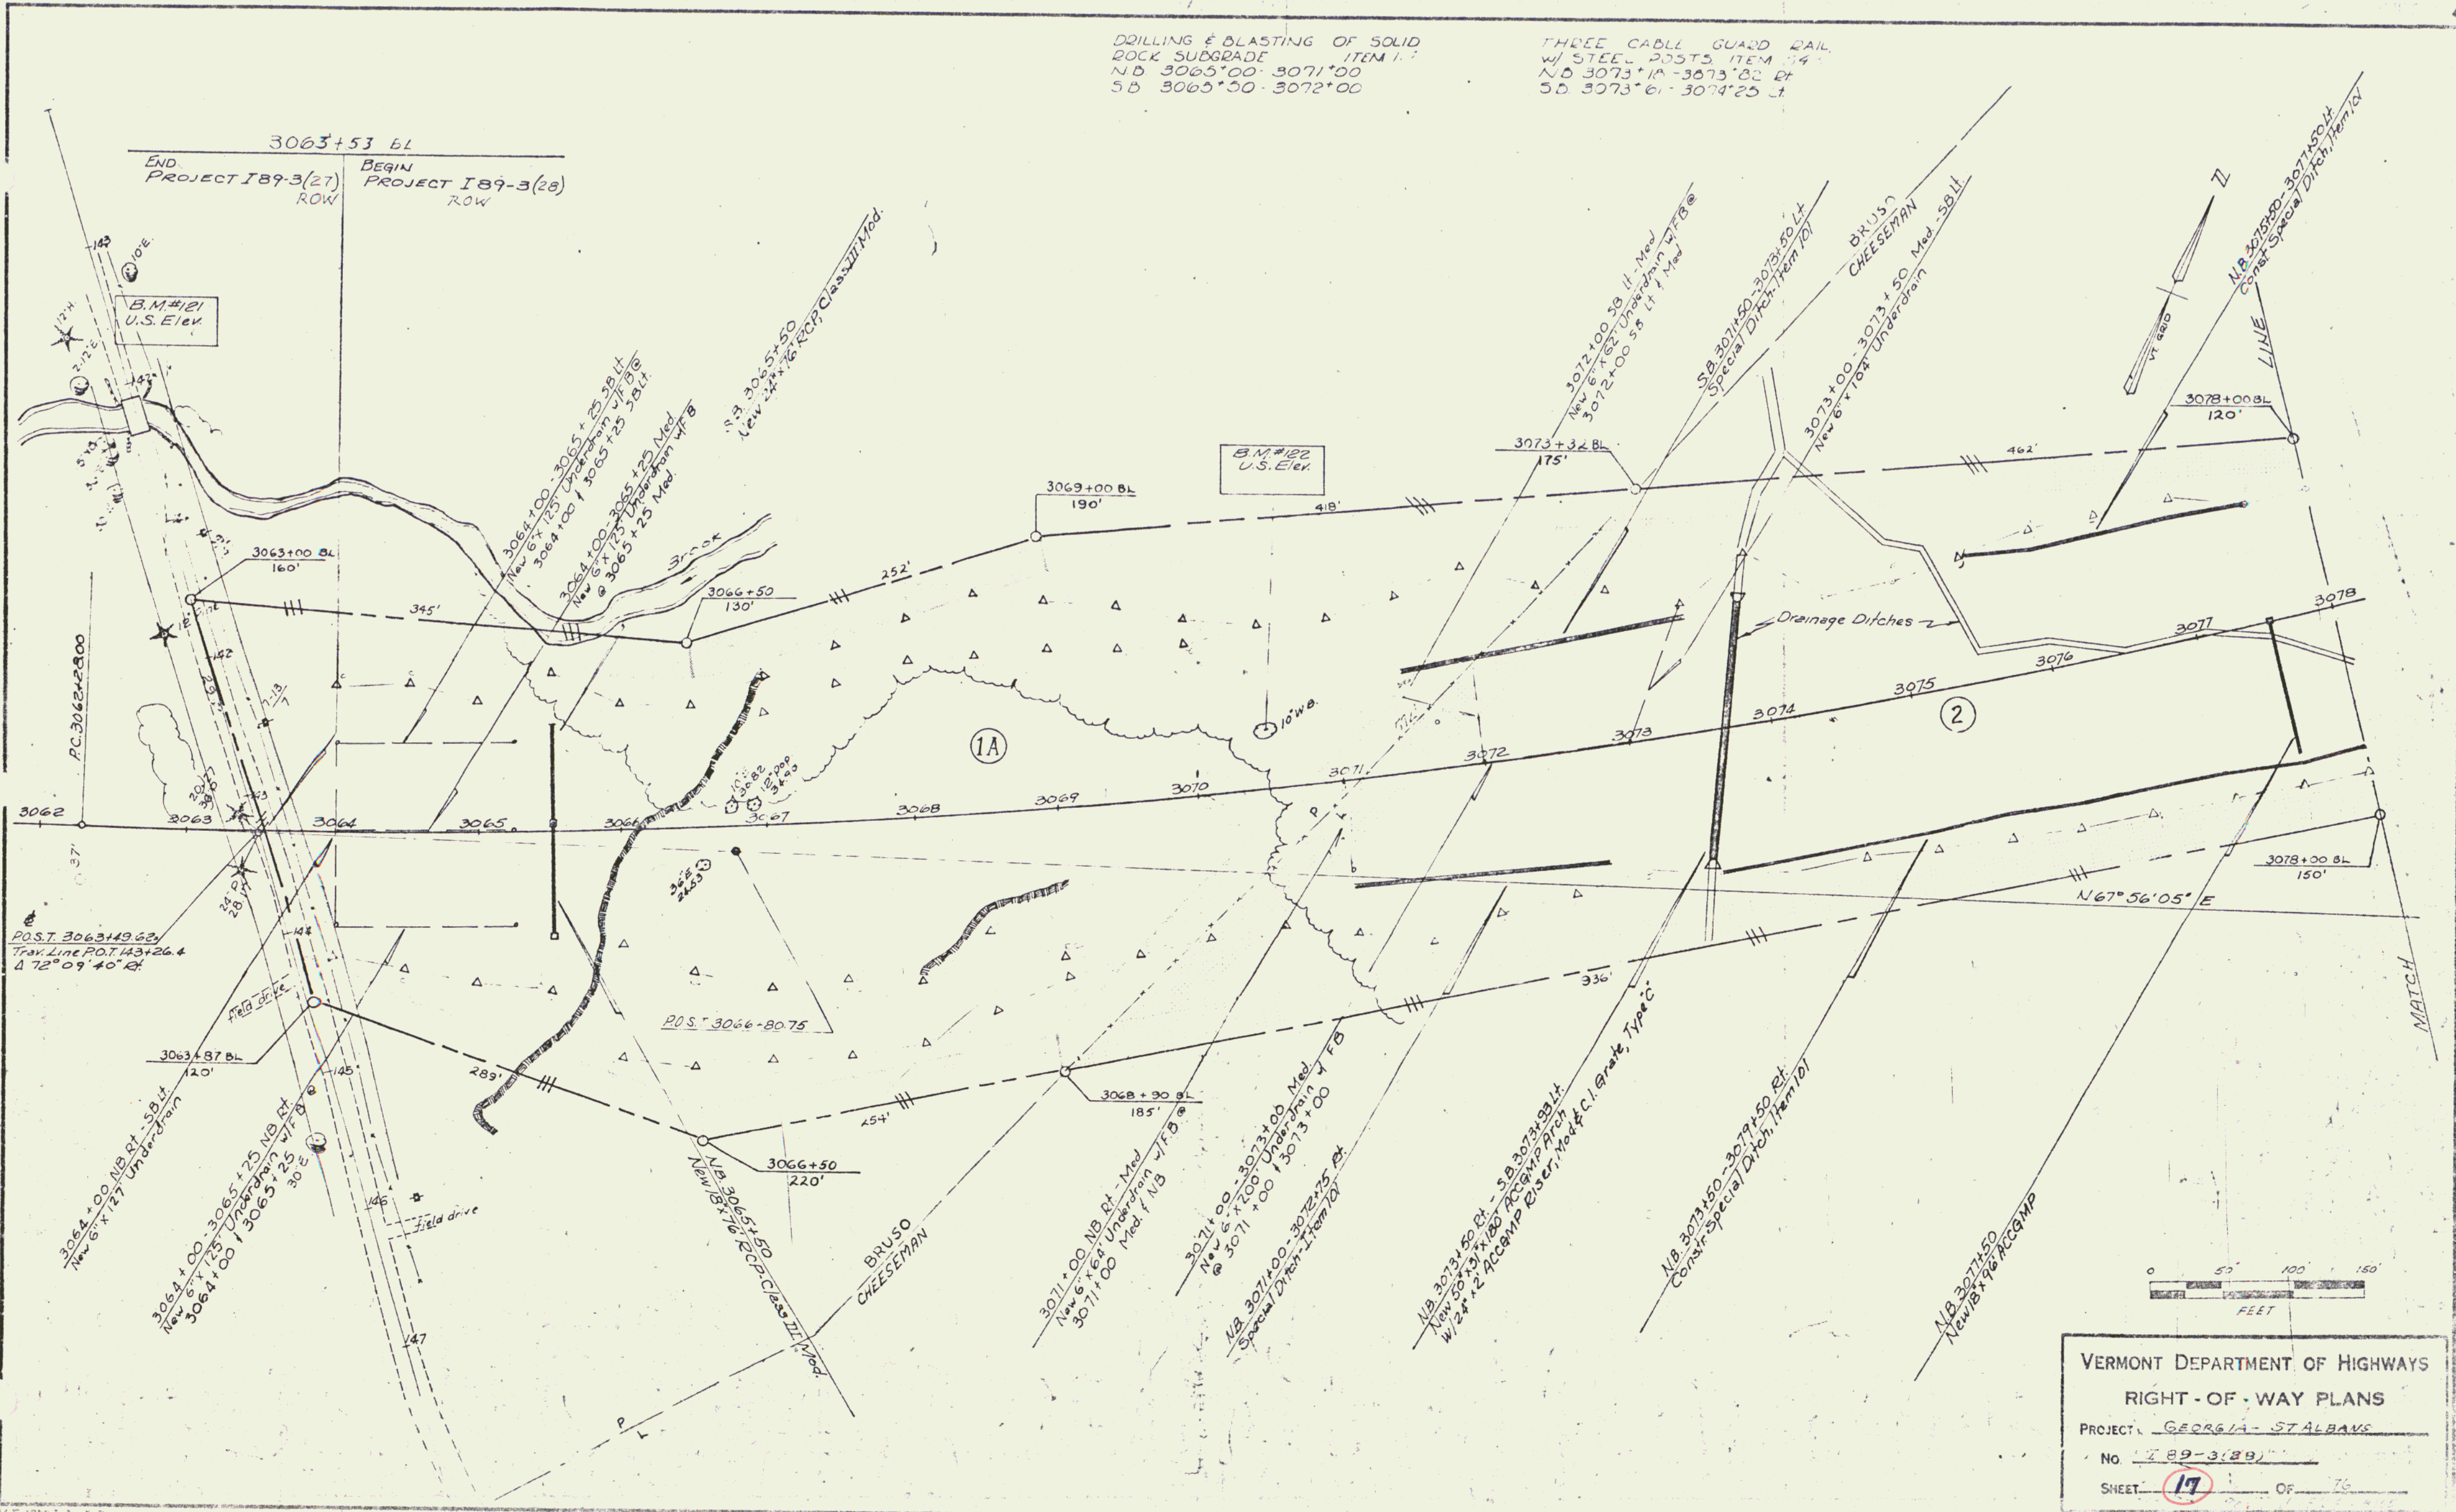

VERMONT DEPARTMENT OF HIGHWAYS  
RIGHT-OF-WAY PLANS  
PROJECT: GEORGETOWN-ST ALBAVS  
NO. 89-3(89)  
SHEET 17 OF 76