


PLAN SUBMITTED 12/62
 DATE 1/63
 BY [unclear]
 CHECKED [unclear]
 NO. [unclear]

STONE FILL FOR SLOPE
 PROTECTION, ITEM 512
 ND 3093+25 - 3095+75 Rt.
 THREE CABLE GUARD RAIL
 W/ STEEL POSTS, ITEM 542
 SD 3084+96 - 3091+28 Lt.
 ND 3085+44 - 3090+48 Rt.
 ND 3093+38 - 3094+00 Rt.

BITUMINOUS CONCRETE CURB
 ITEM 555
 3088+00 - 3088+16 SB Lt.
 3088+00 - 3088+16 NB Lt.
 BITUMINOUS GUTTER
 USING ITEM 554
 3085+00 - 3090+50 Med
 3094+75 - 3095+73 Med

$\Delta 52^{\circ} 51' 15''$ Lt.
 $D 1^{\circ} 00' 00''$
 $R 5129.58$
 $T 2843.61$
 $L 5295.42$
 $E 668.06$

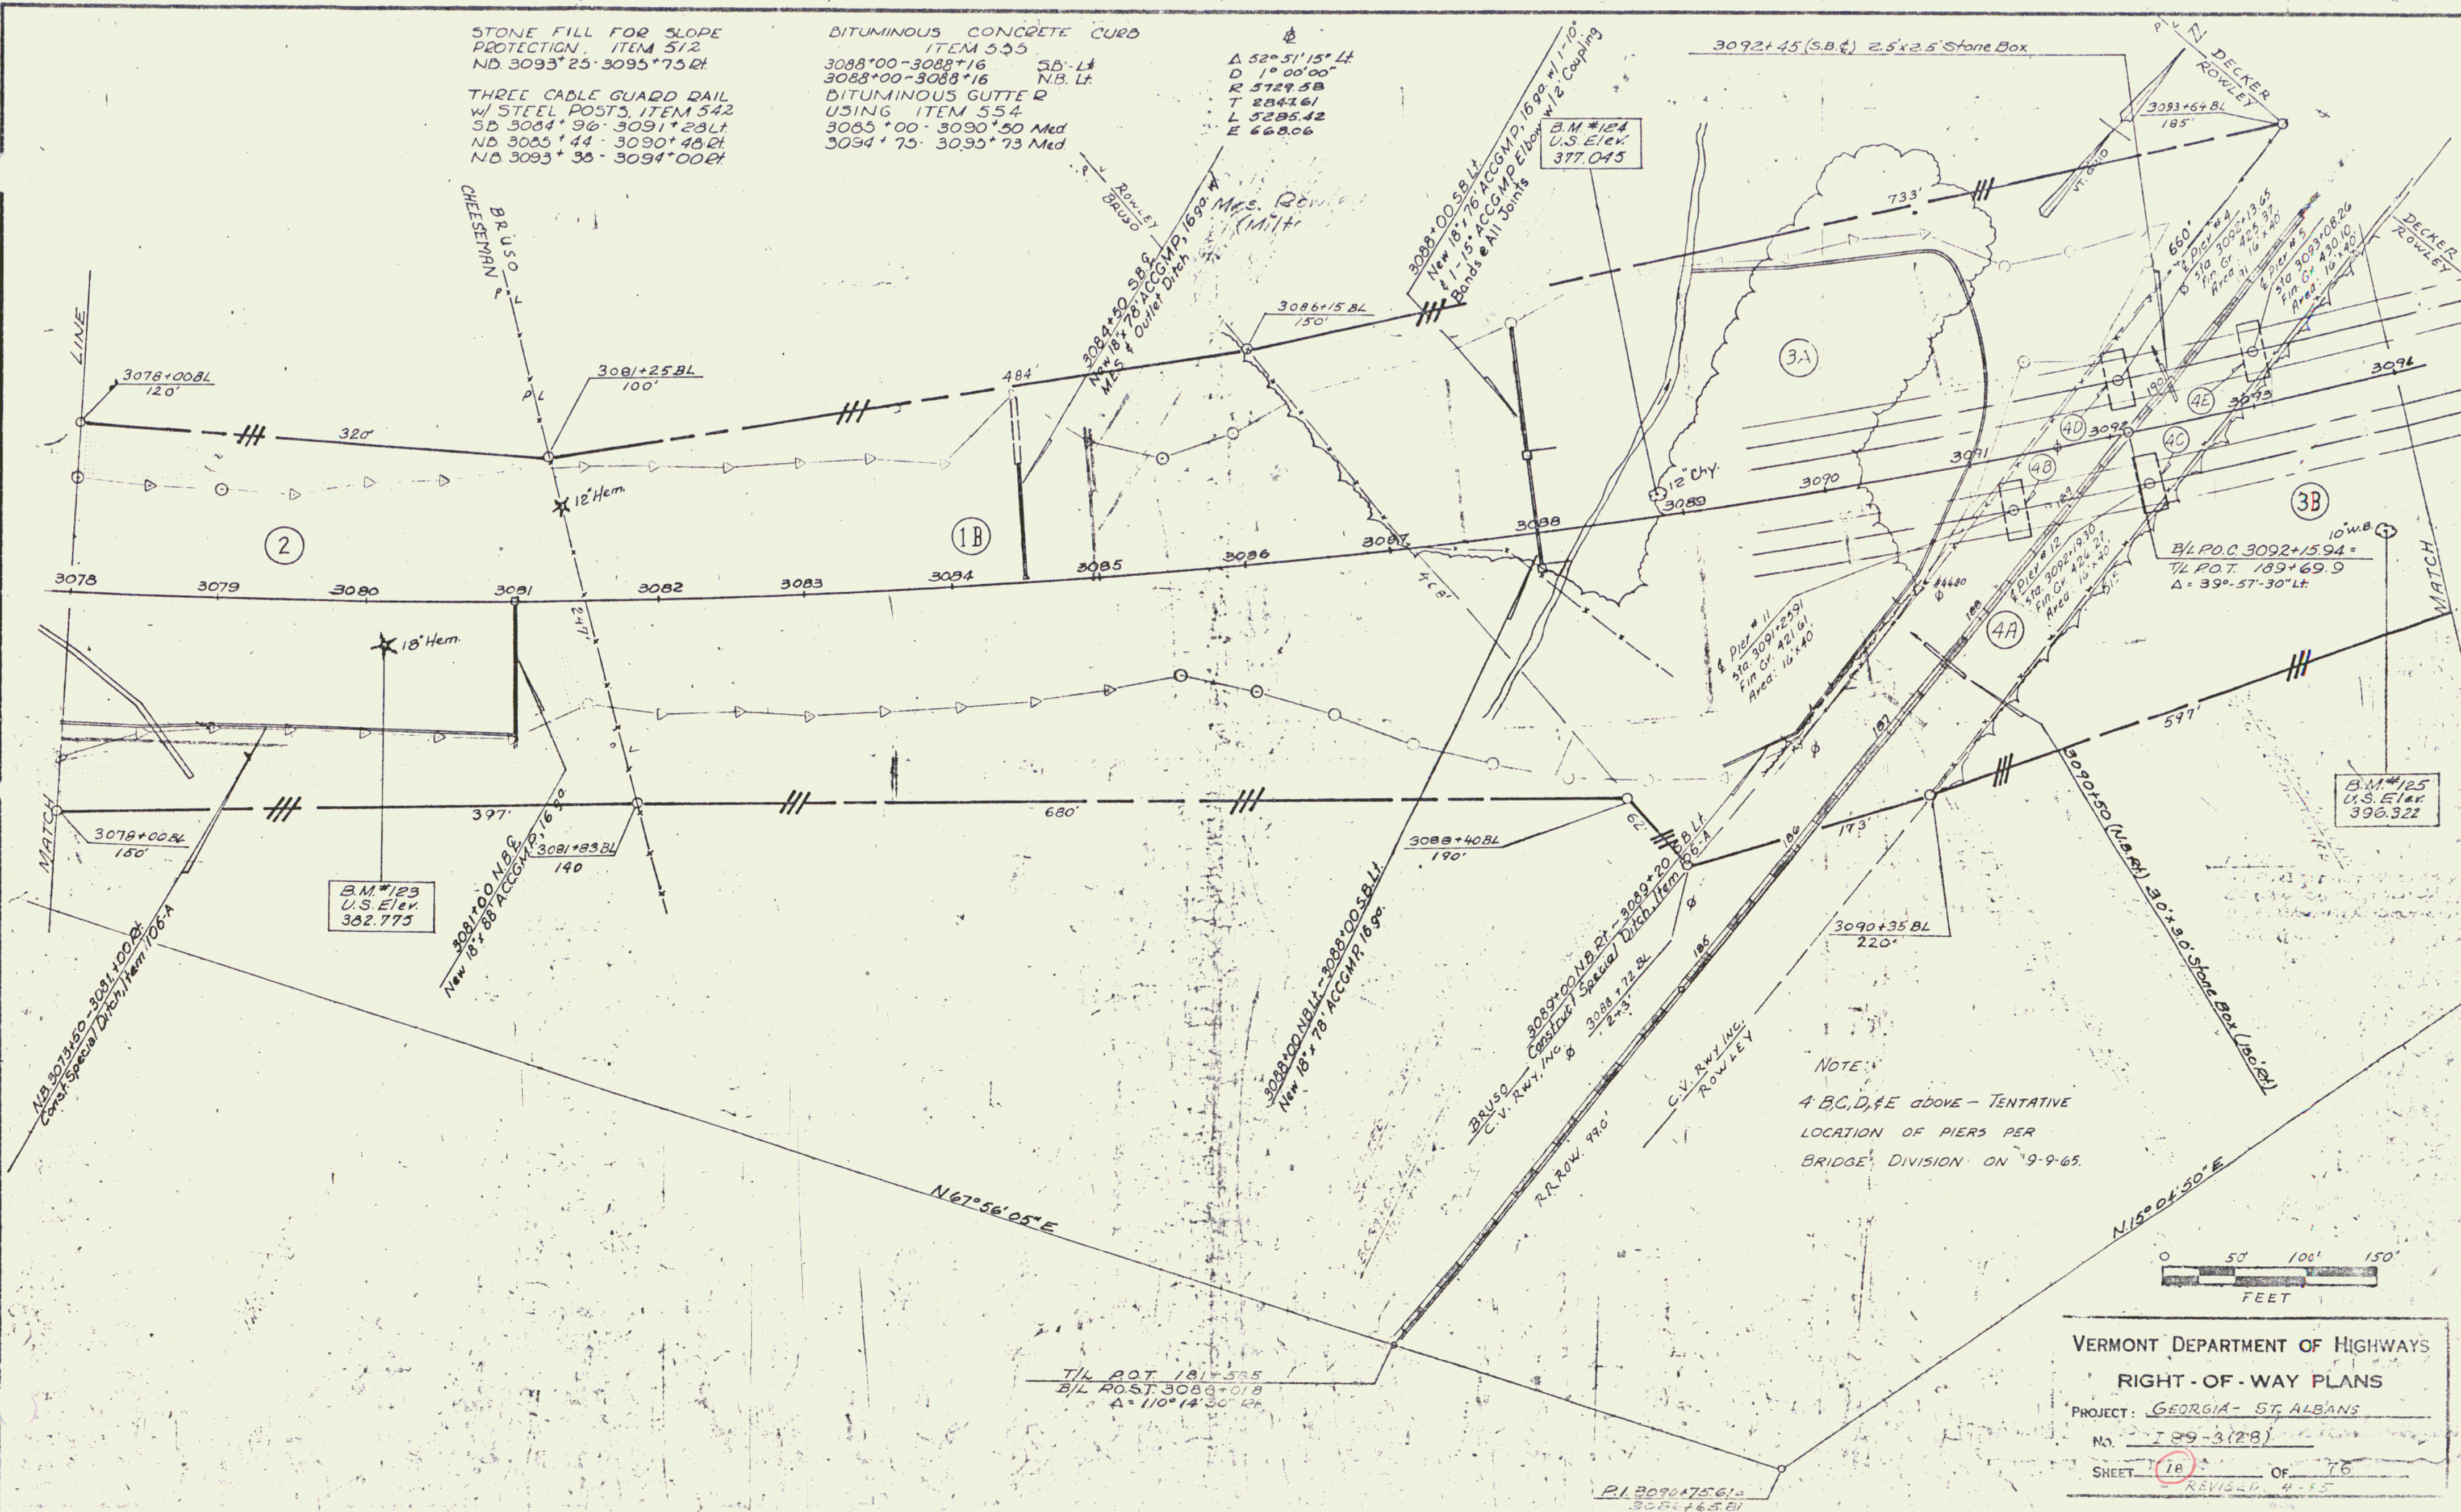

VERMONT DEPARTMENT OF HIGHWAYS
 RIGHT-OF-WAY PLANS
 PROJECT: GEORGIA - ST. ALBANS
 NO. 189-3(28)
 SHEET 18 OF 76
 REVISED 4-65