


DEMOLITION AND DISPOSAL  
OF BUILDING, ITEM 586  
3126+25 NB LT  
3127+00 NB LT  
3127+25 NB E

THREE CABLE GUARD RAIL  
W/ STEEL POSTS ITEM 542  
SB 3127+50-3141+00 LT  
  
BITUMINOUS CONCRETE  
CURB ITEM 555  
SB 3127+75-3133+80 LT

DRILLING & BLASTING OF SOLID  
ROCK SUBGRADE ITEM 115  
NB 3134+50-3141+50  
SB 3127+50-3131+00  
SB 3134+00-3138+50  
  
DRILLING & BLASTING OF  
SOLID ROCK ITEM 114  
SB 3136+00-3143+00

BITUMINOUS GUTTER  
USING ITEM 554  
SB 3125+75-3126+94 LT  
SB 3131+65-3134+32 LT  
SB 3138+43-3142+16 LT  
NB 3140+75-3142+50 LT

VERMONT DEPARTMENT OF HIGHWAYS  
RIGHT-OF-WAY PLANS  
PROJECT: GEORGINA-ST ALBANS  
No. 789-3(28)  
SHEET 21 OF 76  
REVISED 4-65

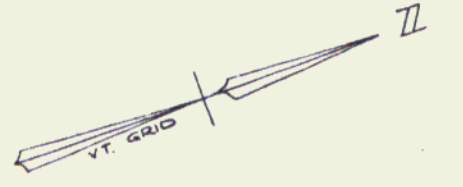

DATE: 12/62  
BY: Spaulding  
Checked: 1/63  
ENCL: 2/63  
PLAN: SURVEYED, FACILITIES, CHECKED, AS SHOWN, CHECKED, TRACED

