


PLAN
 DATE
 DRAWN BY
 CHECKED BY
 APPROVED BY
 NO.

DITUMINOUS CONCRETE CURB
 ITEM 555
 SB 3204+00-3205+25 LF

THREE CABLE GUARD RAIL W/ STEEL POSTS ITEM 543
 SB 3204+00-3205+25 LF

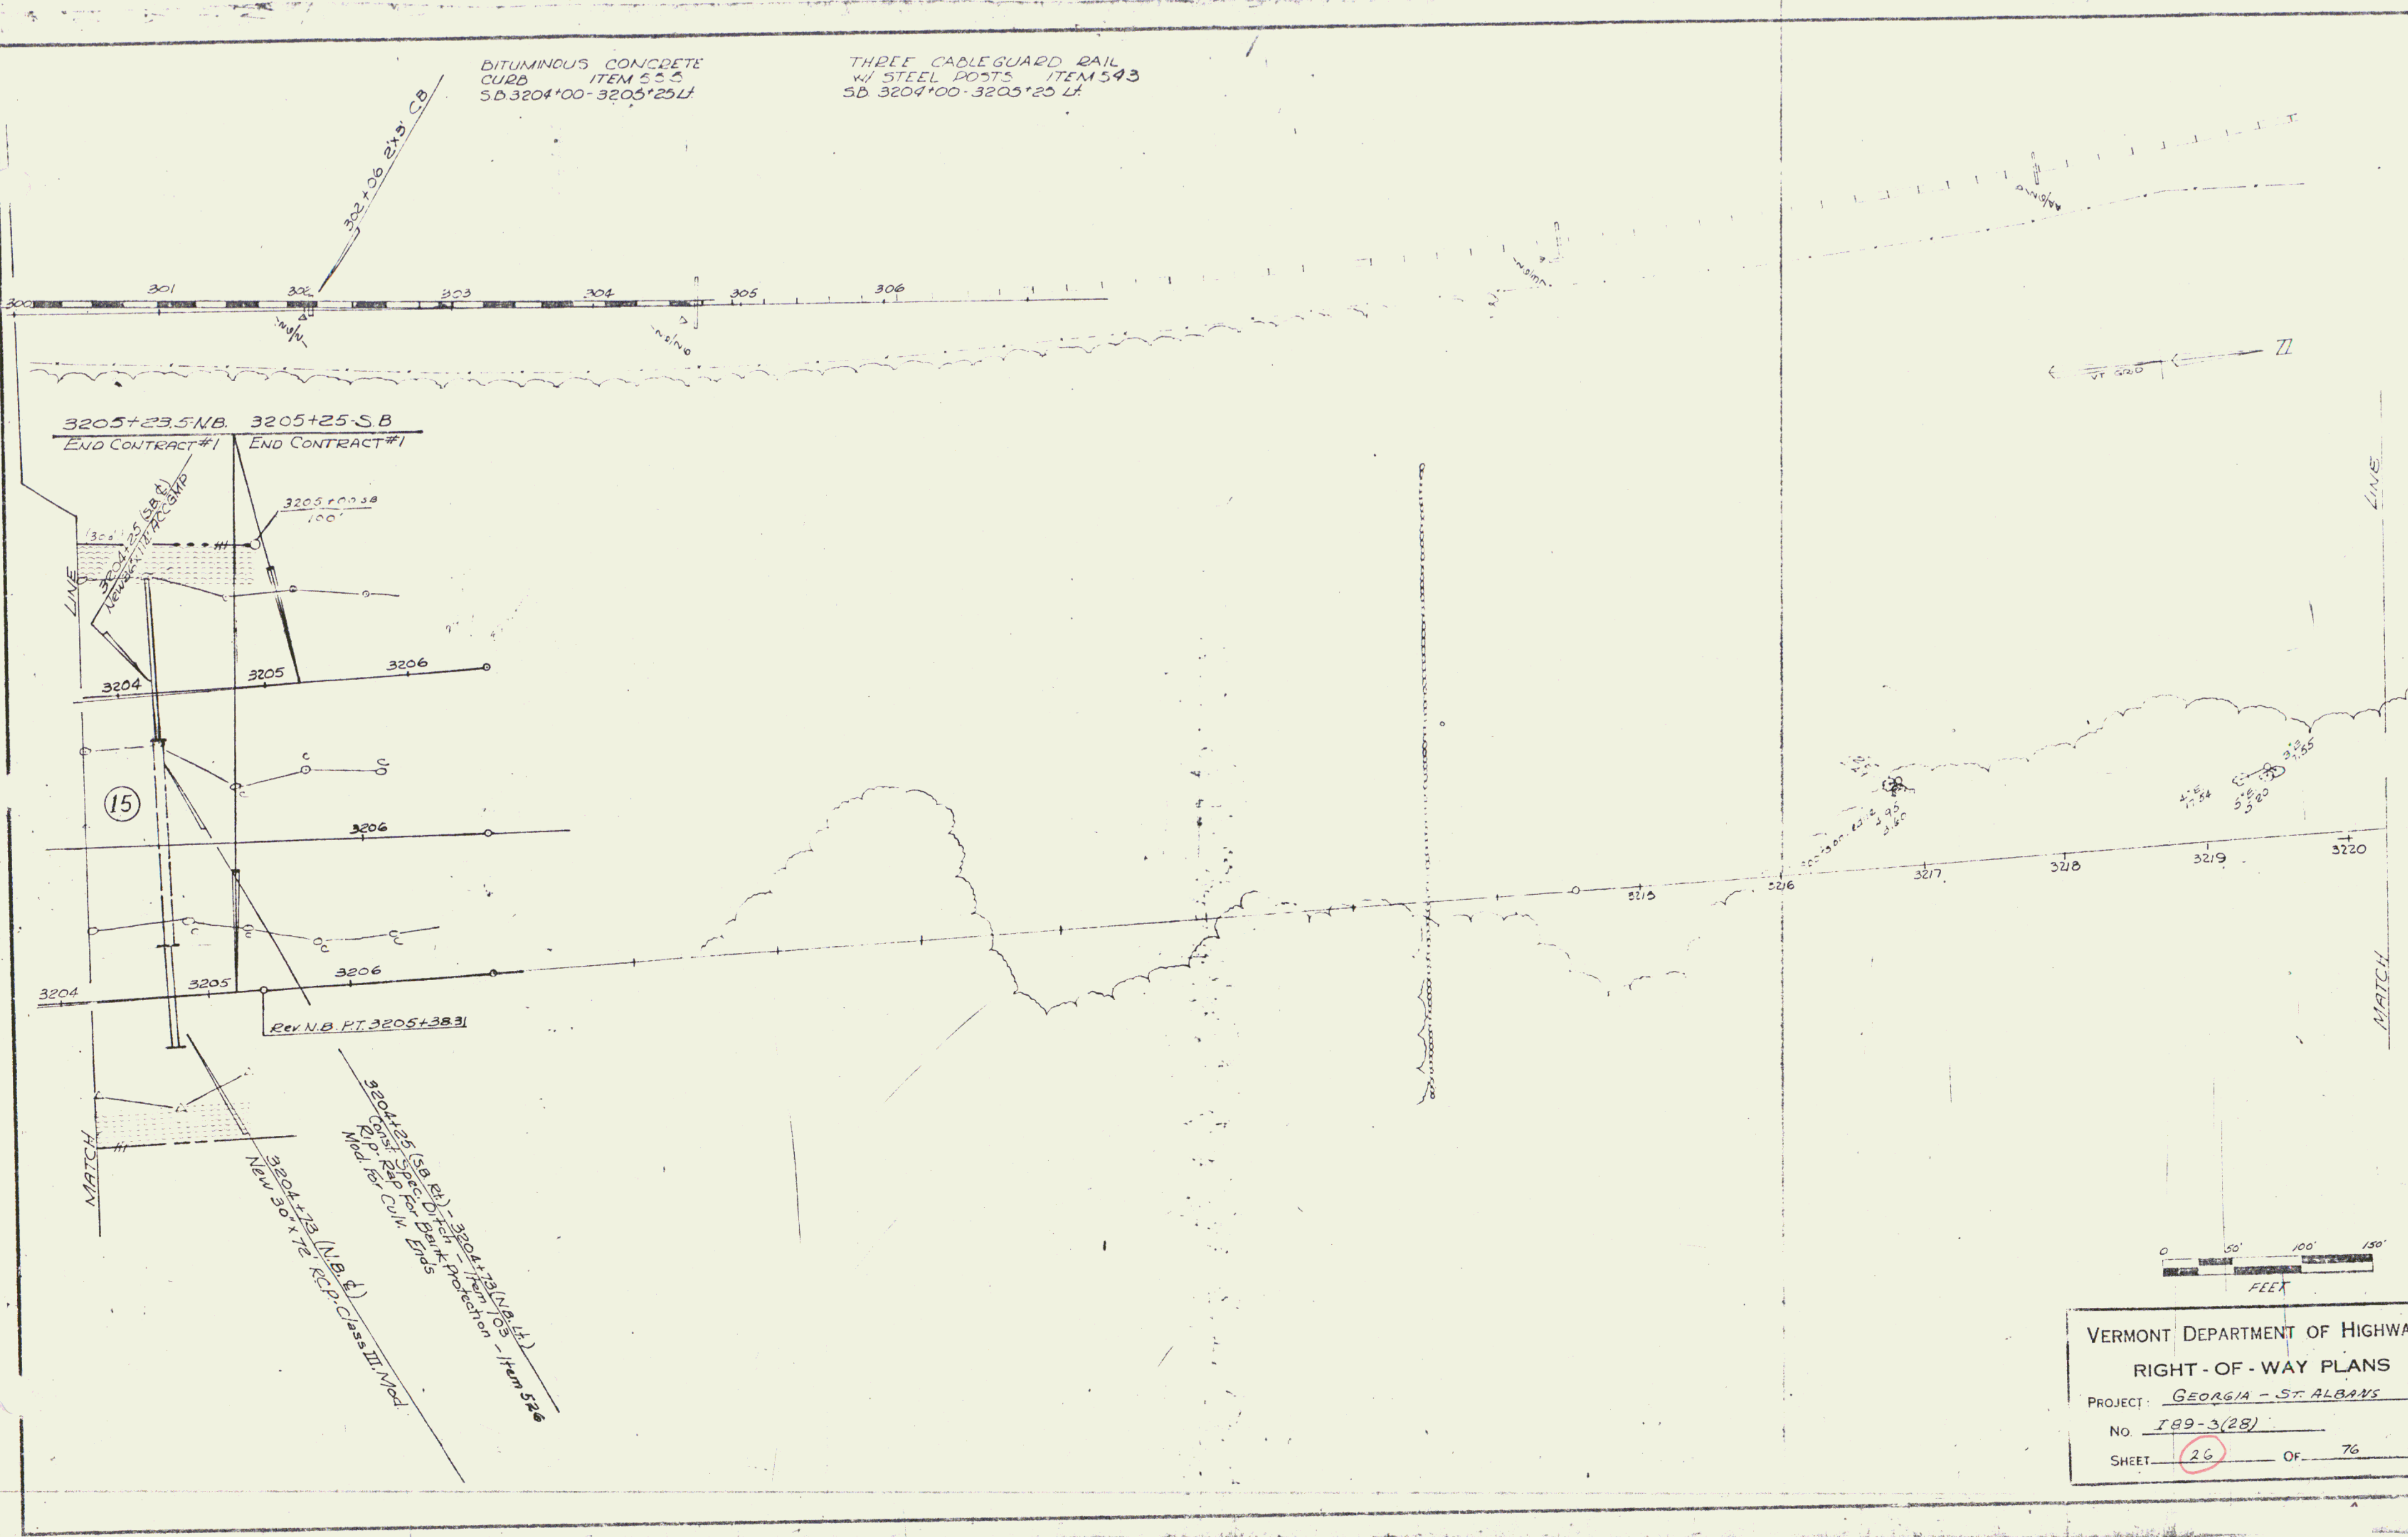

VERMONT DEPARTMENT OF HIGHWAYS
 RIGHT-OF-WAY PLANS
 PROJECT: GEORGIA - ST. ALBANS
 No. 189-3(28)
 SHEET 26 OF 76