


DATE: 12/13/83
 BY: [Signature]
 CHECKED: [Signature]
 PLAN: 3/15/84
 NOTE BOOK: [Number]
 NO. [Number]
 DRAWING: [Number]

DRILLING & BLASTING OF SOLID
 ROCK SUBGRADE ITEM
 NB 3115+50-3220+00
 SB 3209+00-3210+50
 SB 3217+50-3220+00

THREE CABLE GUARD RAIL
 W/STEEL POSTS, ITEM
 NB 3215+00-3218+52 LT
 SB 3205+25-3220+00 LT

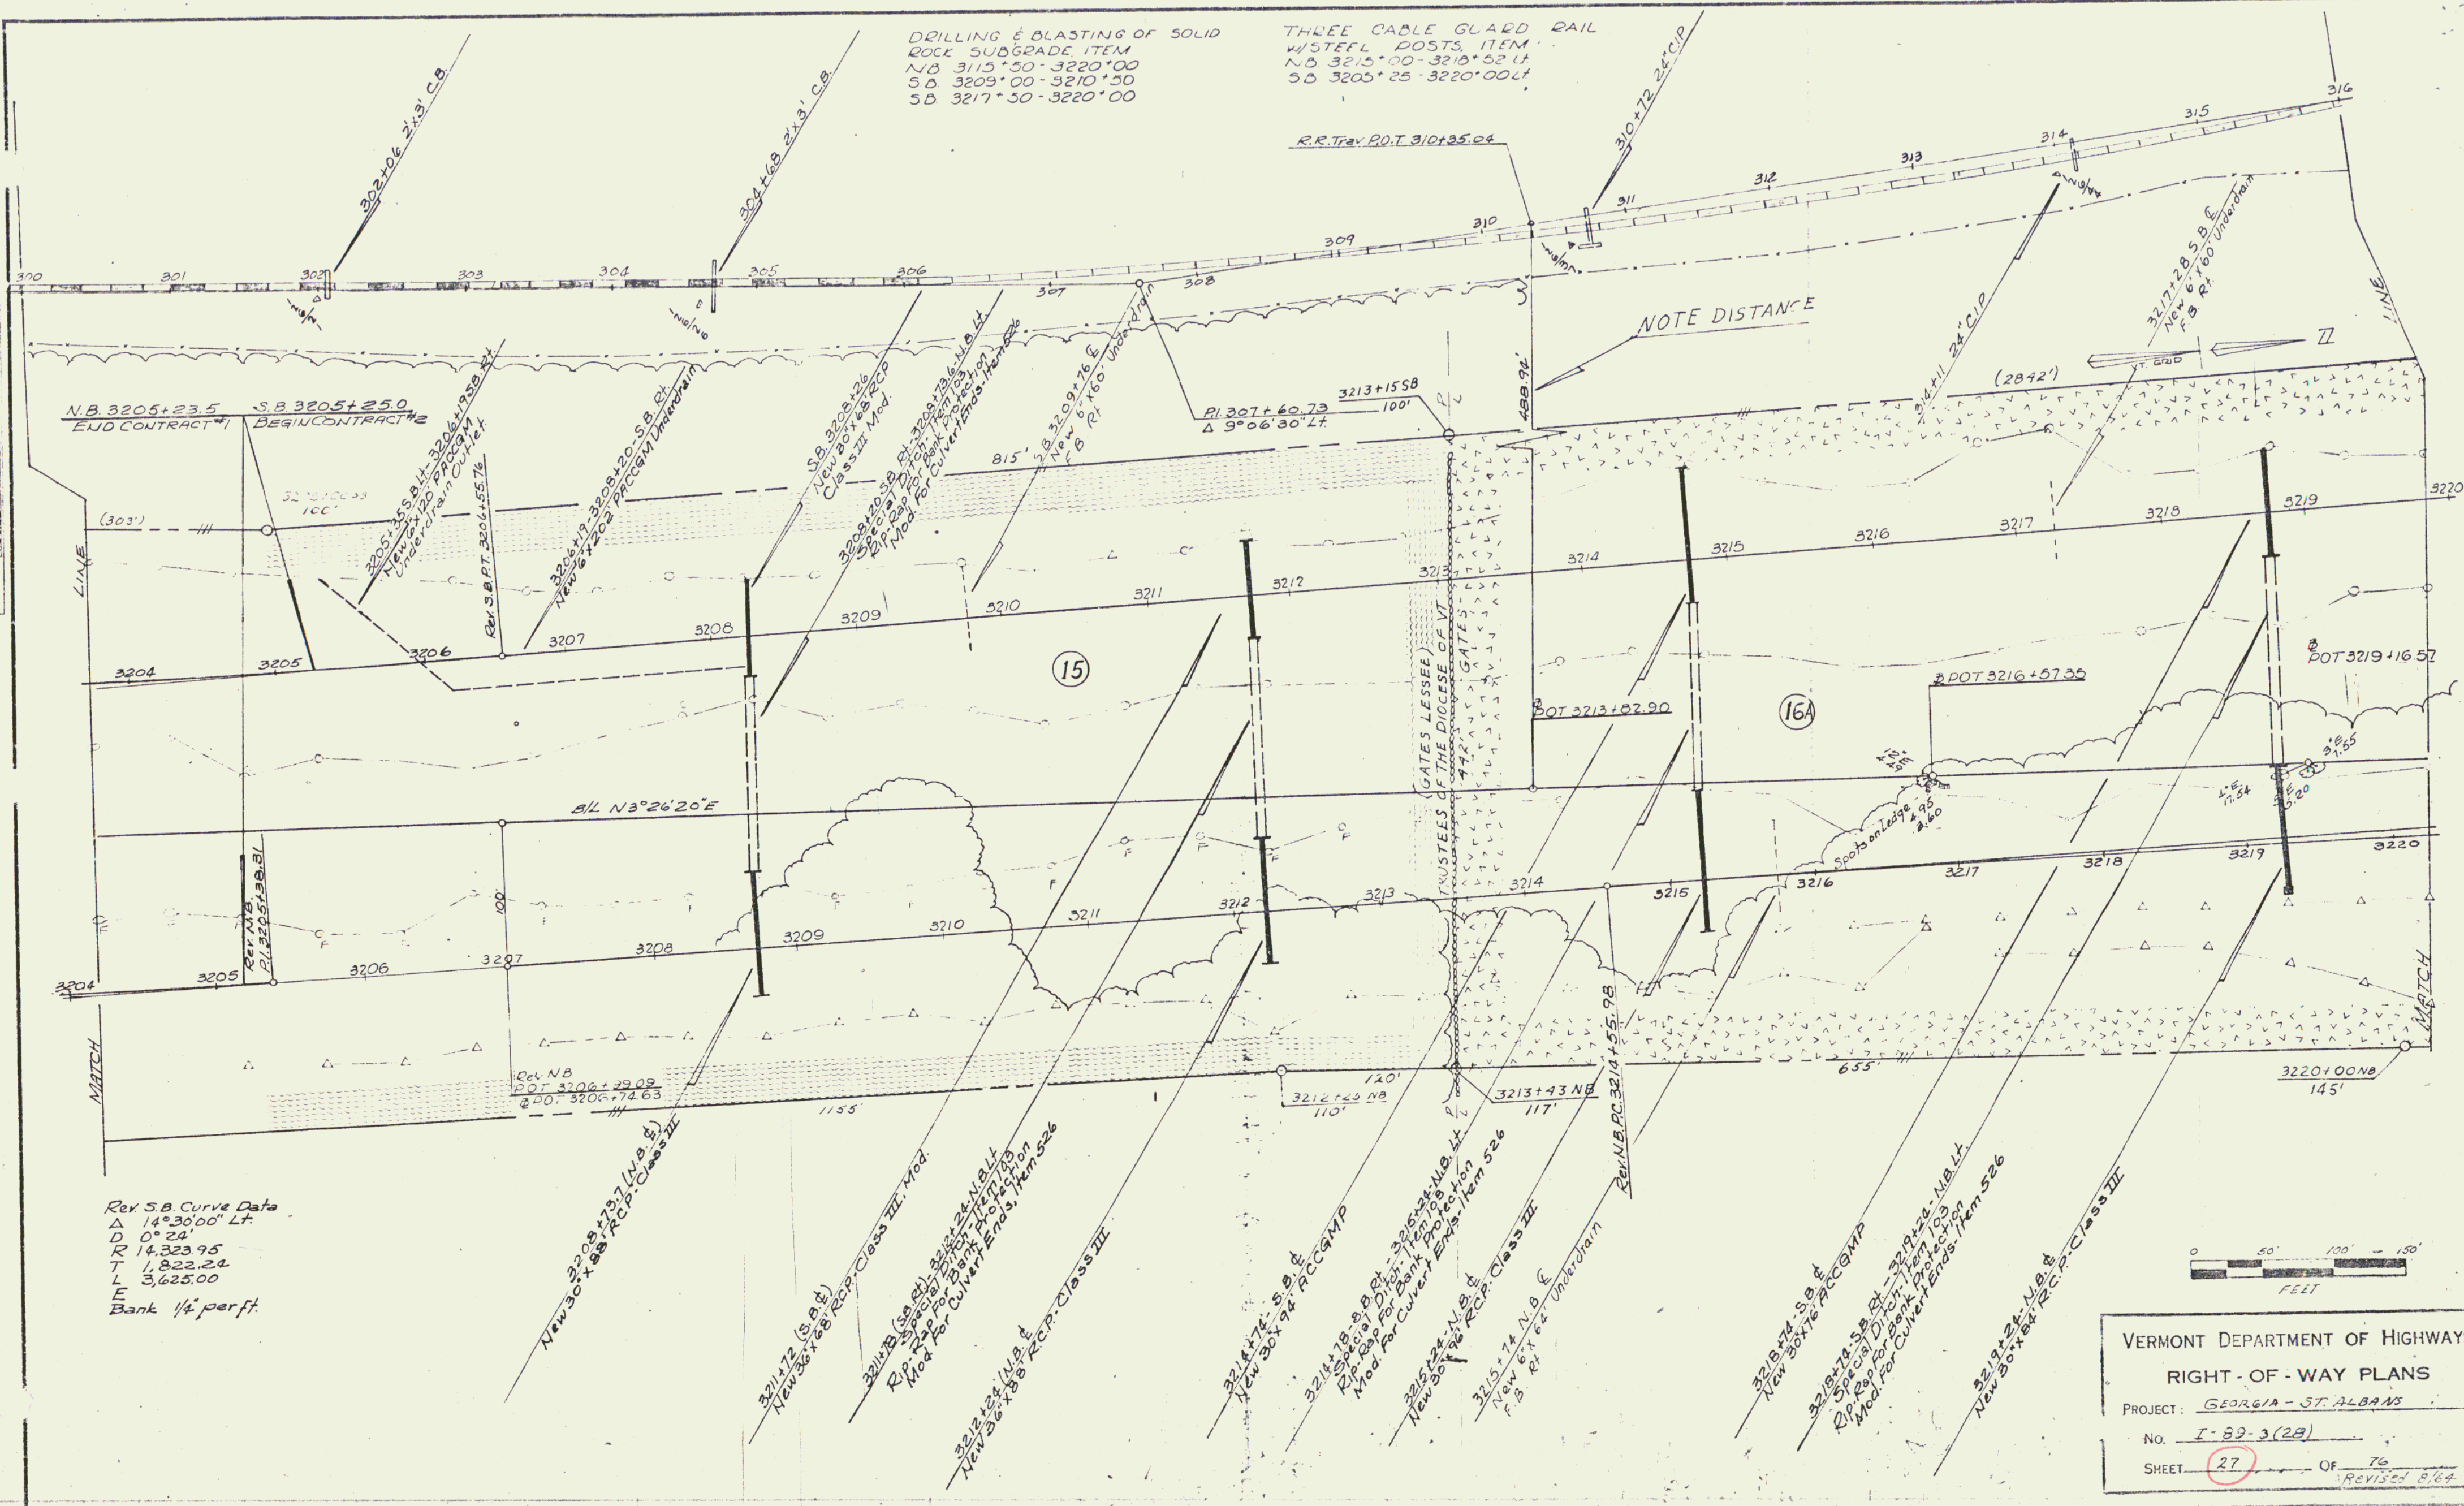

Rev. S.B. Curve Data
 Δ 14°30'00" Lt.
 D 0°24'
 R 14,323.95
 T 1,822.24
 L 3,625.00
 E
 Bank 1/4 per ft.



VERMONT DEPARTMENT OF HIGHWAYS
 RIGHT-OF-WAY PLANS
 PROJECT: GEORGIA - ST. ALBANS
 No. I-89-3(28)
 SHEET 27 OF 76
 Revised 8/64