

DATE CHECKED
 NO. CHECKED
 NO. CHECKED
 NO. CHECKED


STD STEEL BEAM GUARD RAIL
 W/ STEEL POSTS, ITEM 541-A
 NB 3243+60-3244+19LT
 NB 3243+70-3244+39RT
 SB 3242+36-3242+90LT
 SB 3242+56-3243+10RT

THREE CABLE GUARD RAIL
 W/ STEEL POSTS, ITEM 543
 NB 3250+50-3252+00RT

STONE FILL FOR SLOPE
 PROTECTION, ITEM 526
 SB 3242+68-3242+80RT
 SB 3242+88-3243+08RT

DRILLING & BLASTING OF SOLID
 ROCK SUBGRADE, ITEM 117
 SB 3236+00-3241+00

RIPRAP FOR BANK PROTECTION
 MOD FOR CULVERT ENDS, ITEM 526
 SB 3242+80-3242+88RT

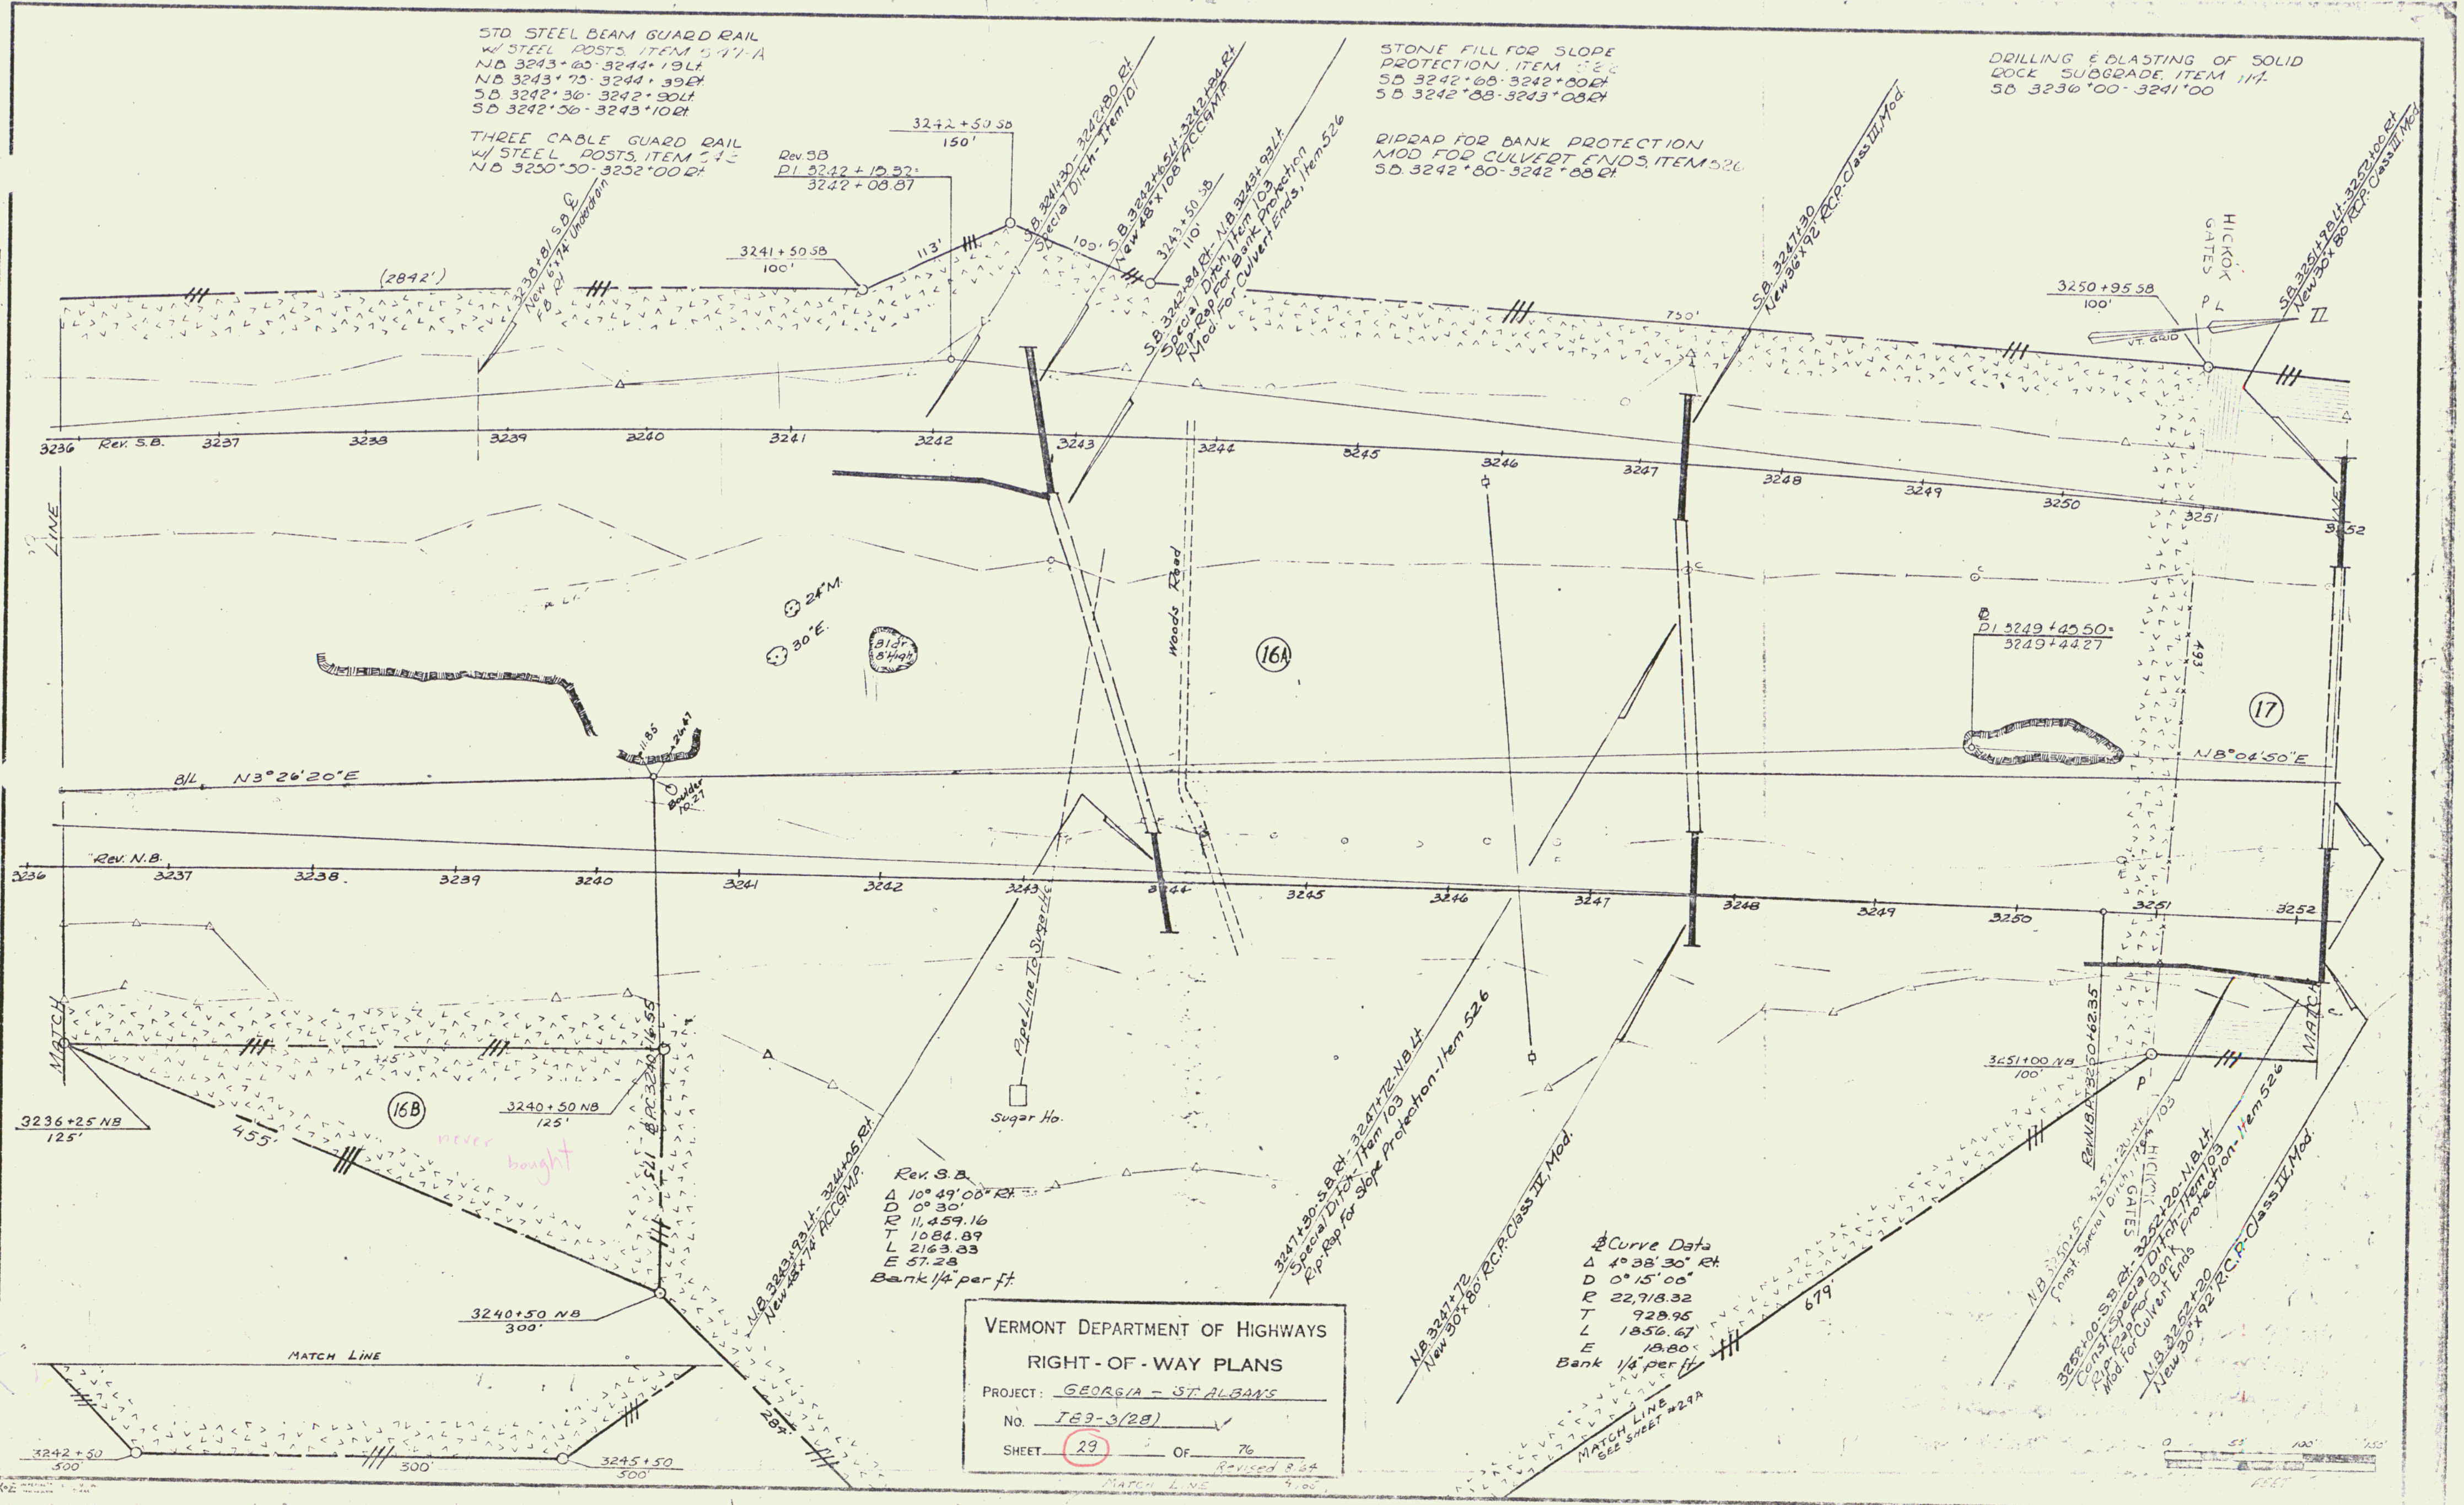

VERMONT DEPARTMENT OF HIGHWAYS
 RIGHT-OF-WAY PLANS
 PROJECT: GEORGIA - ST. ALBANS
 No. 163-3(28)
 SHEET 29 OF 76
 Revised 8-24
 9-00

Curve Data
 Δ 10°38'30" RT
 D 0°15'00"
 R 22,718.32
 T 928.95
 L 1856.67
 E 18.80
 Bank 1/4" per ft.