

B/L A 3° 26' 20" E





3236 Rev. NB. 3237 3238 3239 3240 3241 3242 3243 3244 3245 3246 3247 3248 3249 3250 3251 3252 3253 3254 3255 3256 3257 3258 3259 3260

Rev. NB  
Δ 6° 00' 38" R  
D 0' 10" 00  
R 34,317.48  
T 180° 94'  
L 3601.37  
E 213.7  
R 11.2

Sugar no.

(16A)

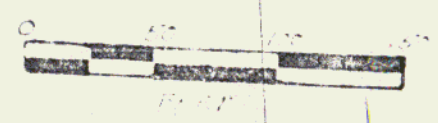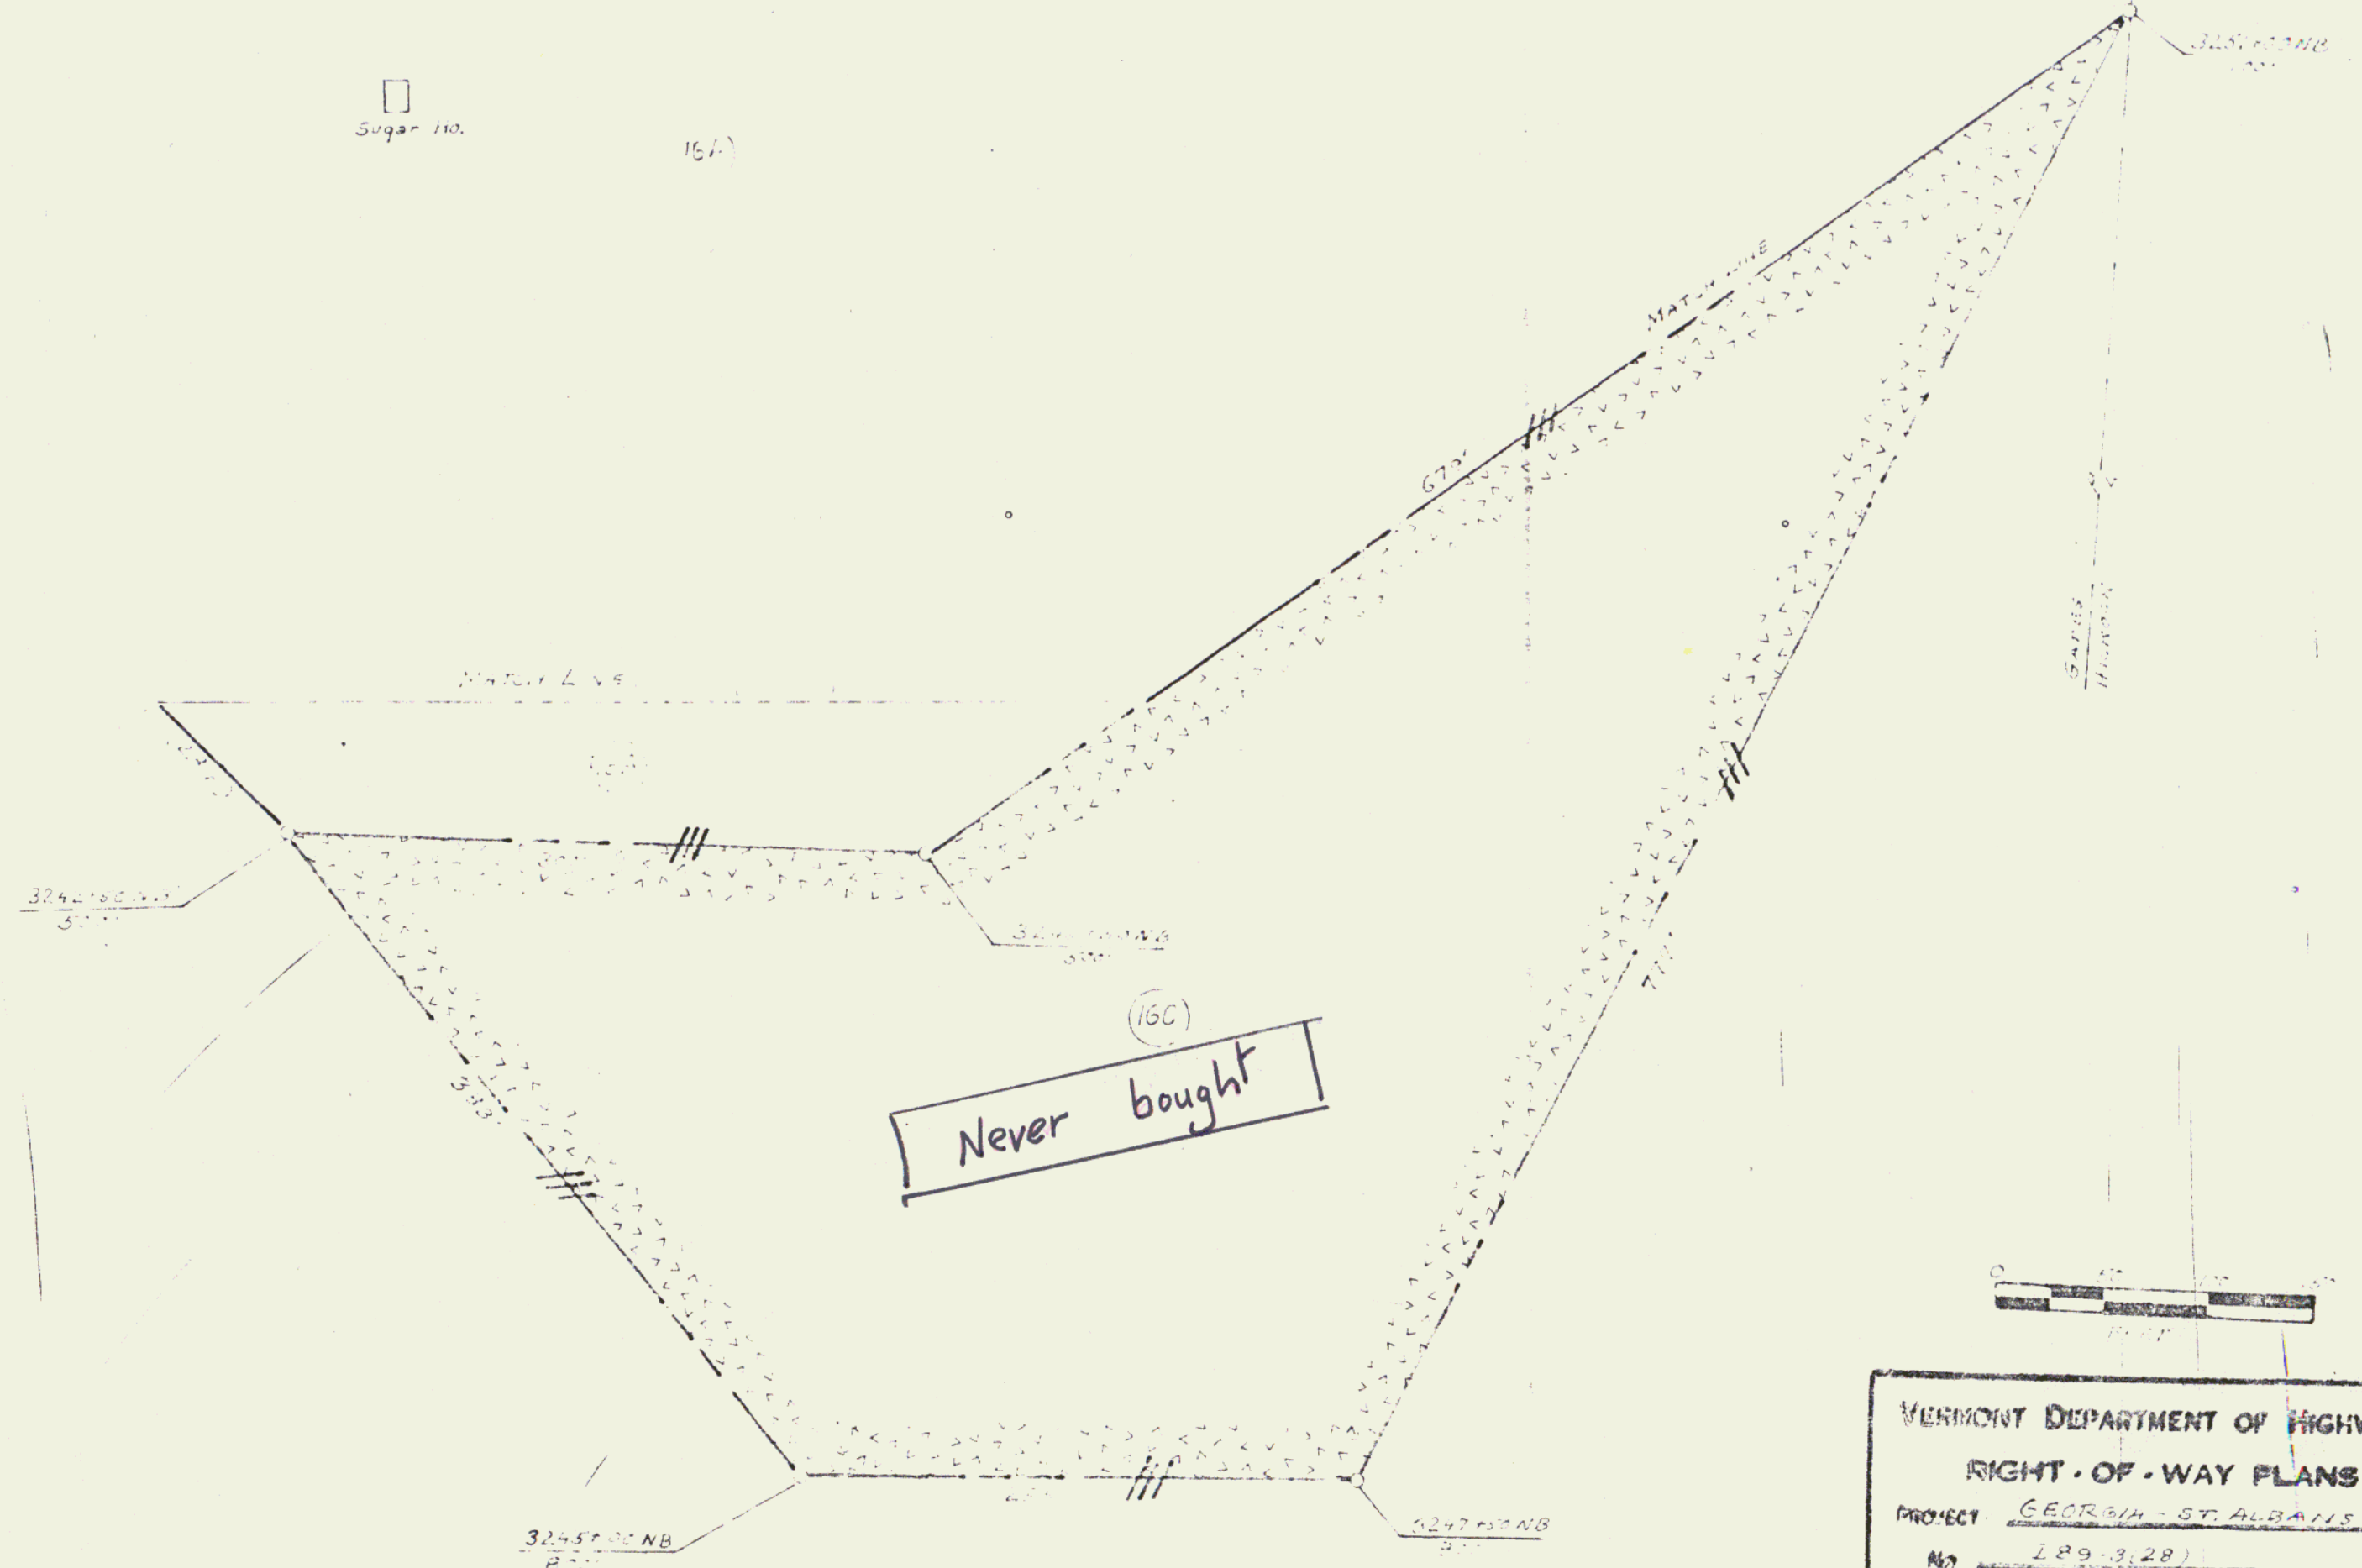

VERMONT DEPARTMENT OF HIGHWAYS  
RIGHT-OF-WAY PLANS  
PROJECT GEORGIN - ST. ALBANS  
No. LB9-3,281  
SHEET 29A OF 76  
7-65