


PLAN
 SUBMITTED BY: Consulting
 DATE: 2/72
 NOTE BOOK: ALUMINUM CHECKED
 NO. 2105
 REVISIONS: EWEL

THREE CABLE GUARD RAIL
 W/ STEEL POSTS, ITEM 42
 NB. 3252*00-3262*50 RT

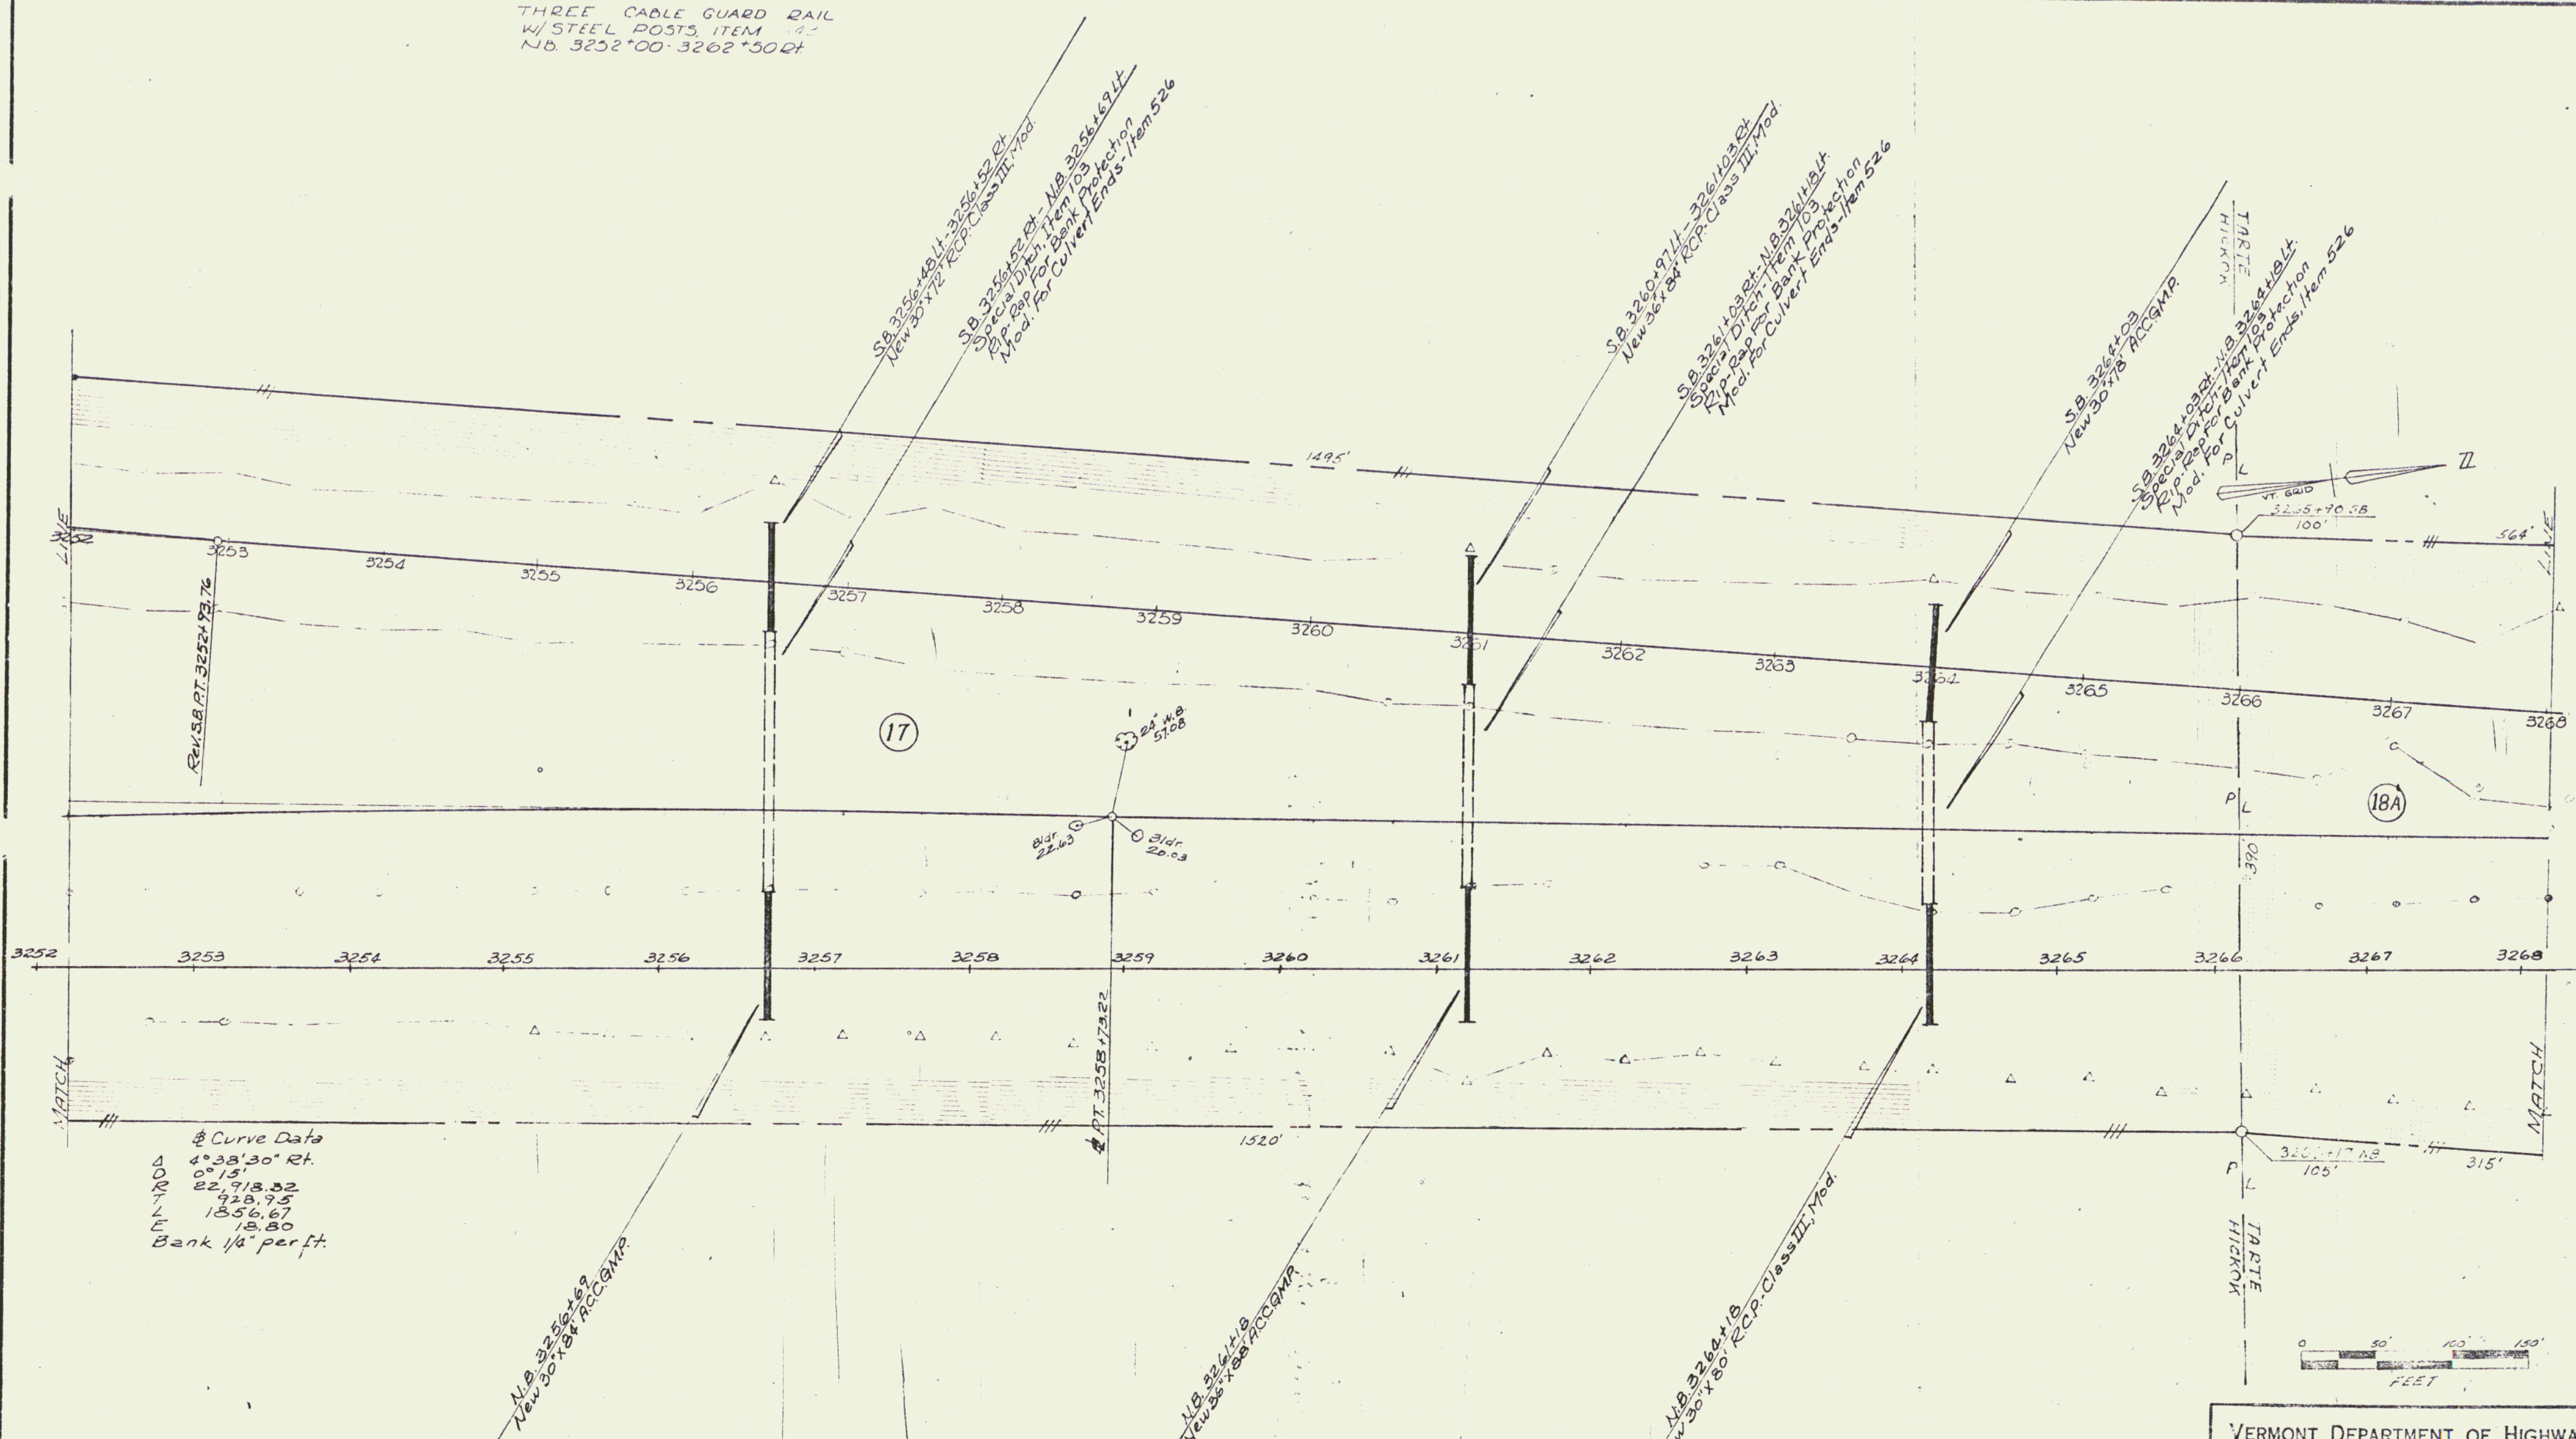

VERMONT DEPARTMENT OF HIGHWAYS
 • RIGHT - OF - WAY PLANS
 PROJECT: GEORGIA - ST. ALBANS
 No. 189-3(28)
 SHEET 30 OF 79